PARENT PARCEL: 09-00-097-000-024, -026
CHILD PARCEL: 09-00-097-000-096
STARTING POINT: INTERSECTION OF C/L OF PARSONS RD. AND WEST LINE OF O.L.97

21-04276

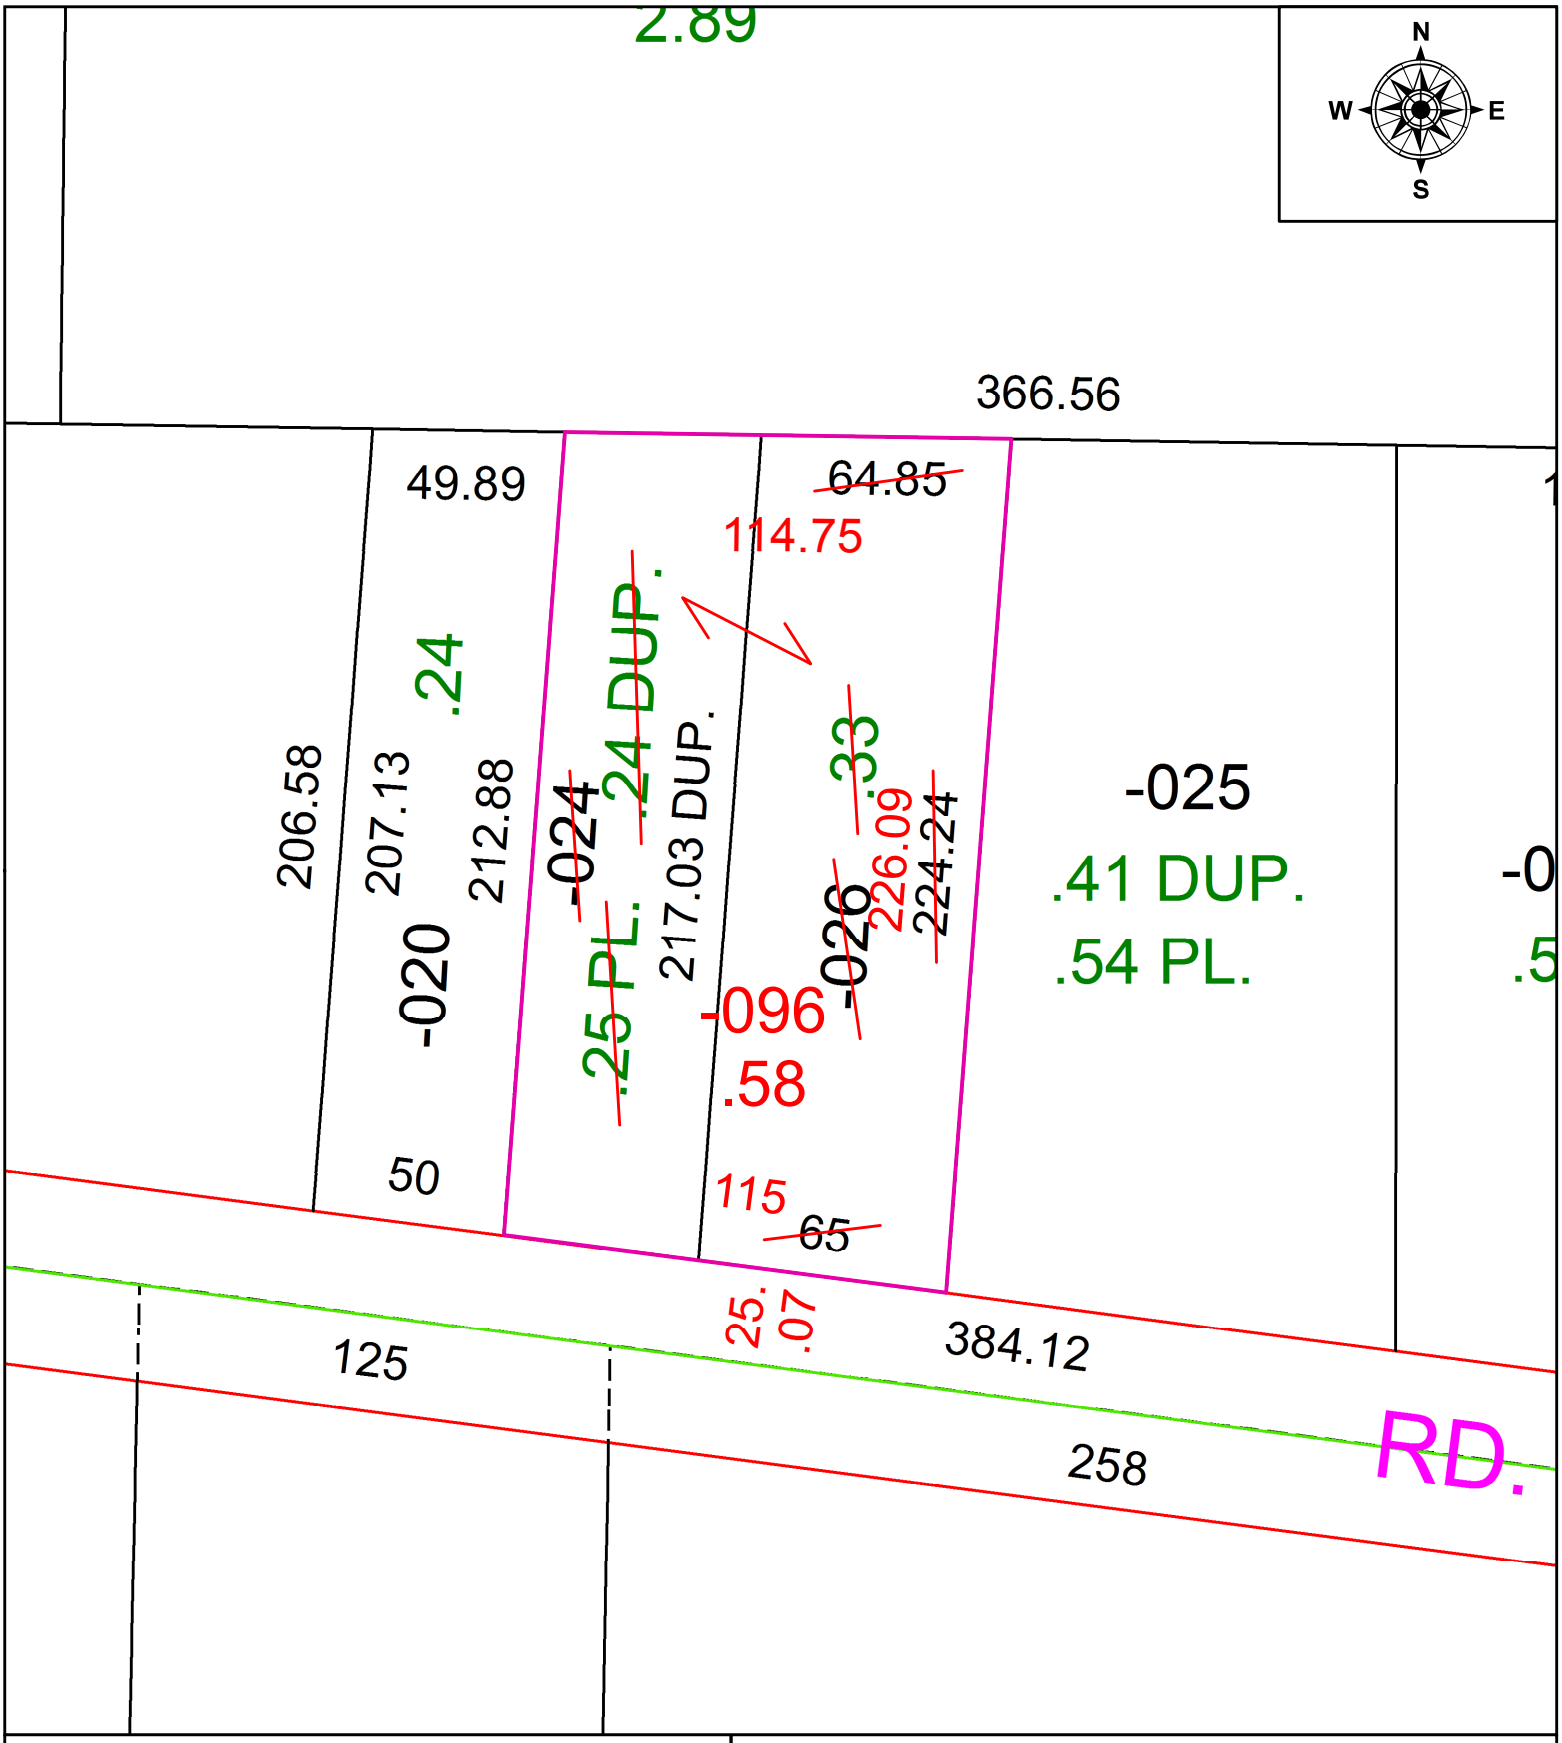

SPLITS/DEEDS PROCESSED
LORAIN COUNTY TAX MAP DEPARTMENT
226 MIDDLE AVE. ELYRIA, OH

SURVEYED BY: WILFREDO BARBOSA
CLOSURE: 1:102,814
MAP PAGE(S): 9-00-097
APPOVED BY: RRM **DATE:** 3-29-21
SCALE: 1" = 50 **PRIOR INSTRUMENT:** 20070219500