PARENT PARCEL: 05-00-051-000-029, -039

CHILD PARCEL: 05-00-051-000-041

STARTING POINT: INTERSECTION OF C/L OF OBERLIN RD. AND NORTH LINE OF O.L.51

21-04277

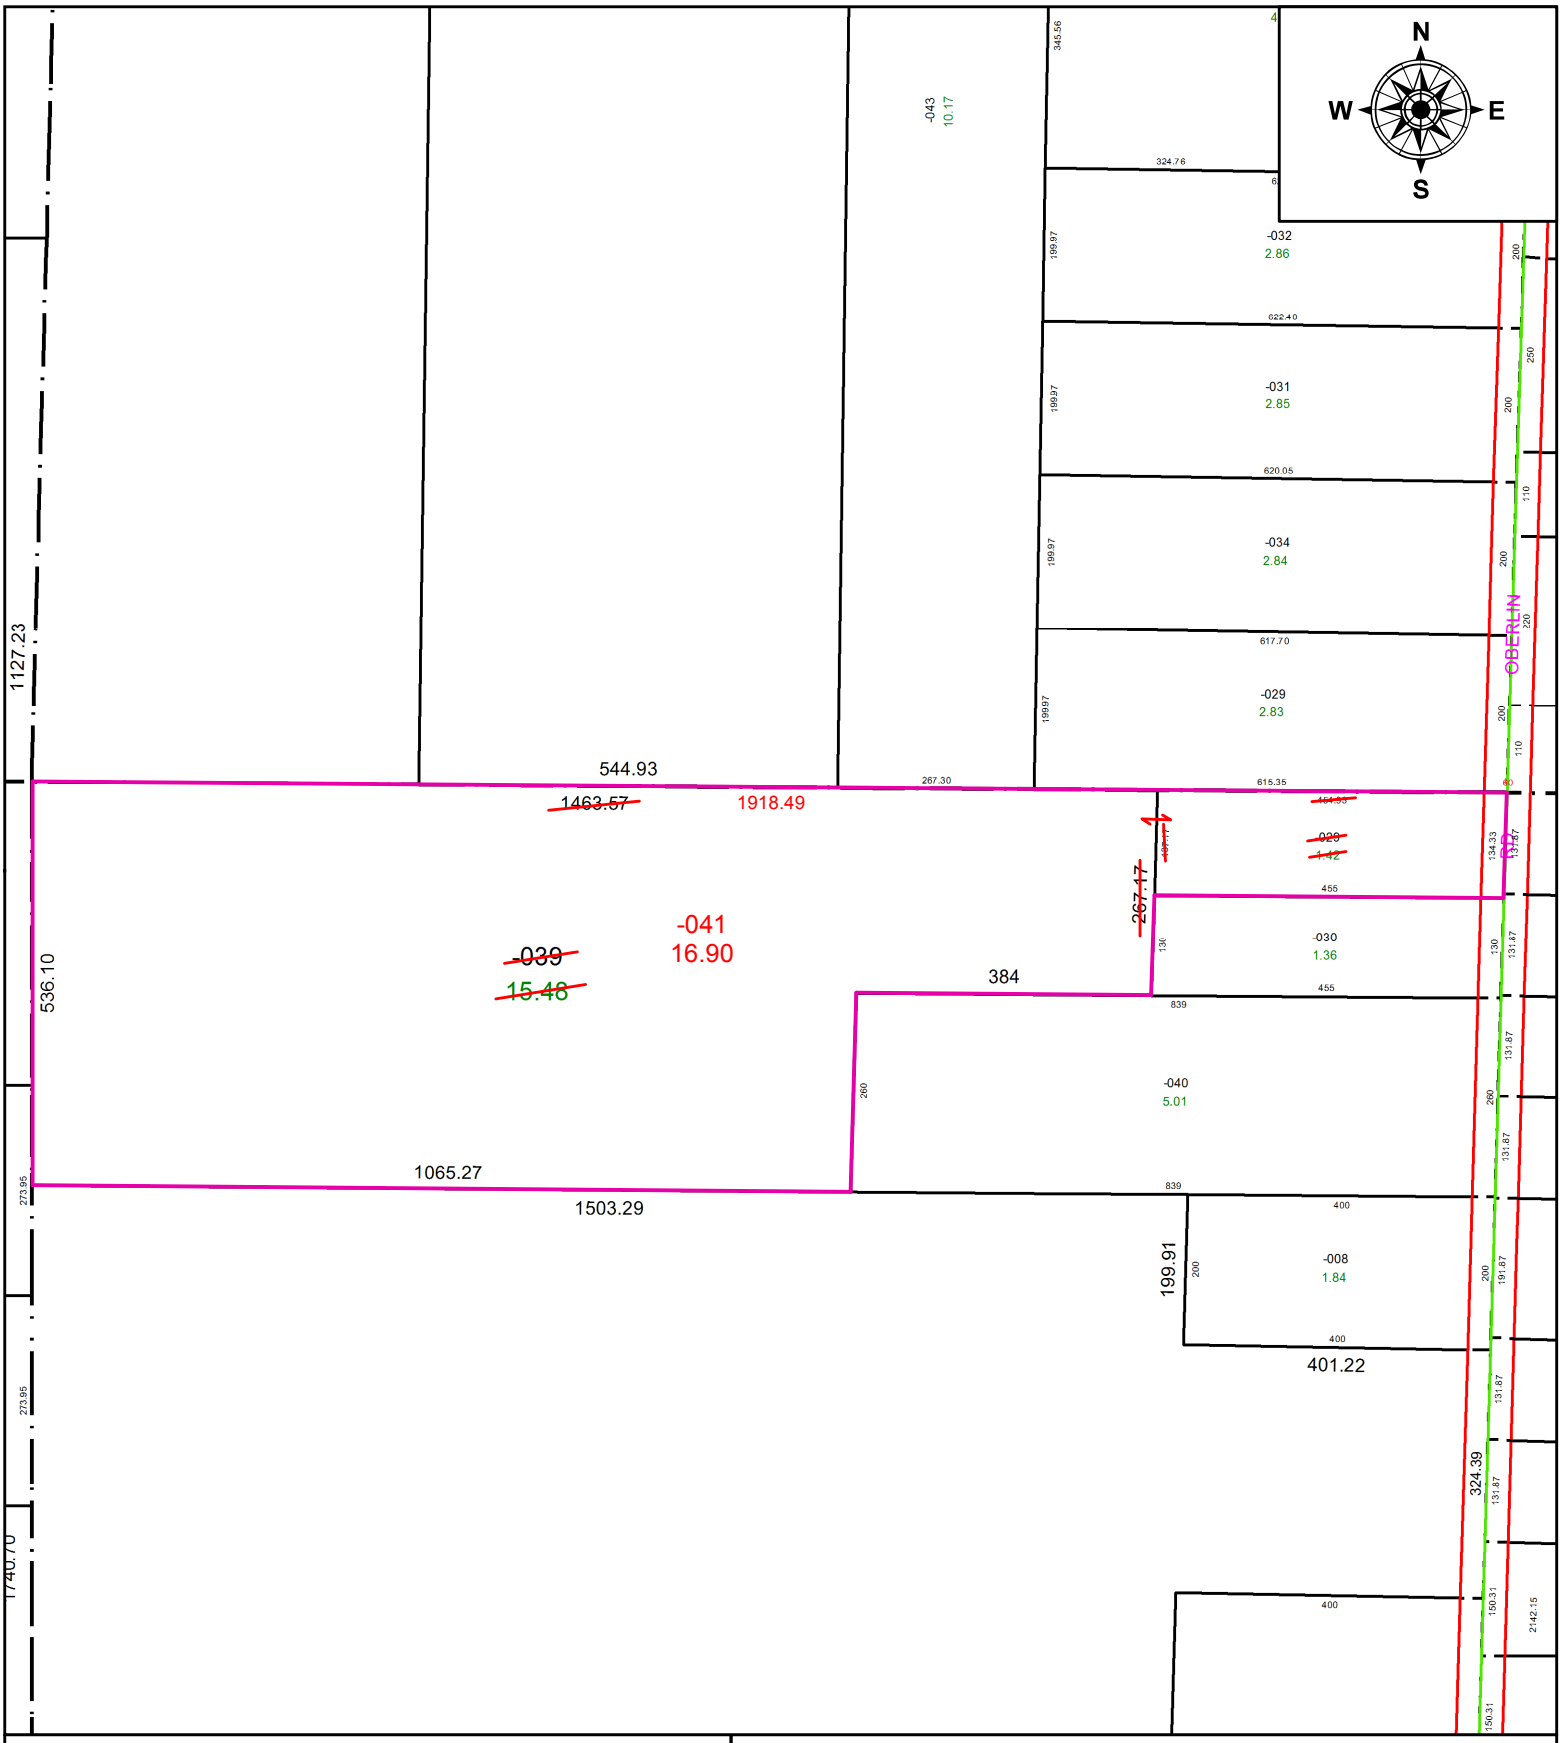

SPLITS/DEEDS PROCESSED

LORAIN COUNTY TAX MAP DEPARTMENT
226 MIDDLE AVE. ELYRIA, OH

SURVEYED BY: THOMAS A. SIMON
CLOSURE: 1: 771,681
MAP PAGE(S): 5-00-051
APPOVED BY: RRM **DATE:** 3-29-21
SCALE: 1" = 250 **PRIOR INSTRUMENT:** 20190736045