PARENT PARCEL: 04-00-019-114-029

CHILD PARCEL:

STARTING POINT: NORTHEAST CORNER OF LAND CONVEYED TO FRANK J. HOGE (DV 312/316)

20-04278-A

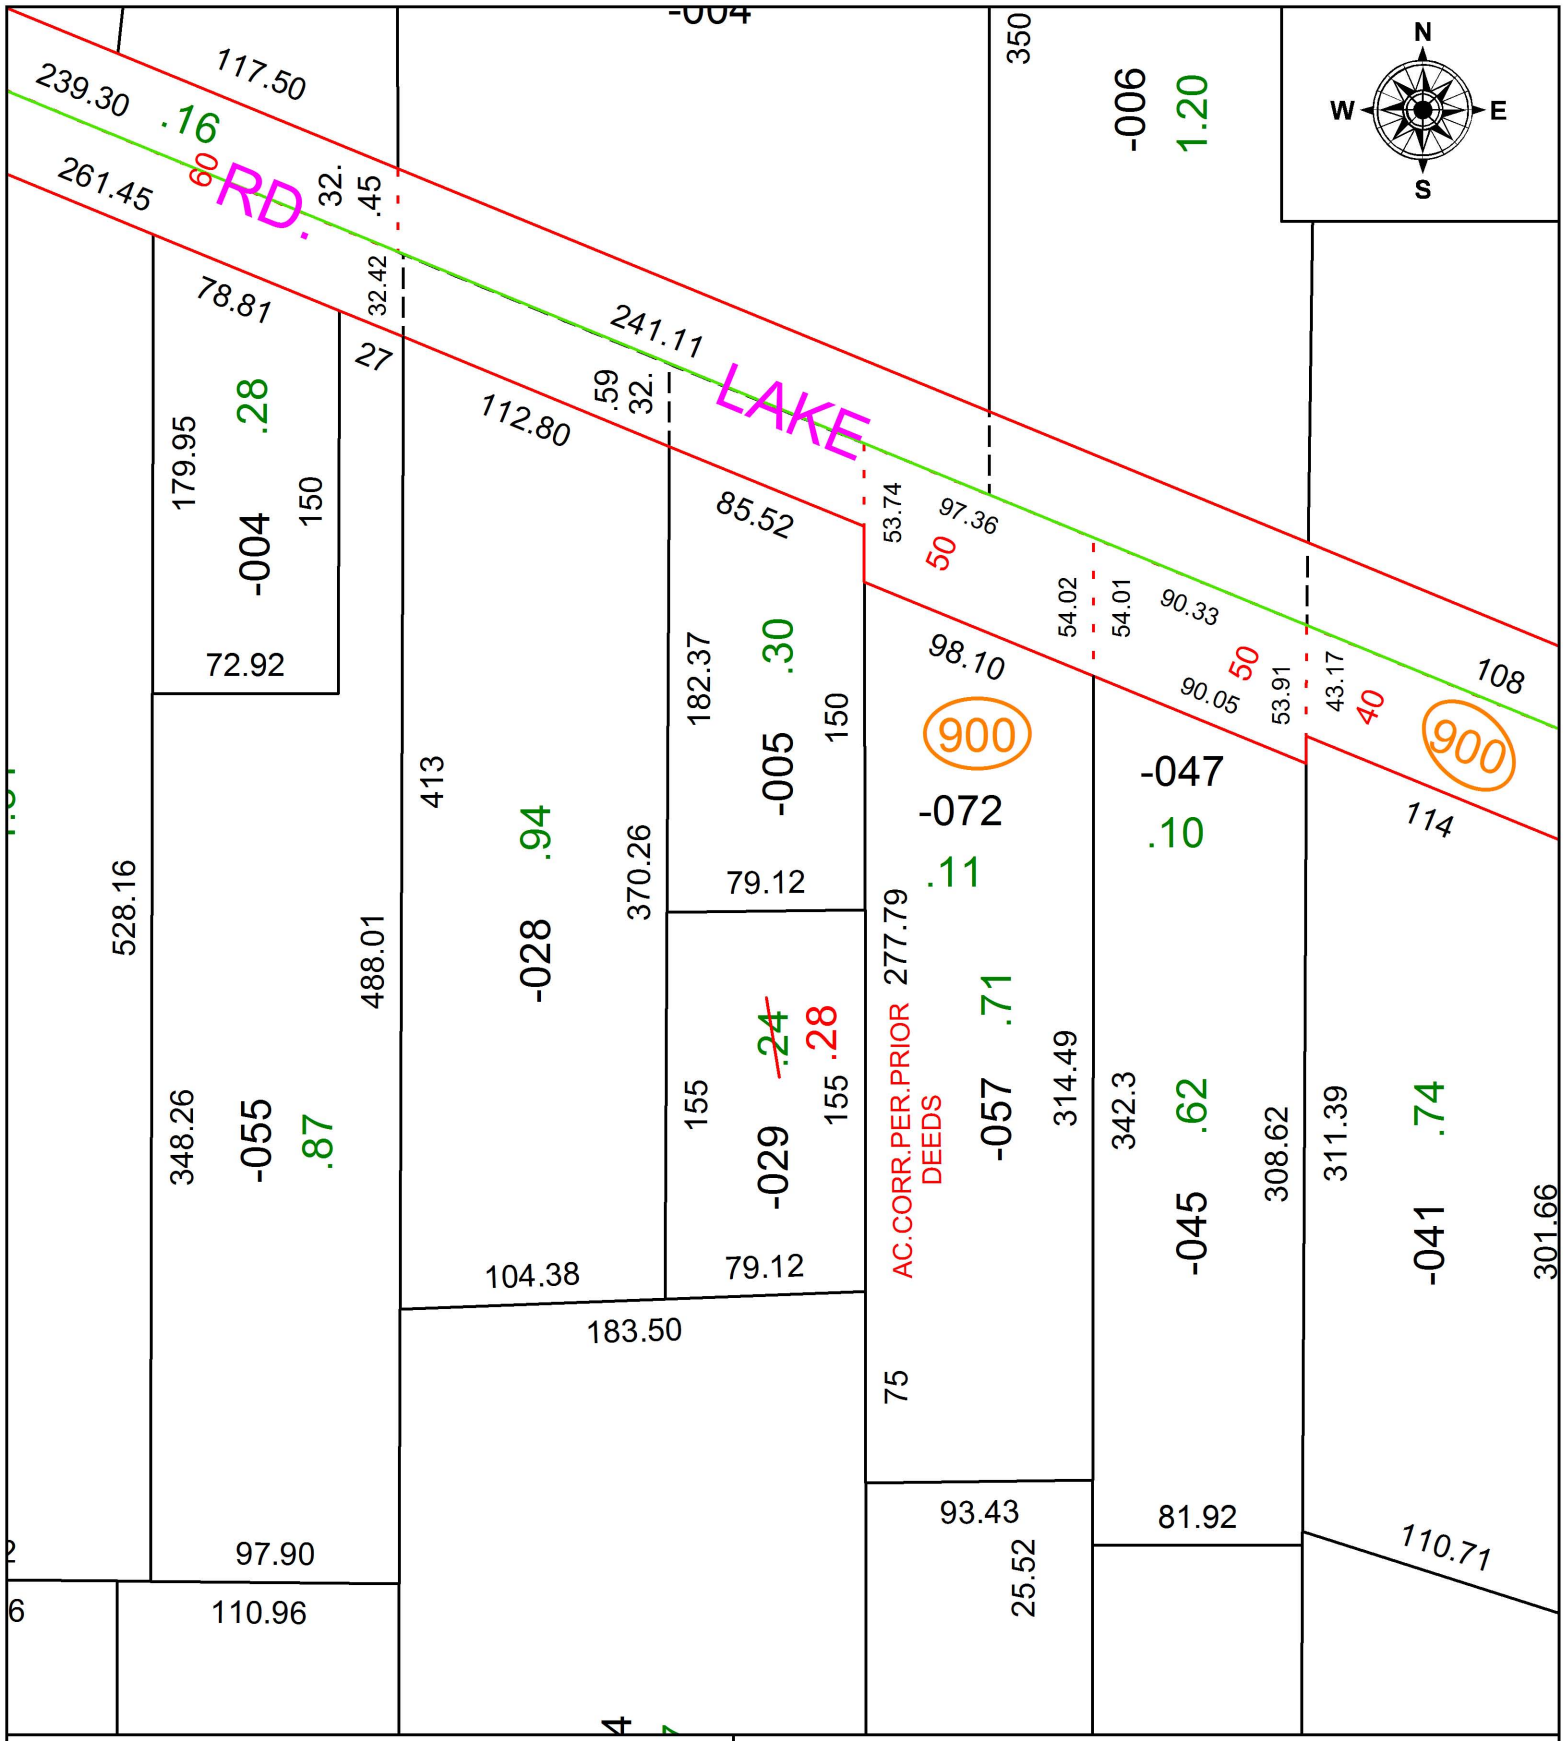

SPLITS/DEEDS PROCESSED

LORAIN COUNTY TAX MAP DEPARTMENT
226 MIDDLE AVE. ELYRIA, OH

SURVEYED BY: N/A
CLOSURE: N/A
MAP PAGE(S): 4-00-019
APPOVED BY: RRM **DATE:** 2-4-20
SCALE: 1" = 75 **PRIOR INSTRUMENT:** 20180669777