PARENT PARCEL: 16-00-084-000-014

CHILD PARCEL: 16-00-084-000-020, -021

STARTING POINT: SOUTHEAST CORNER OF O.L.84

21-04279

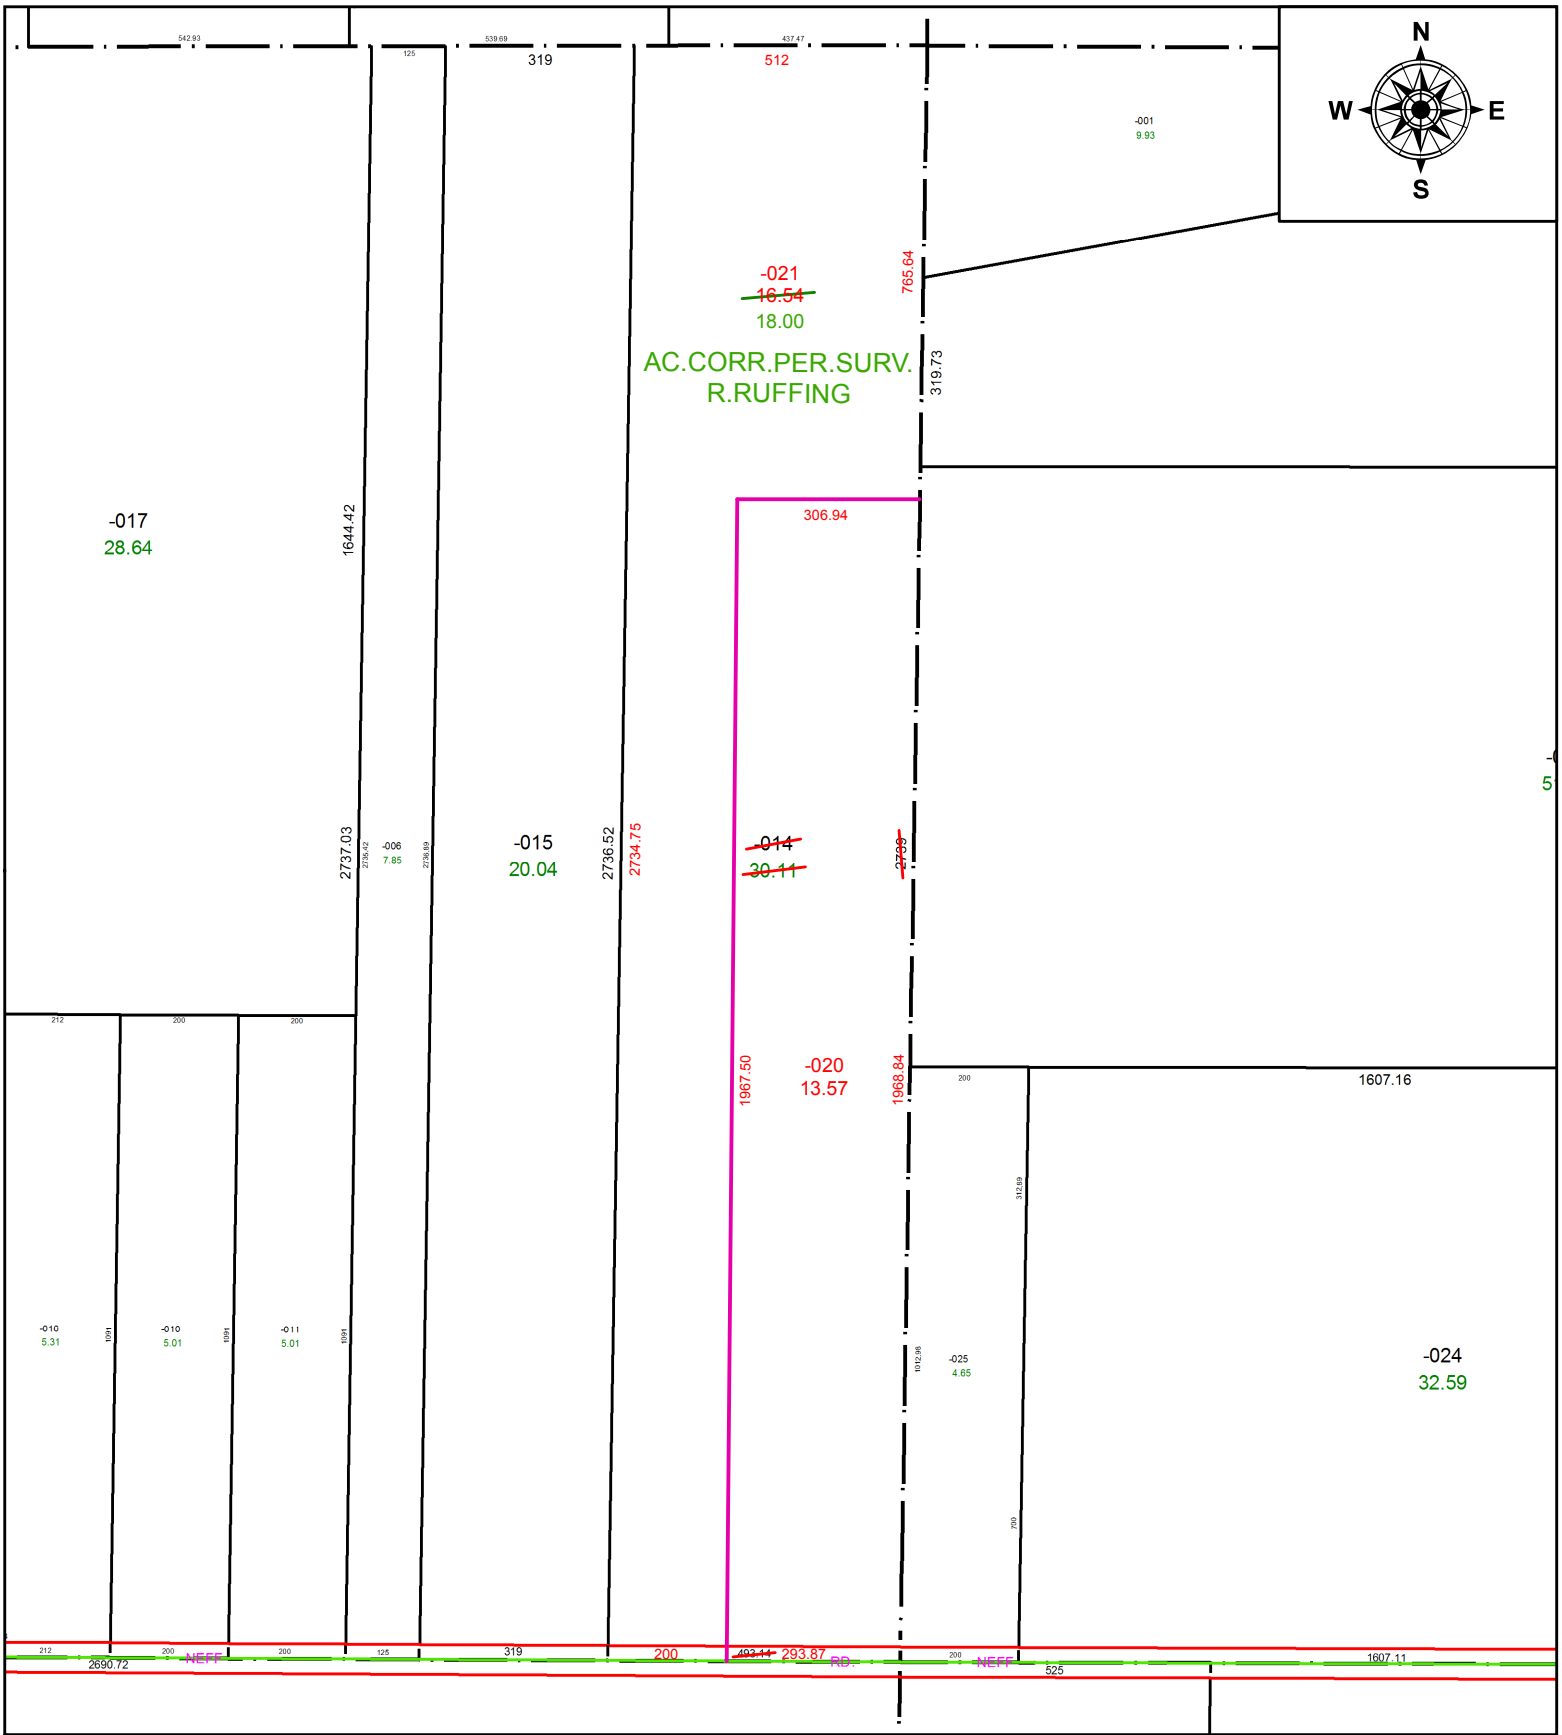

SPLITS/DEEDS PROCESSED

LORAIN COUNTY TAX MAP DEPARTMENT
226 MIDDLE AVE. ELYRIA, OH

SURVEYED BY: ROBERT M. RUFFING
CLOSURE: 1: 960,176
MAP PAGE(S): 16-00-084
APPOVED BY: RRM **DATE:** 3-29-21
SCALE: 1" = 325 **PRIOR INSTRUMENT:** 20070208051