**PARENT PARCEL:** 10-00-006-120-053

**CHILD PARCEL:**

**STARTING POINT:** INTERSECTION OF C/L OF BUTTERNUT RIDGE RD. AND C/L OF GRAFTON RD.

# 20-04280-A

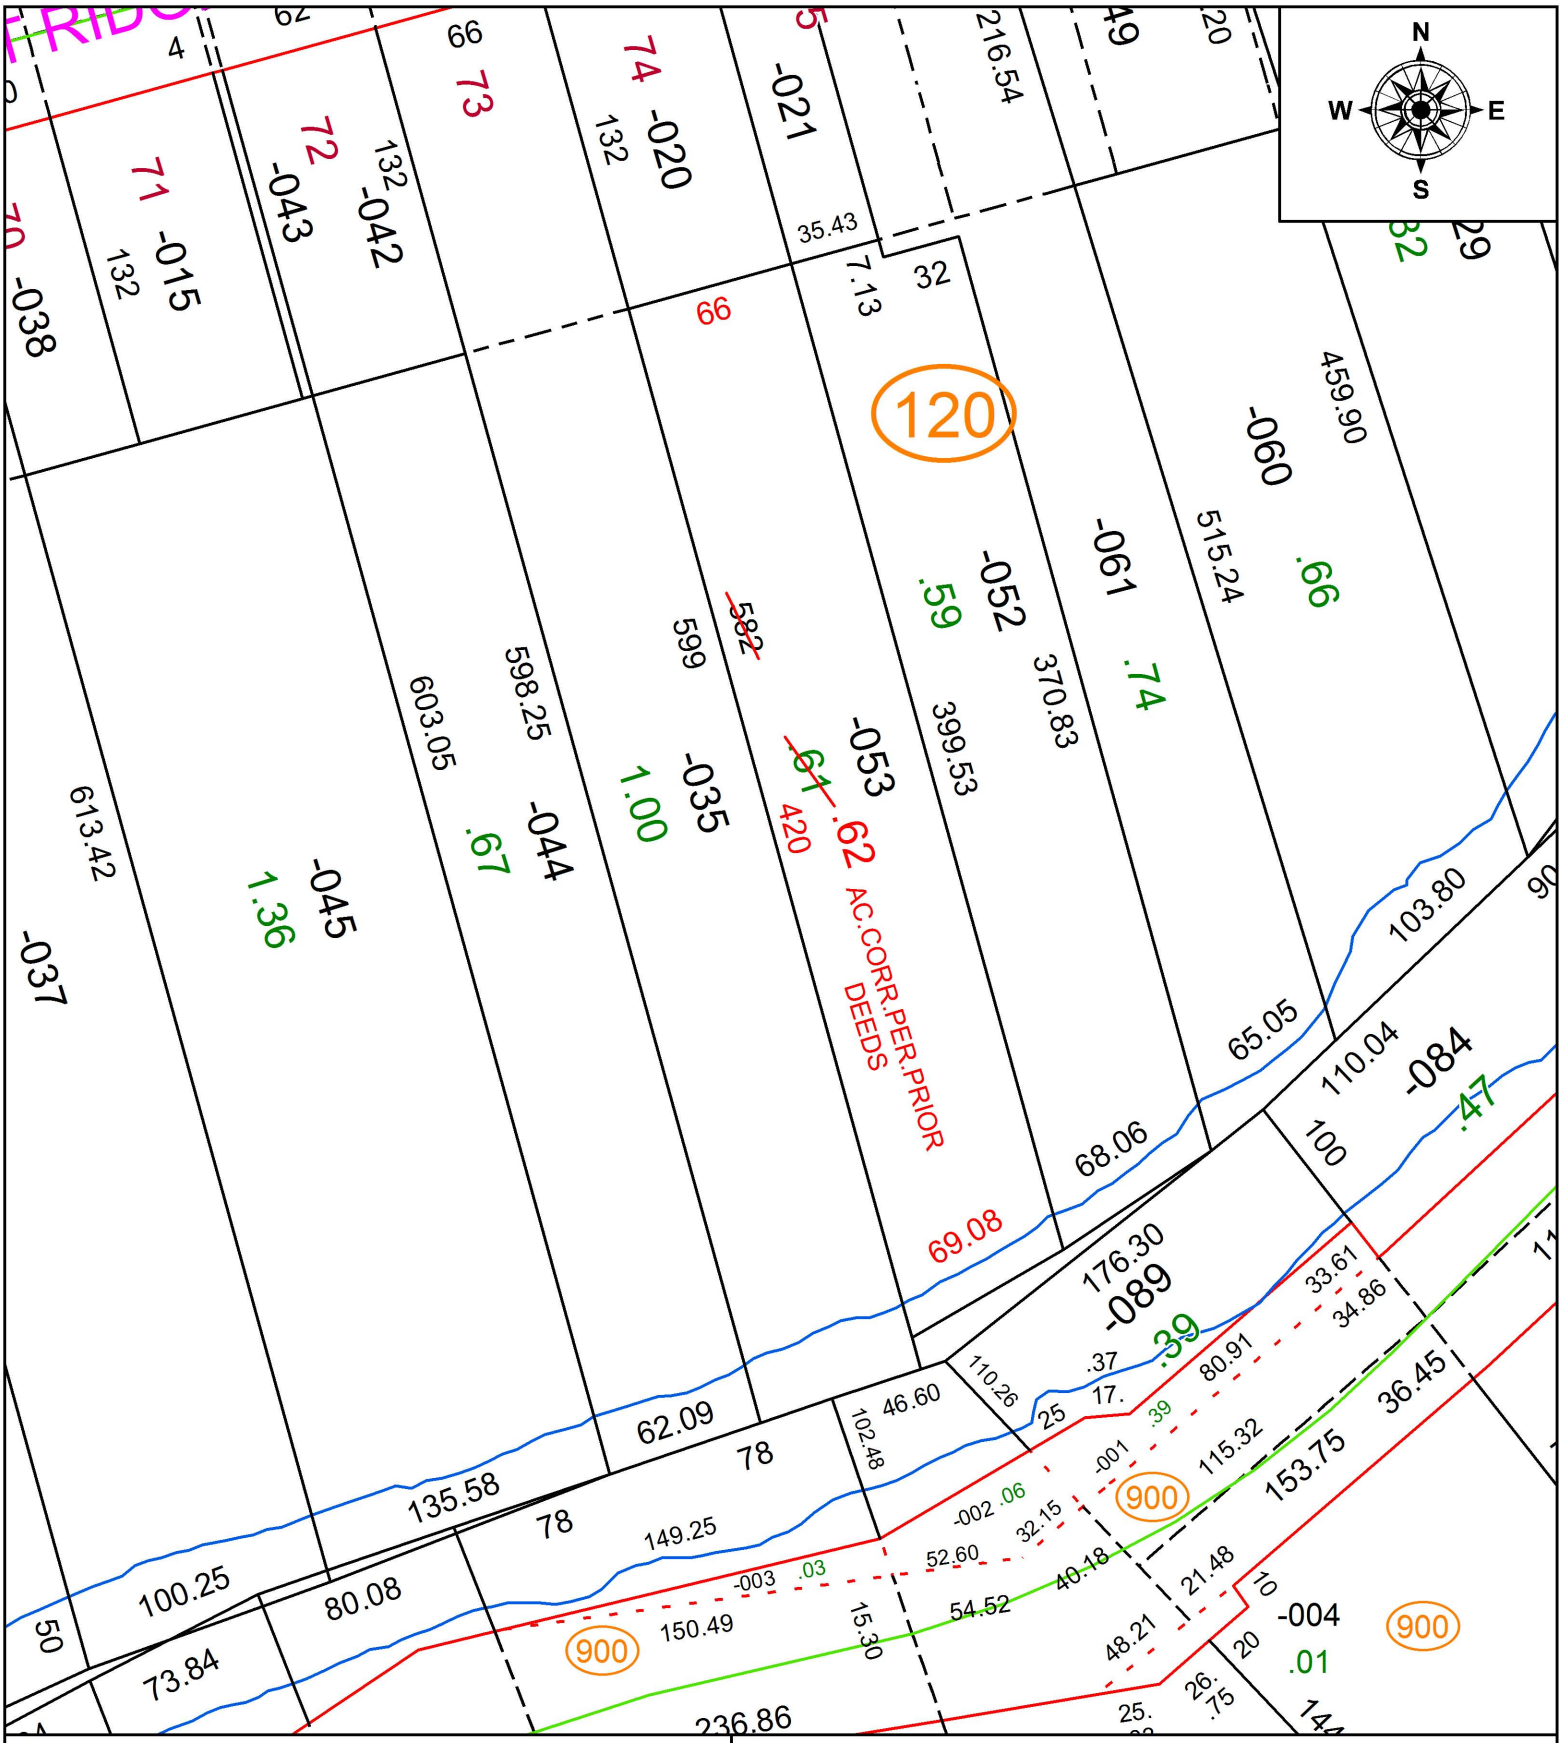


**SPLITS/DEEDS PROCESSED**

LORAIN COUNTY TAX MAP DEPARTMENT
226 MIDDLE AVE. ELYRIA, OH

**SURVEYED BY:** N/A
**CLOSURE:** 1:149,674
**MAP PAGE(S):** 10-00-006
**APPOVED BY:** RRM **DATE:** 2-4-20
**SCALE:** 1" = 75 **PRIOR INSTRUMENT:** 20180660486