PARENT PARCEL: 11-00-024-000-084, 11-00-025-000-038, -039

CHILD PARCEL: 11-00-024-000-084, 11-00-025-000-040 THRU -044

STARTING POINT: NORTHWEST CORNER OF O.L.25

21-04281

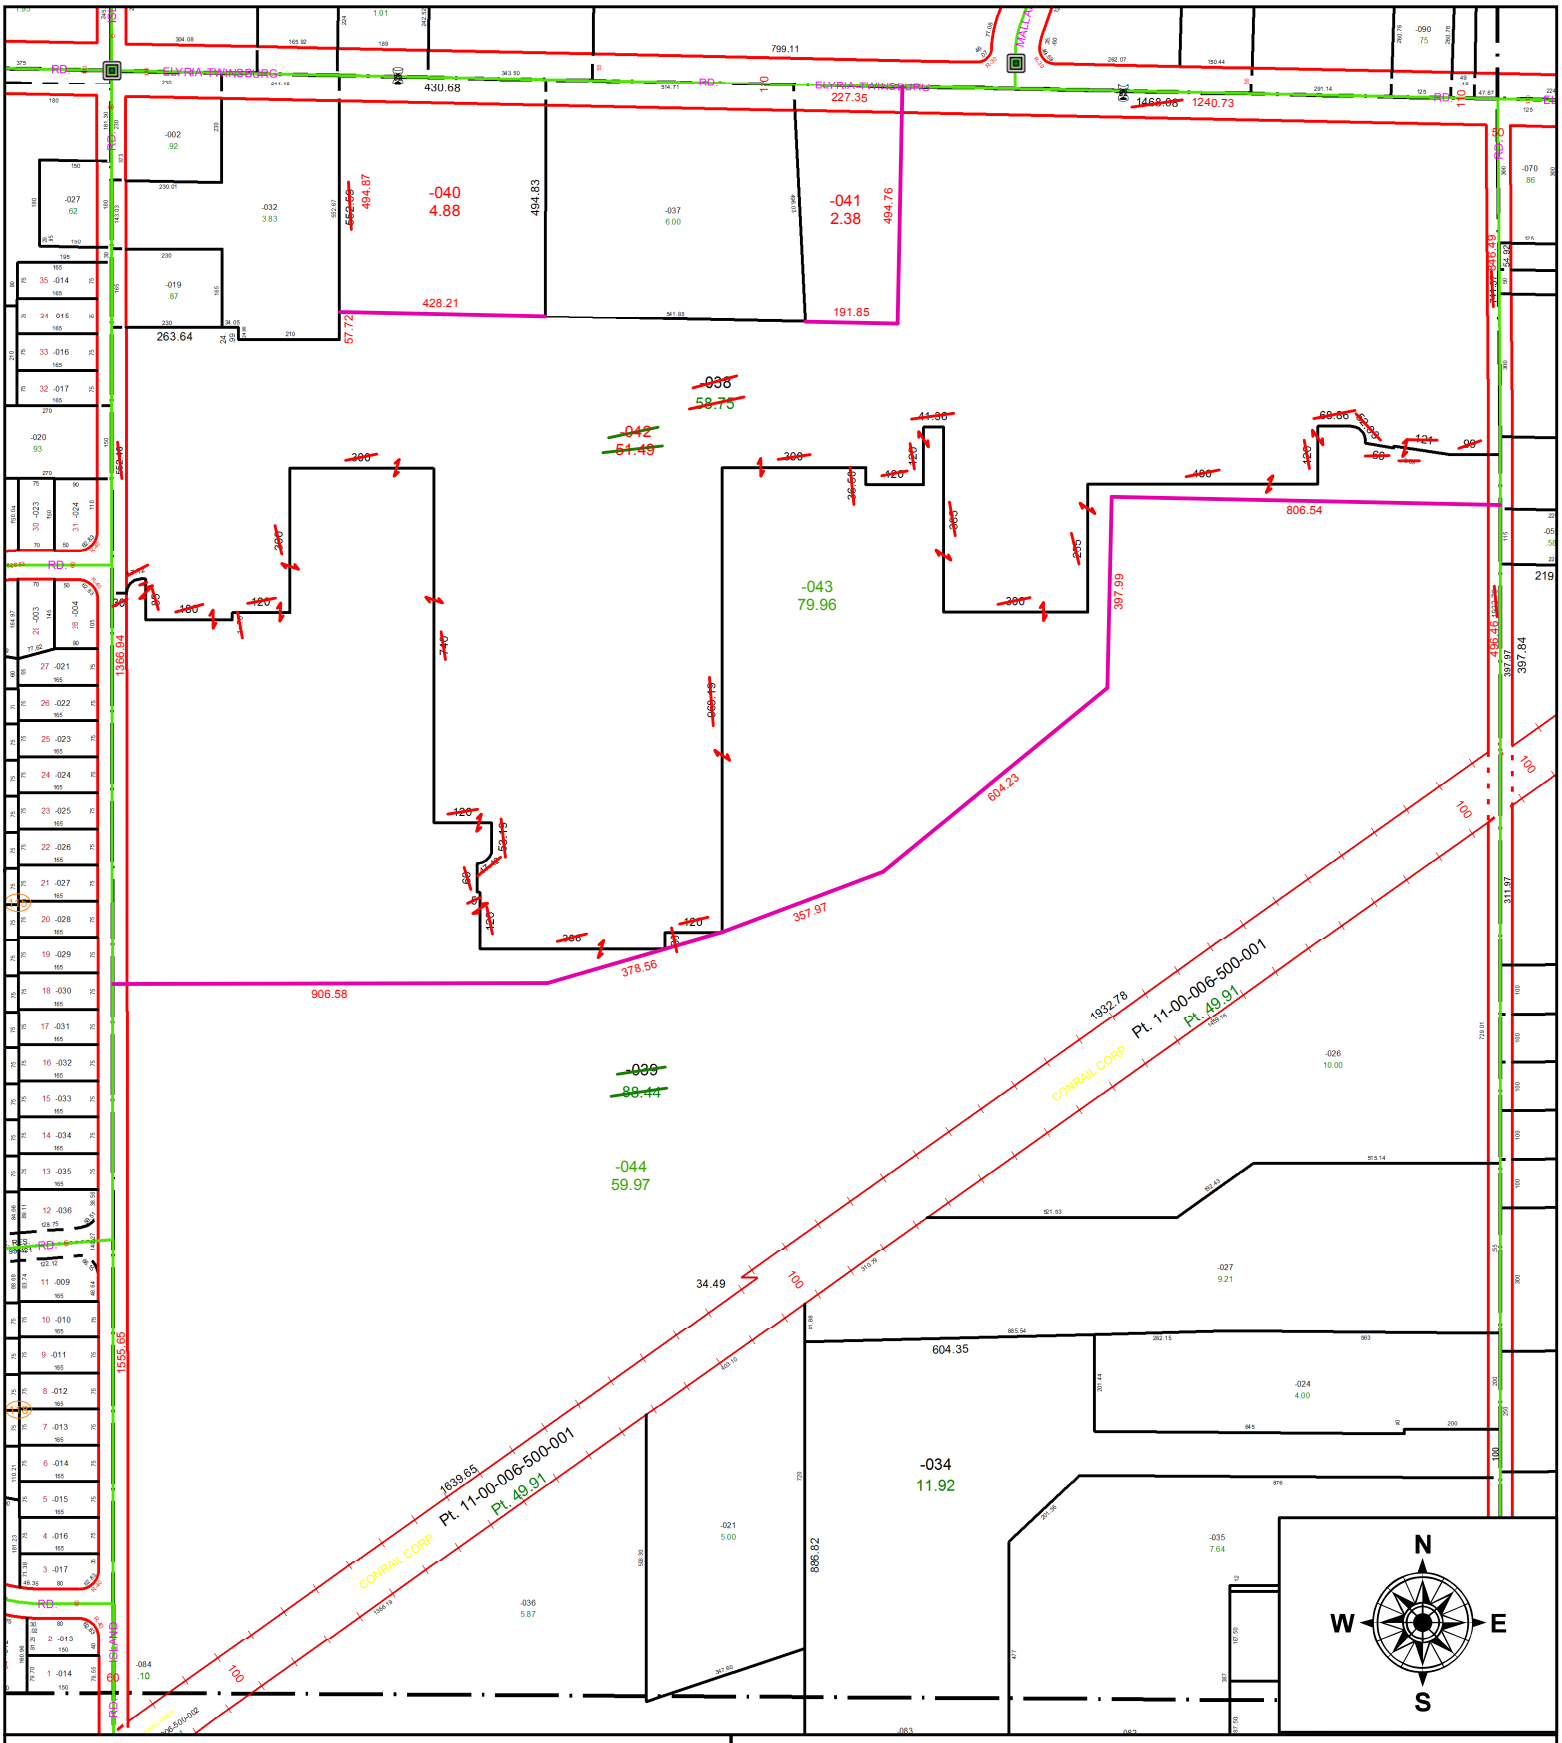

SPLITS/DEEDS PROCESSED

LORAIN COUNTY TAX MAP DEPARTMENT
226 MIDDLE AVE. ELYRIA, OH

SURVEYED BY: ALEX E. MARKS
CLOSURE: 1:3,055,030
MAP PAGE(S): 11-00-025
APPOVED BY: RRM **DATE:** 4-2-21
SCALE: 1" = 400 **PRIOR INSTRUMENT:** 20170655214