PARENT PARCEL: 09-00-054-000-029

CHILD PARCEL: 09-00-054-000-040, -041

STARTING POINT: INTERSECTION OF C/L OF PYLE SOUTH AMHERST RD, AND C/L OF BUTTERNUT RIDGE RD,.

21-04283

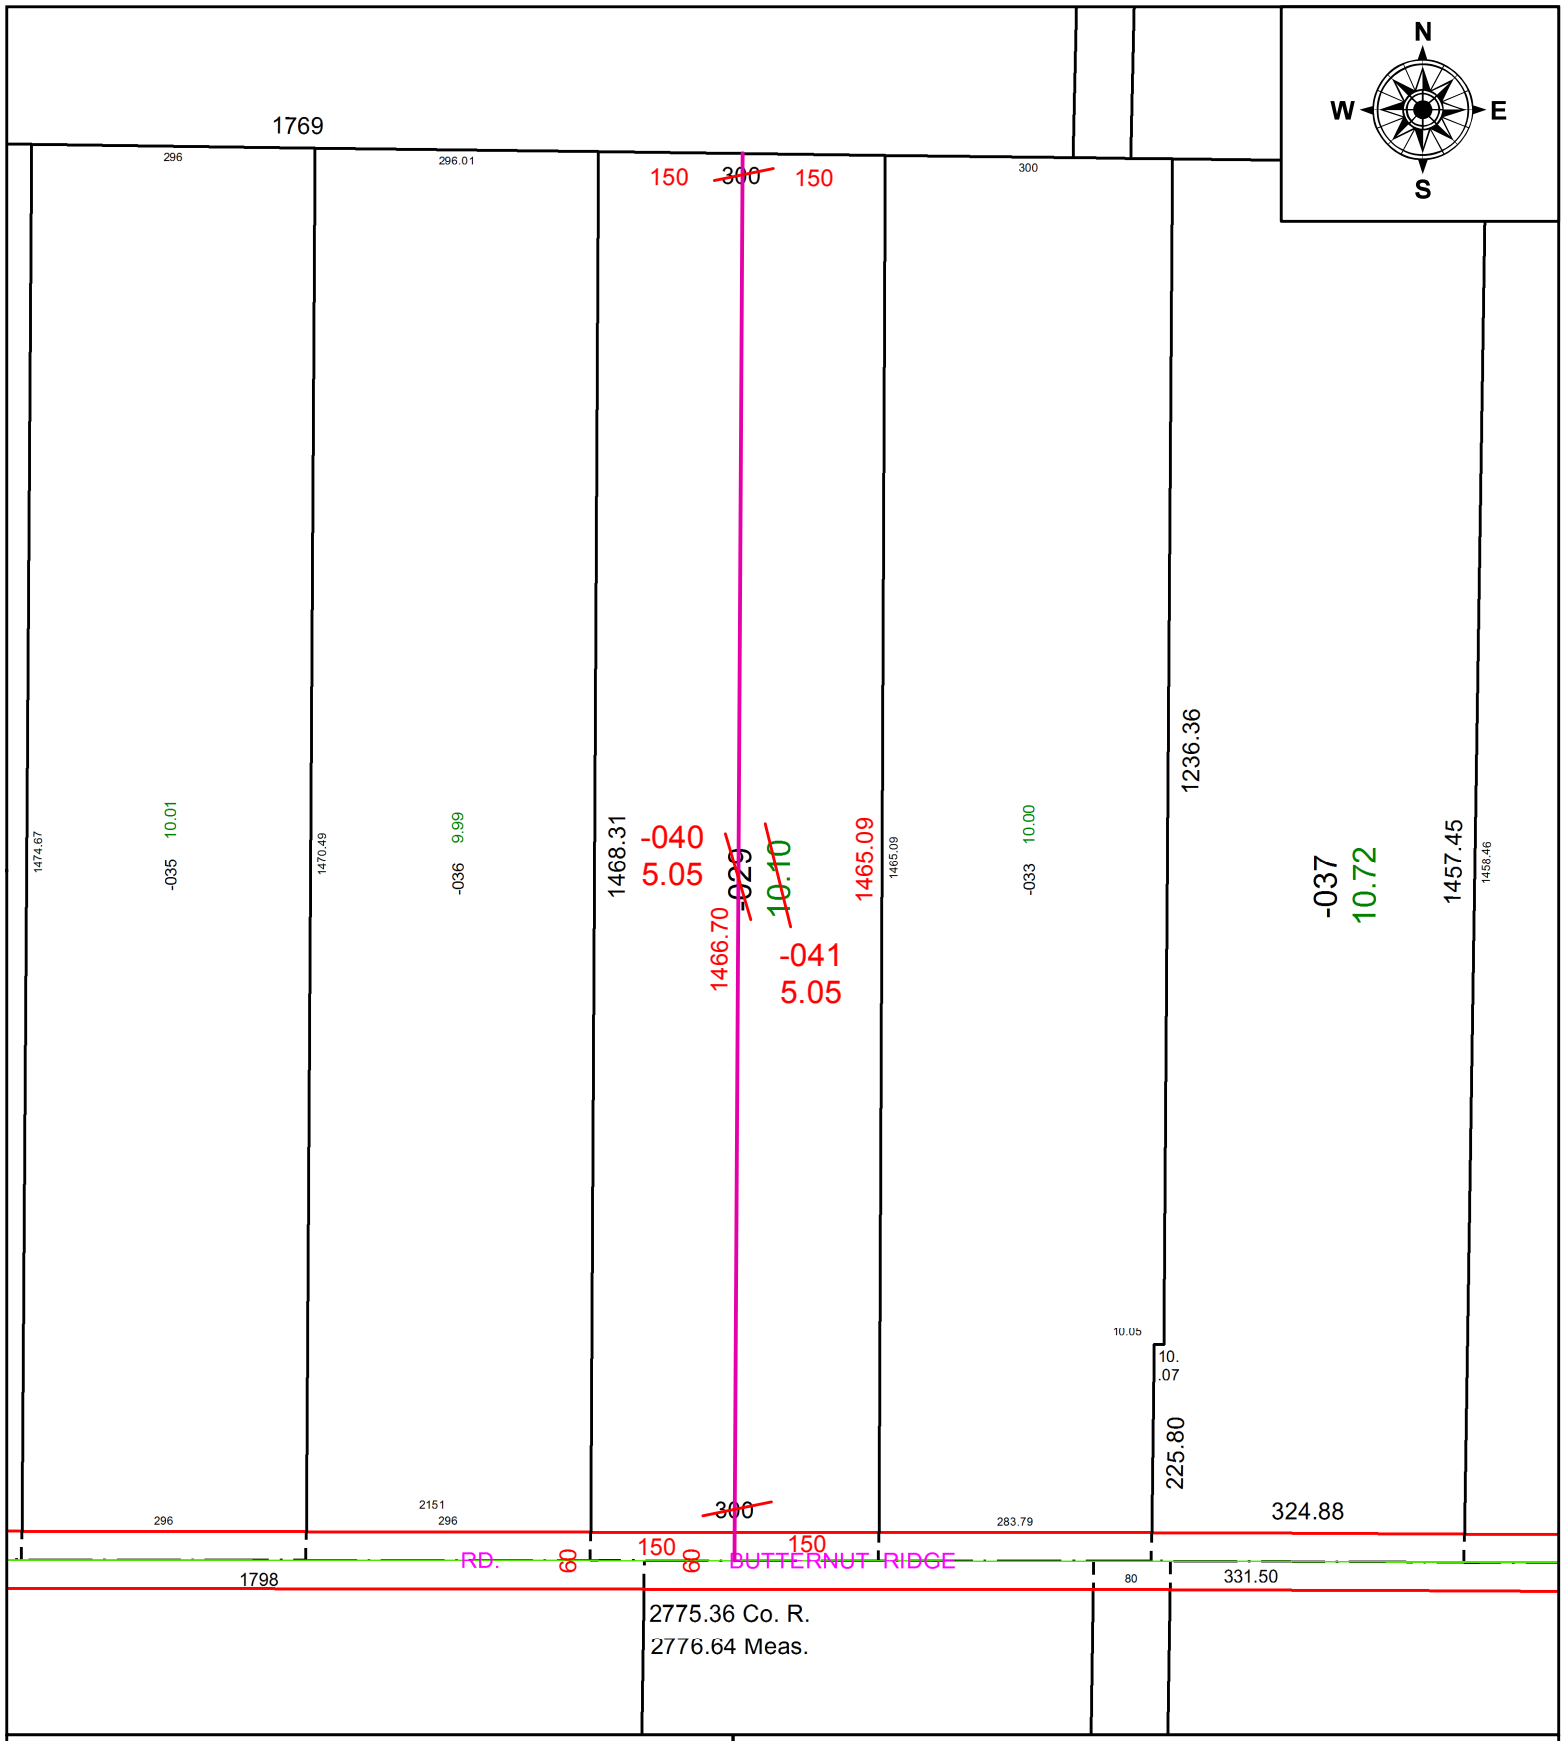

SPLITS/DEEDS PROCESSED

LORAIN COUNTY TAX MAP DEPARTMENT
226 MIDDLE AVE. ELYRIA, OH

SURVEYED BY: THOMAS M. SNEZEK
CLOSURE: 1: 332,211
MAP PAGE(S): 9-00-054
APPOVED BY: RRM **DATE:** 4-6-21
SCALE: 1" = 200 **PRIOR INSTRUMENT:** 20030896362