PARENT PARCEL: 02-01-006-134-039

CHILD PARCEL:

STARTING POINT: SOUTH 44 FT OF S/L 112 IN J.B. HOGE'S ADD.

20-04284-C

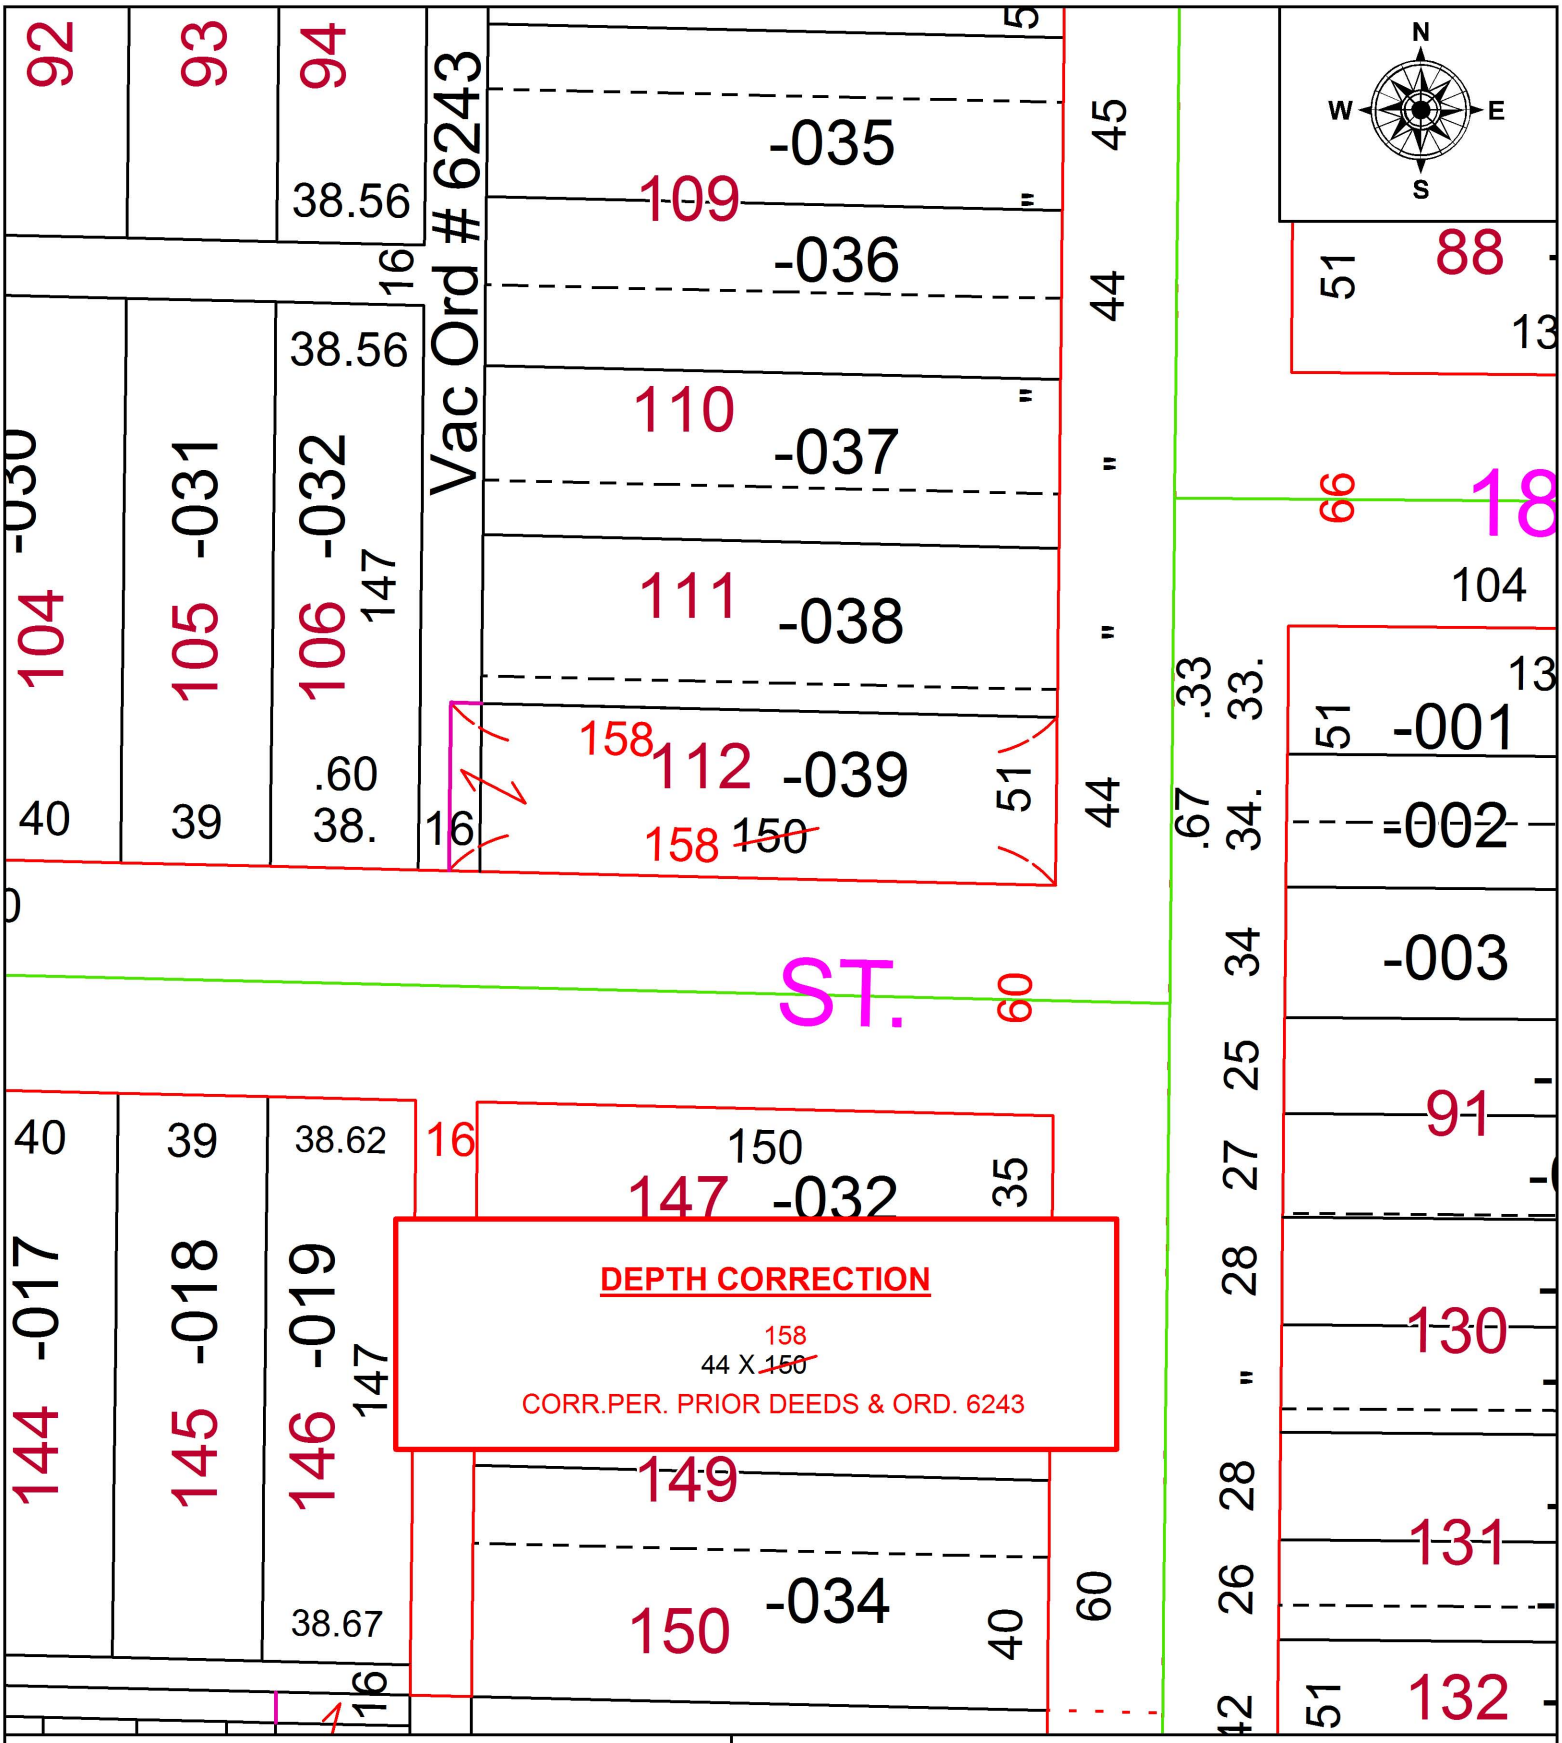

DEPTH CORRECTION

158
44 X ~~150~~

CORR.PER. PRIOR DEEDS & ORD. 6243

SPLITS/DEEDS PROCESSED

LORAIN COUNTY TAX MAP DEPARTMENT
226 MIDDLE AVE. ELYRIA, OH

SURVEYED BY: N/A
CLOSURE: N/A
MAP PAGE(S): 2-01-006
APPOVED BY: RRM **DATE:** 2-5-20
SCALE: 1" = 50 **PRIOR INSTRUMENT:** 20180689527