PARENT PARCEL: 05-00-083-000-003, -019, -020

CHILD PARCEL: 05-00-083-000-023 THRU -026

STARTING POINT: INTERSECTION OF C/L OF WEST RIDGE RD, AND C/L OF DELLEFIELD RD.

21-04286

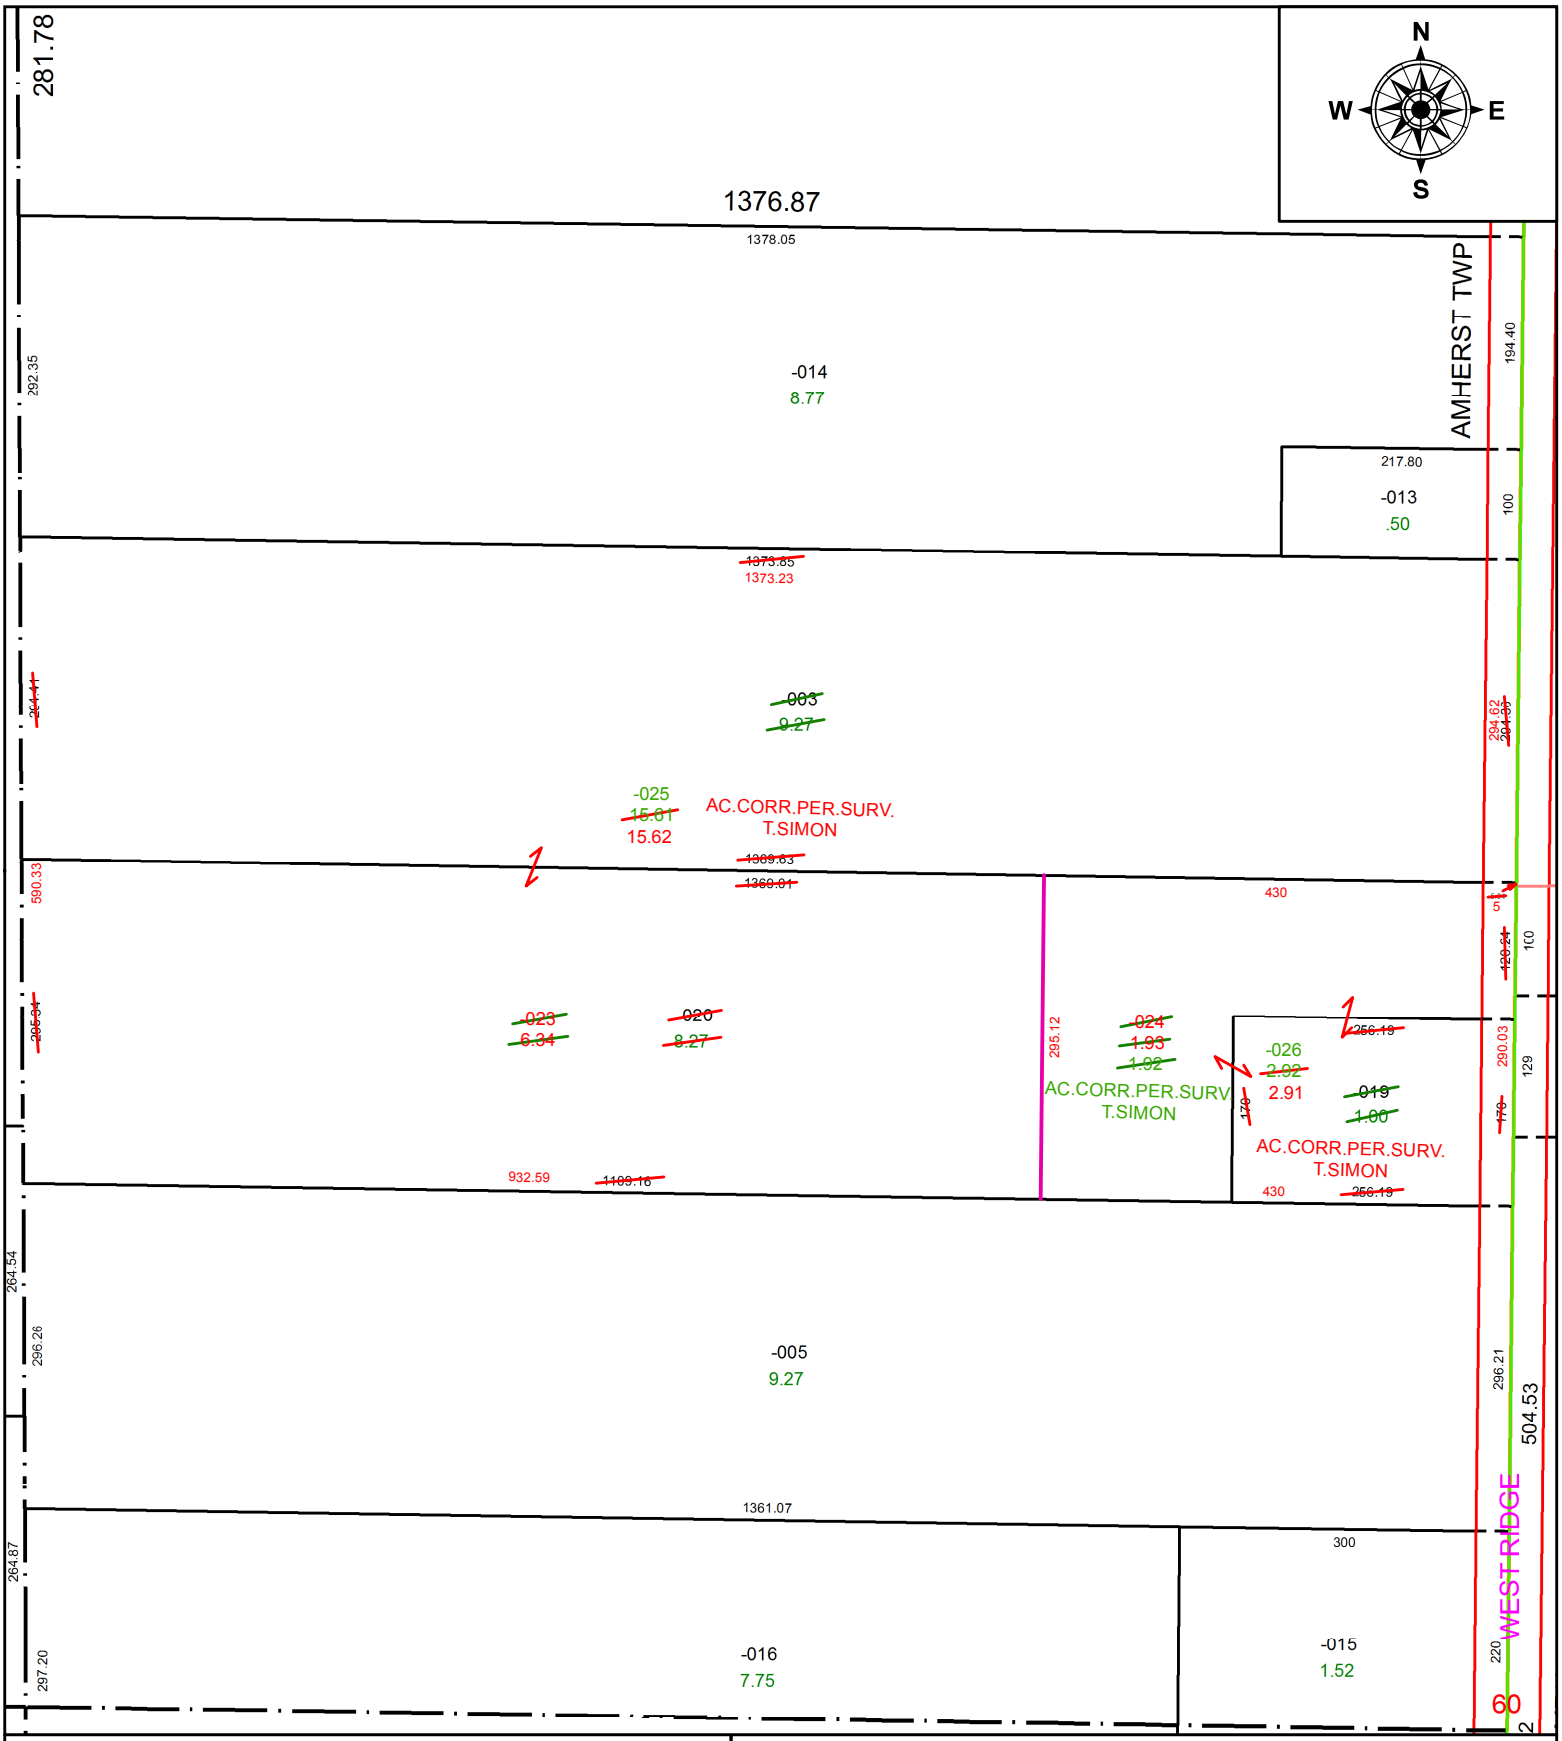

SPLITS/DEEDS PROCESSED

LORAIN COUNTY TAX MAP DEPARTMENT
226 MIDDLE AVE. ELYRIA, OH

SURVEYED BY: THOMAS A. SIMON
CLOSURE: 1: 584,342
MAP PAGE(S): 5-00-083
APPOVED BY: RRM **DATE:** 4-20-21
SCALE: 1" = 175 **PRIOR INSTRUMENT:** 20150557254