**PARENT PARCEL:** 04-00-017-103-375, -376
**CHILD PARCEL:** 04-00-017-103-378
**STARTING POINT:** C/L OF WALKER RD & DANBURY LN

# 21-04290

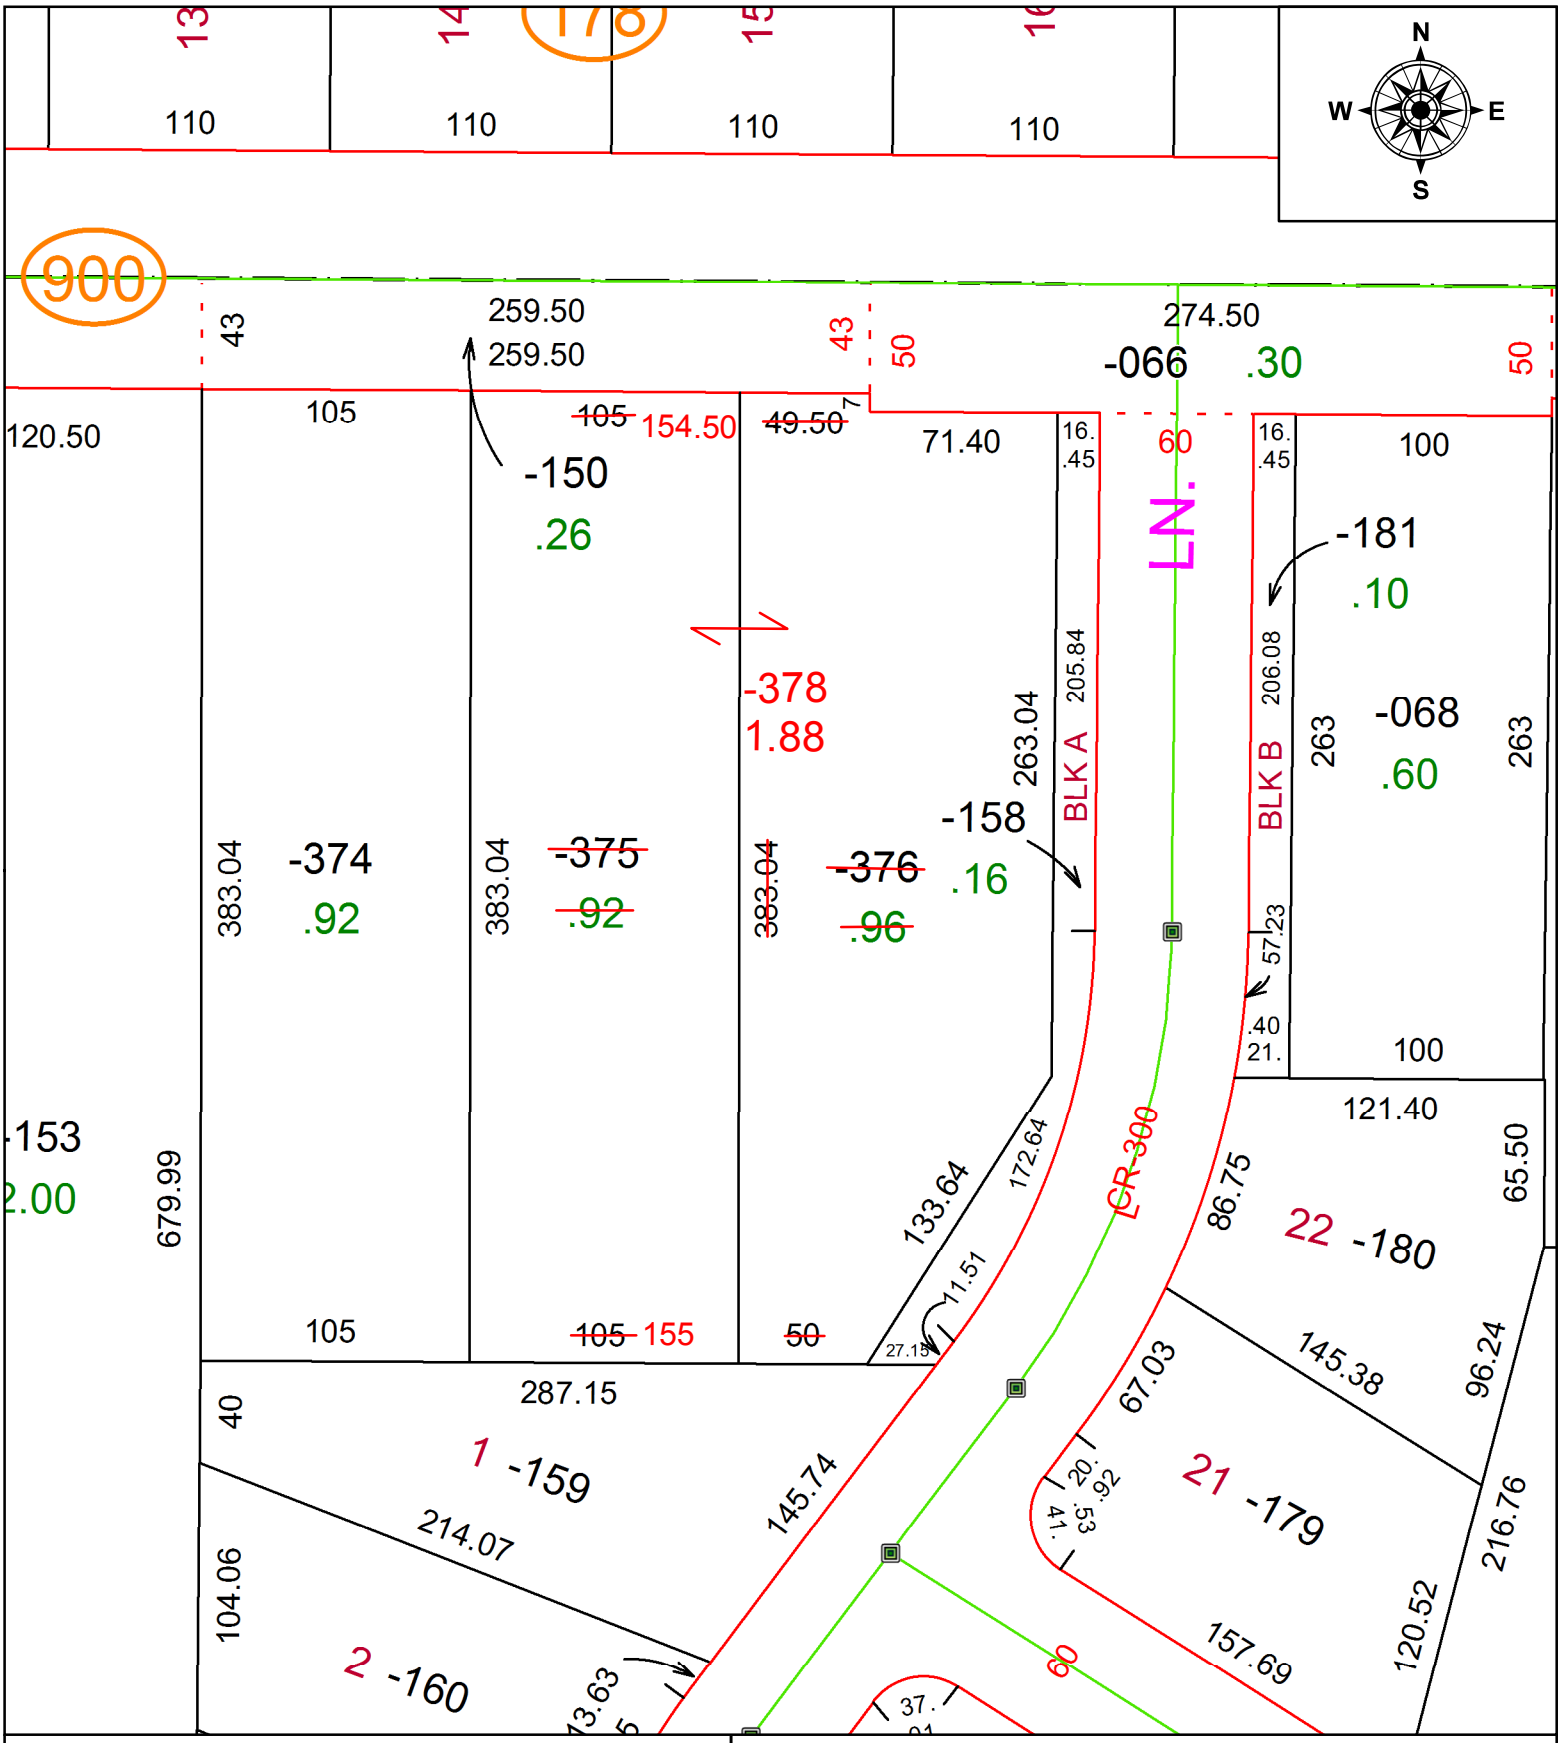


**SPLITS/DEEDS PROCESSED**
LORAIN COUNTY TAX MAP DEPARTMENT
226 MIDDLE AVE. ELYRIA, OH

**SURVEYED BY:** THOMAS M. SNEZEK
**CLOSURE:** 1:220,444
**MAP PAGE(S):** 4-00-017
**APPOVED BY:** WRZ **DATE:** 4-29-21
**SCALE:** 1" = 75 **PRIOR INSTRUMENT:** 20210805972