PARENT PARCEL: 20-05-023-109-011

CHILD PARCEL:

STARTING POINT: NORTHWEST CORNER OF S/L 13 IN WHEELER & MITCHELL'S ADD

20-04291-C

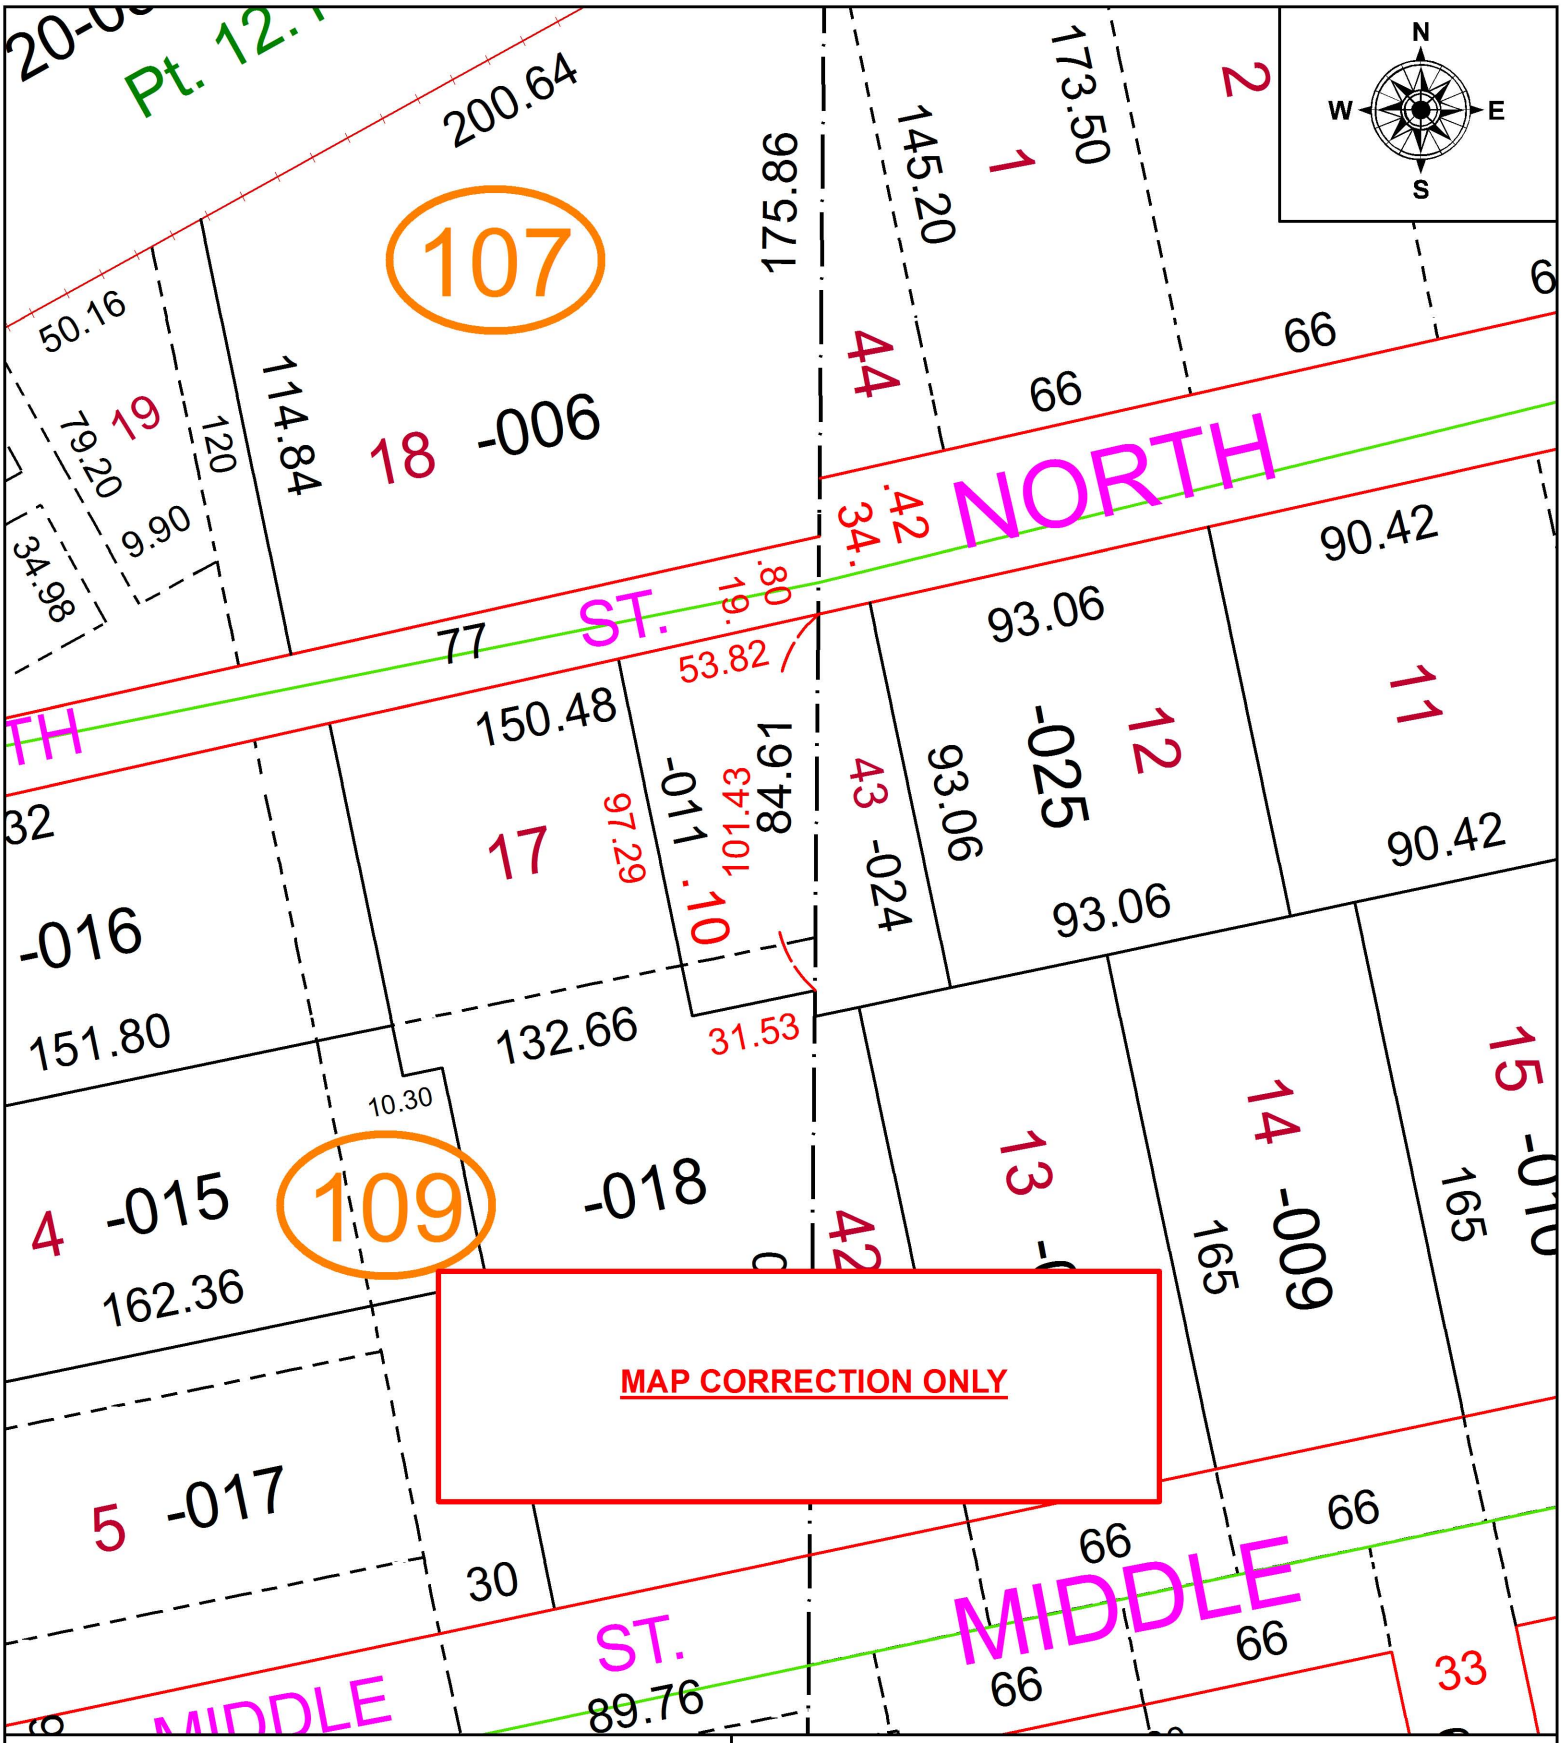

SPLITS/DEEDS PROCESSED

LORAIN COUNTY TAX MAP DEPARTMENT
226 MIDDLE AVE. ELYRIA, OH

SURVEYED BY: JASON K. LAUGHERY
CLOSURE: 1:55,497
MAP PAGE(S): 20-05-023
APPOVED BY: RRM **DATE:** 2-20-20
SCALE: 1" = 50 **PRIOR INSTRUMENT:** 20150547506