PARENT PARCEL: 09-00-013-101-014
CHILD PARCEL: 09-00-013-101-019, -020
STARTING POINT: MONUMENT BOX AT SOUTHEAST CORNER OF OL 13 & C/L OF PYLE-SOUTH AMHERST ROAD

21-04292

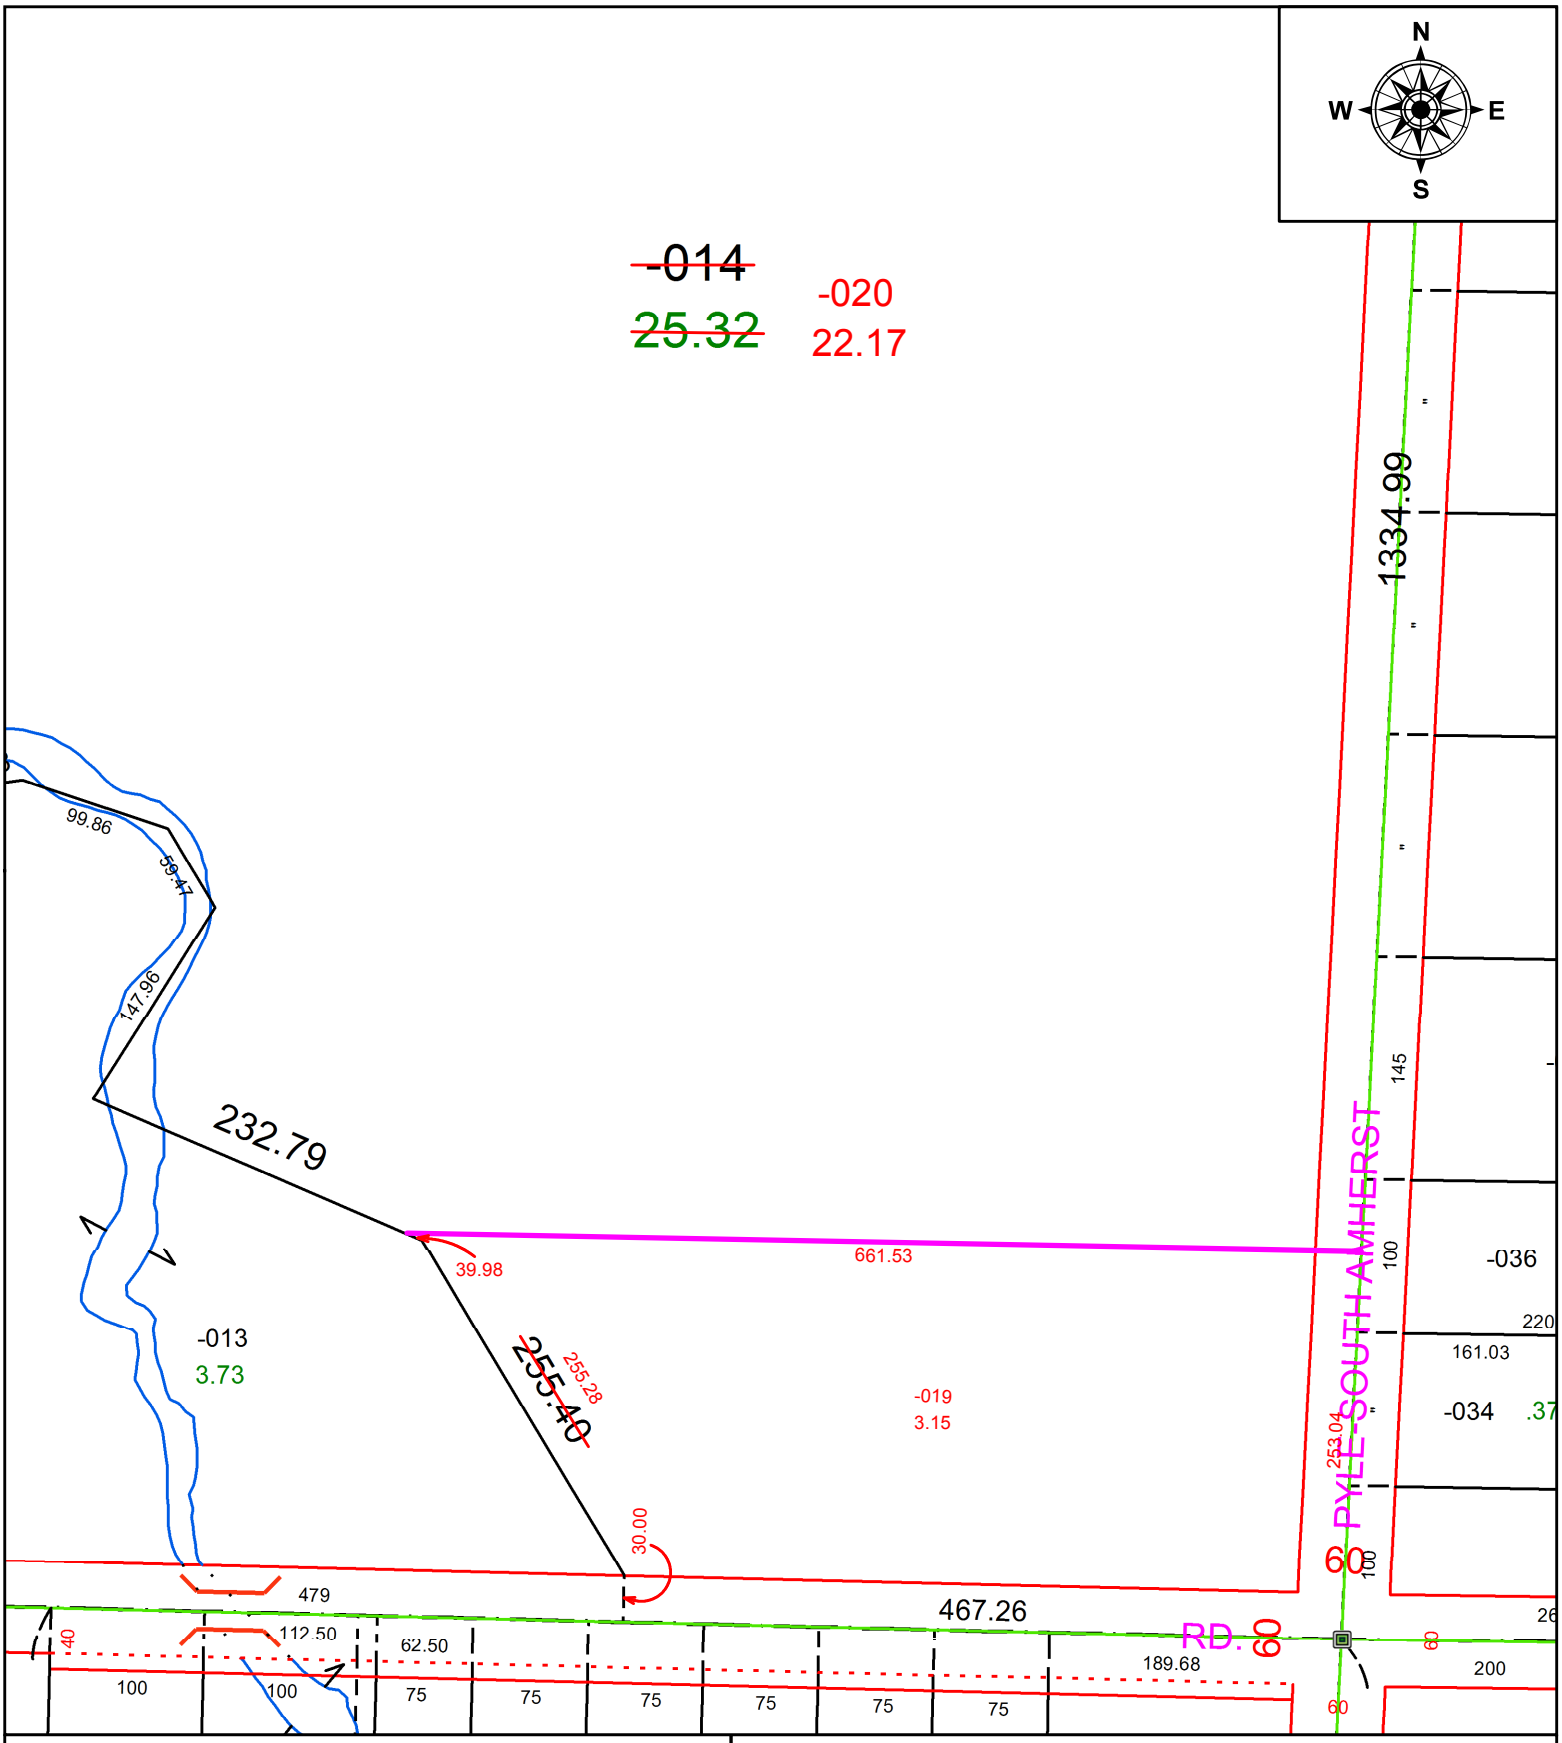

SPLITS/DEEDS PROCESSED
LORAIN COUNTY TAX MAP DEPARTMENT
226 MIDDLE AVE. ELYRIA, OH

SURVEYED BY: TIMOTHY D. HOZALSKI
CLOSURE: 1:666,662
MAP PAGE(S): 9-00-013
APPOVED BY: WRZ **DATE:** 5-6-21
SCALE: 1" = 125 **PRIOR INSTRUMENT:** 2008-0247267