PARENT PARCEL: 06-25-085-102-002, 06-25-085-102-003
CHILD PARCEL: 06-25-085-102-016
STARTING POINT: INTERSECTION OF C/L UNIVERSITY AND EAST RIVER STREET

21-04293

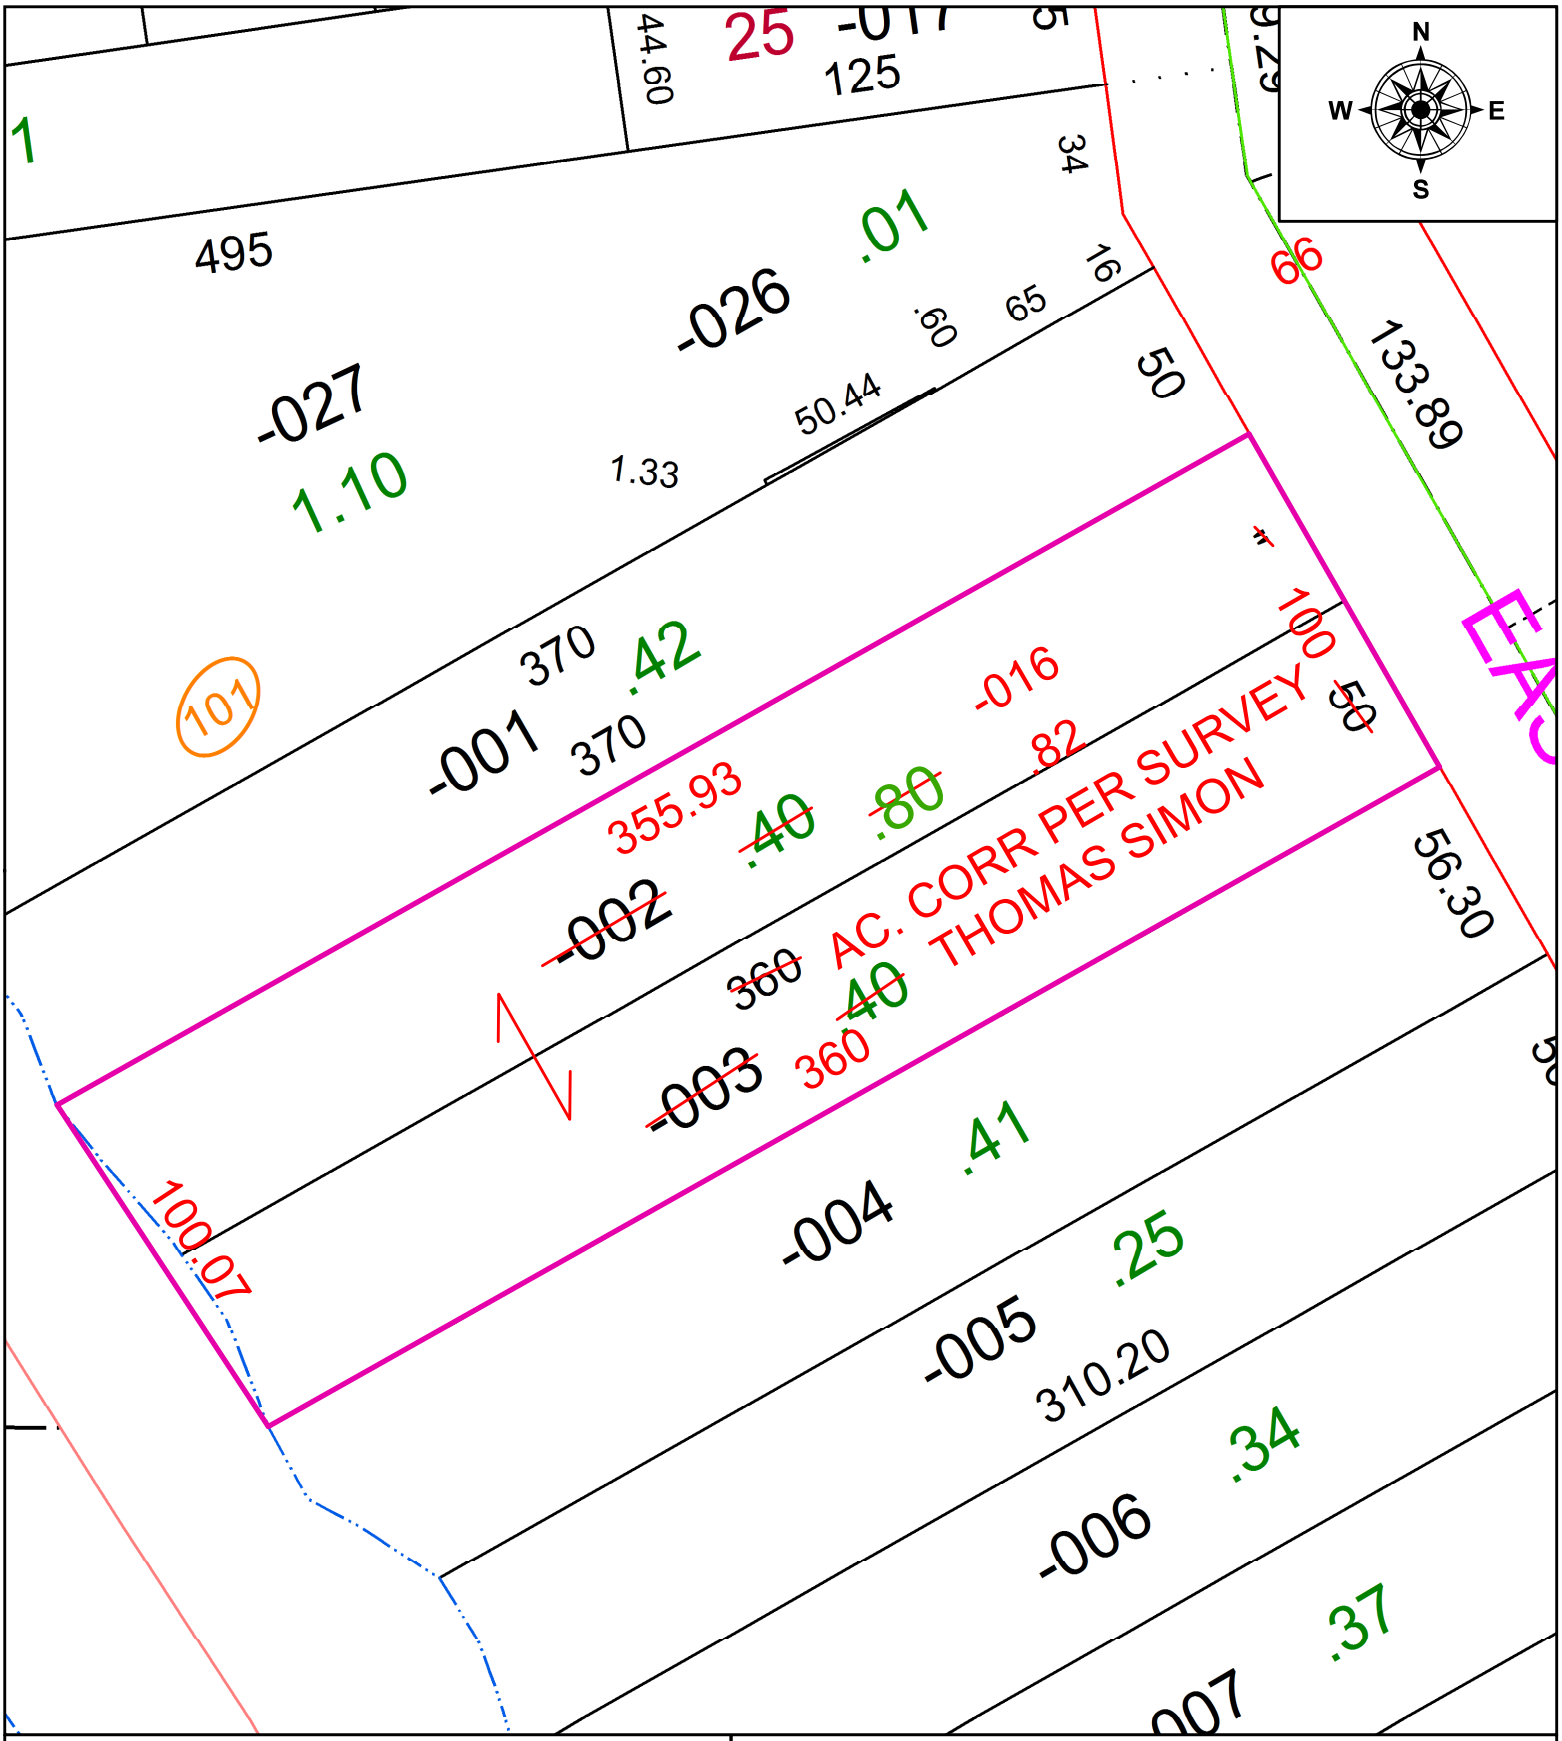

SPLITS/DEEDS PROCESSED
LORAIN COUNTY TAX MAP DEPARTMENT
226 MIDDLE AVE. ELYRIA, OH

SURVEYED BY: THOMAS A. SIMON
CLOSURE: 1: 266873
MAP PAGE(S): 06-25-085
APPOVED BY: AC **DATE:** 5/6/2021
SCALE: 1" = 50 **PRIOR INSTRUMENT:** 2020-0779839