PARENT PARCEL: 11-00-071-000-071

CHILD PARCEL: 11-00-071-000-124, -125

STARTING POINT: INTERSECTION OF C/L OF CHESTNUT RIDGE RD. AND WEST LINE OF O.L.71

20-04294-U

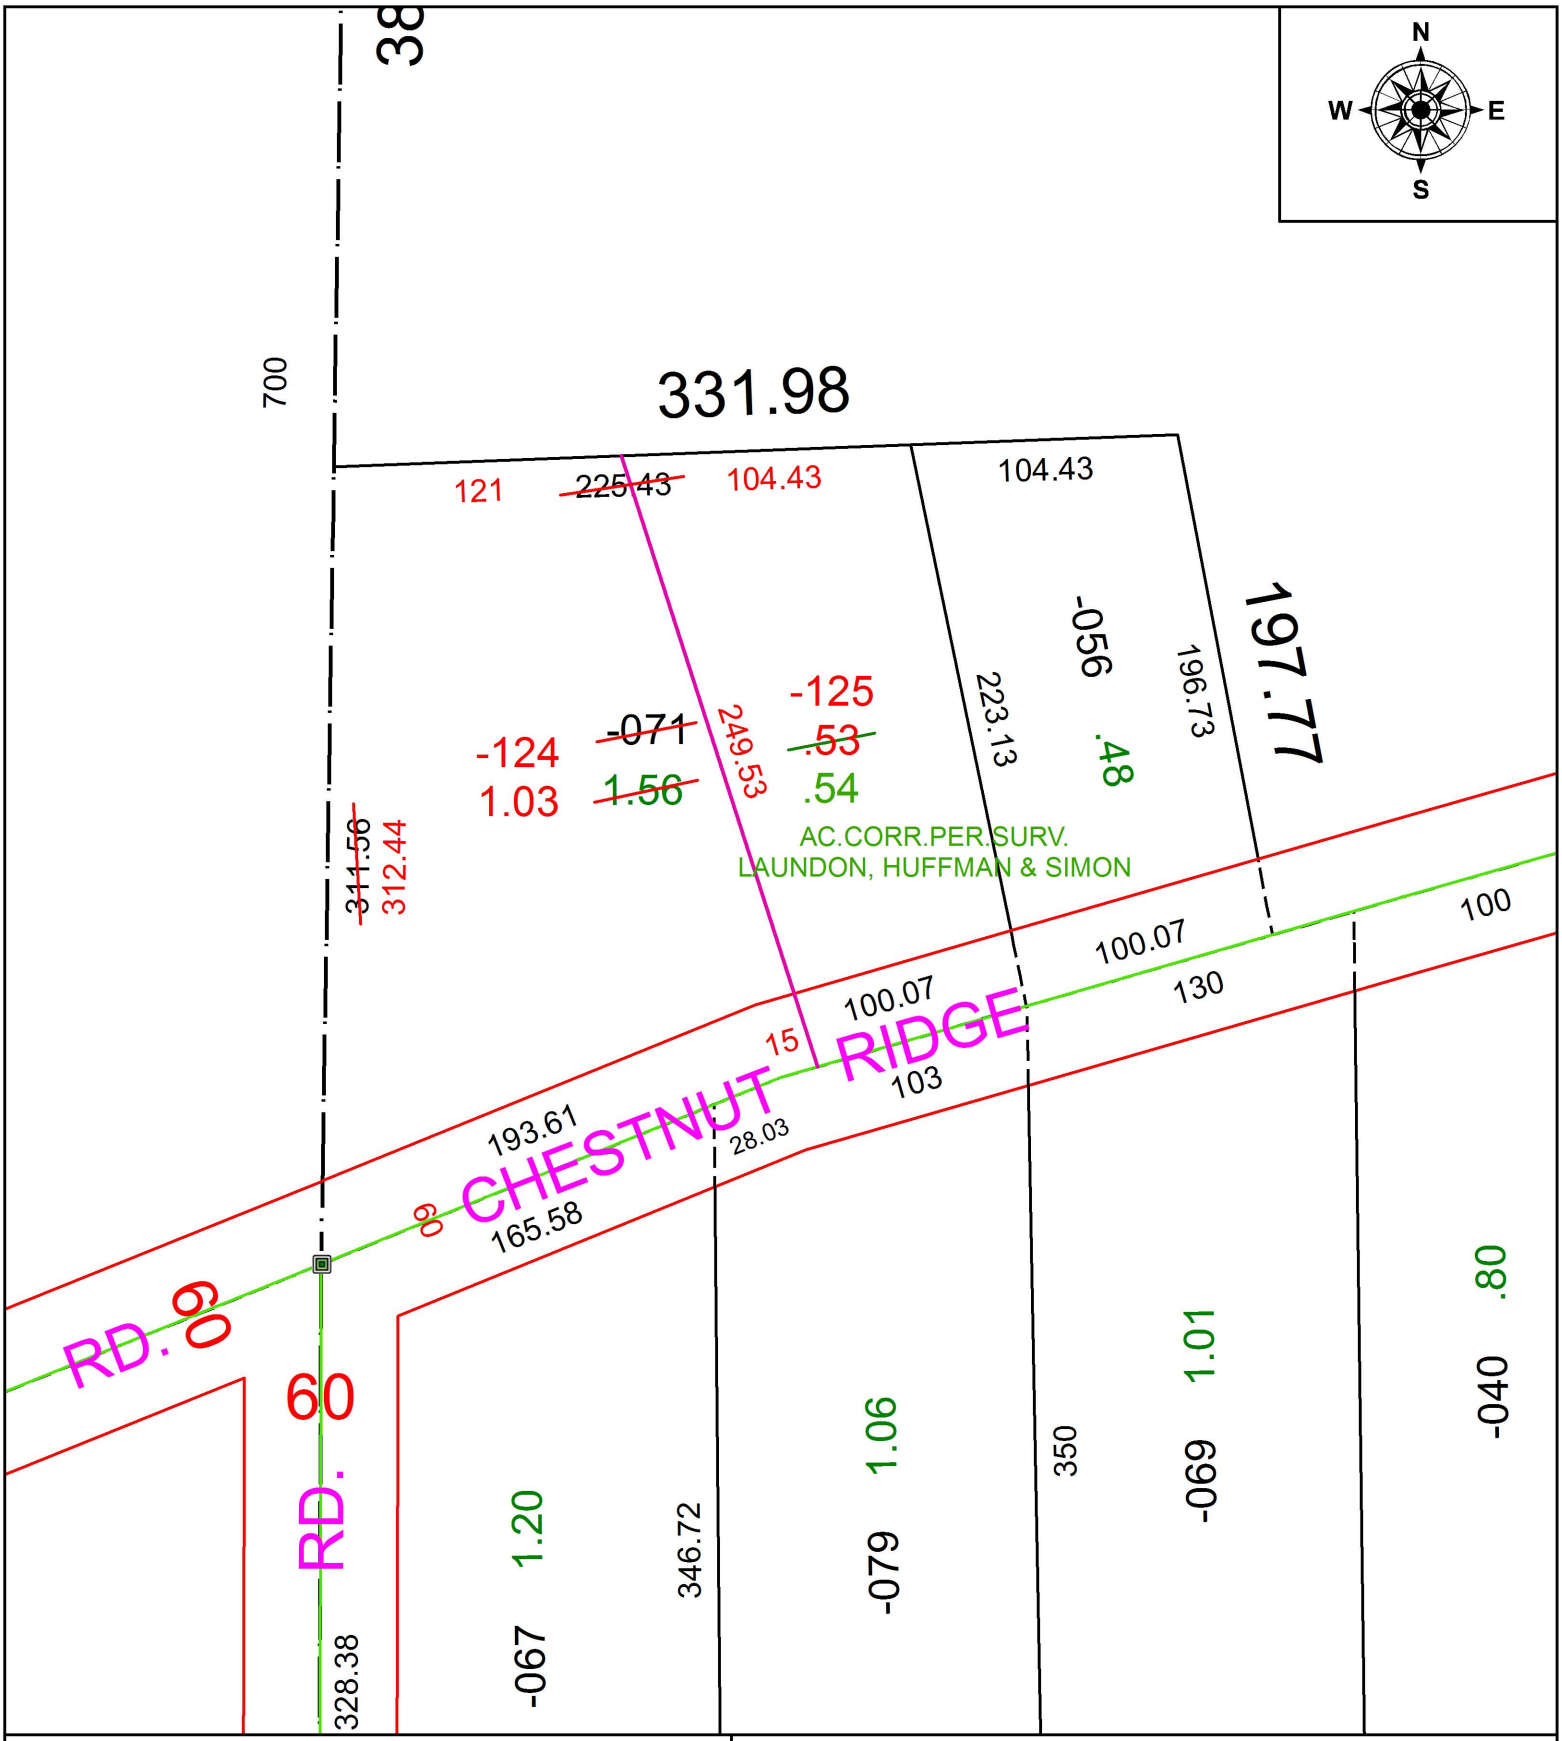

SPLITS/DEEDS PROCESSED

LORAIN COUNTY TAX MAP DEPARTMENT
226 MIDDLE AVE. ELYRIA, OH

SURVEYED BY: LAUNDON, HUFFMAN & SIMON
CLOSURE: 1:231,615
MAP PAGE(S): 11-00-071
APPOVED BY: RRM **DATE:** 2-26-20
SCALE: 1" = 75 **PRIOR INSTRUMENT:** 20050069904