PARENT PARCEL: 15-00-054-000-039, -040

CHILD PARCEL: 15-00-054-000-041 THRU 15-00-054-000-043

STARTING POINT: INTERSECTION OF C/L OF WHEELER AND SR 303

21-04294

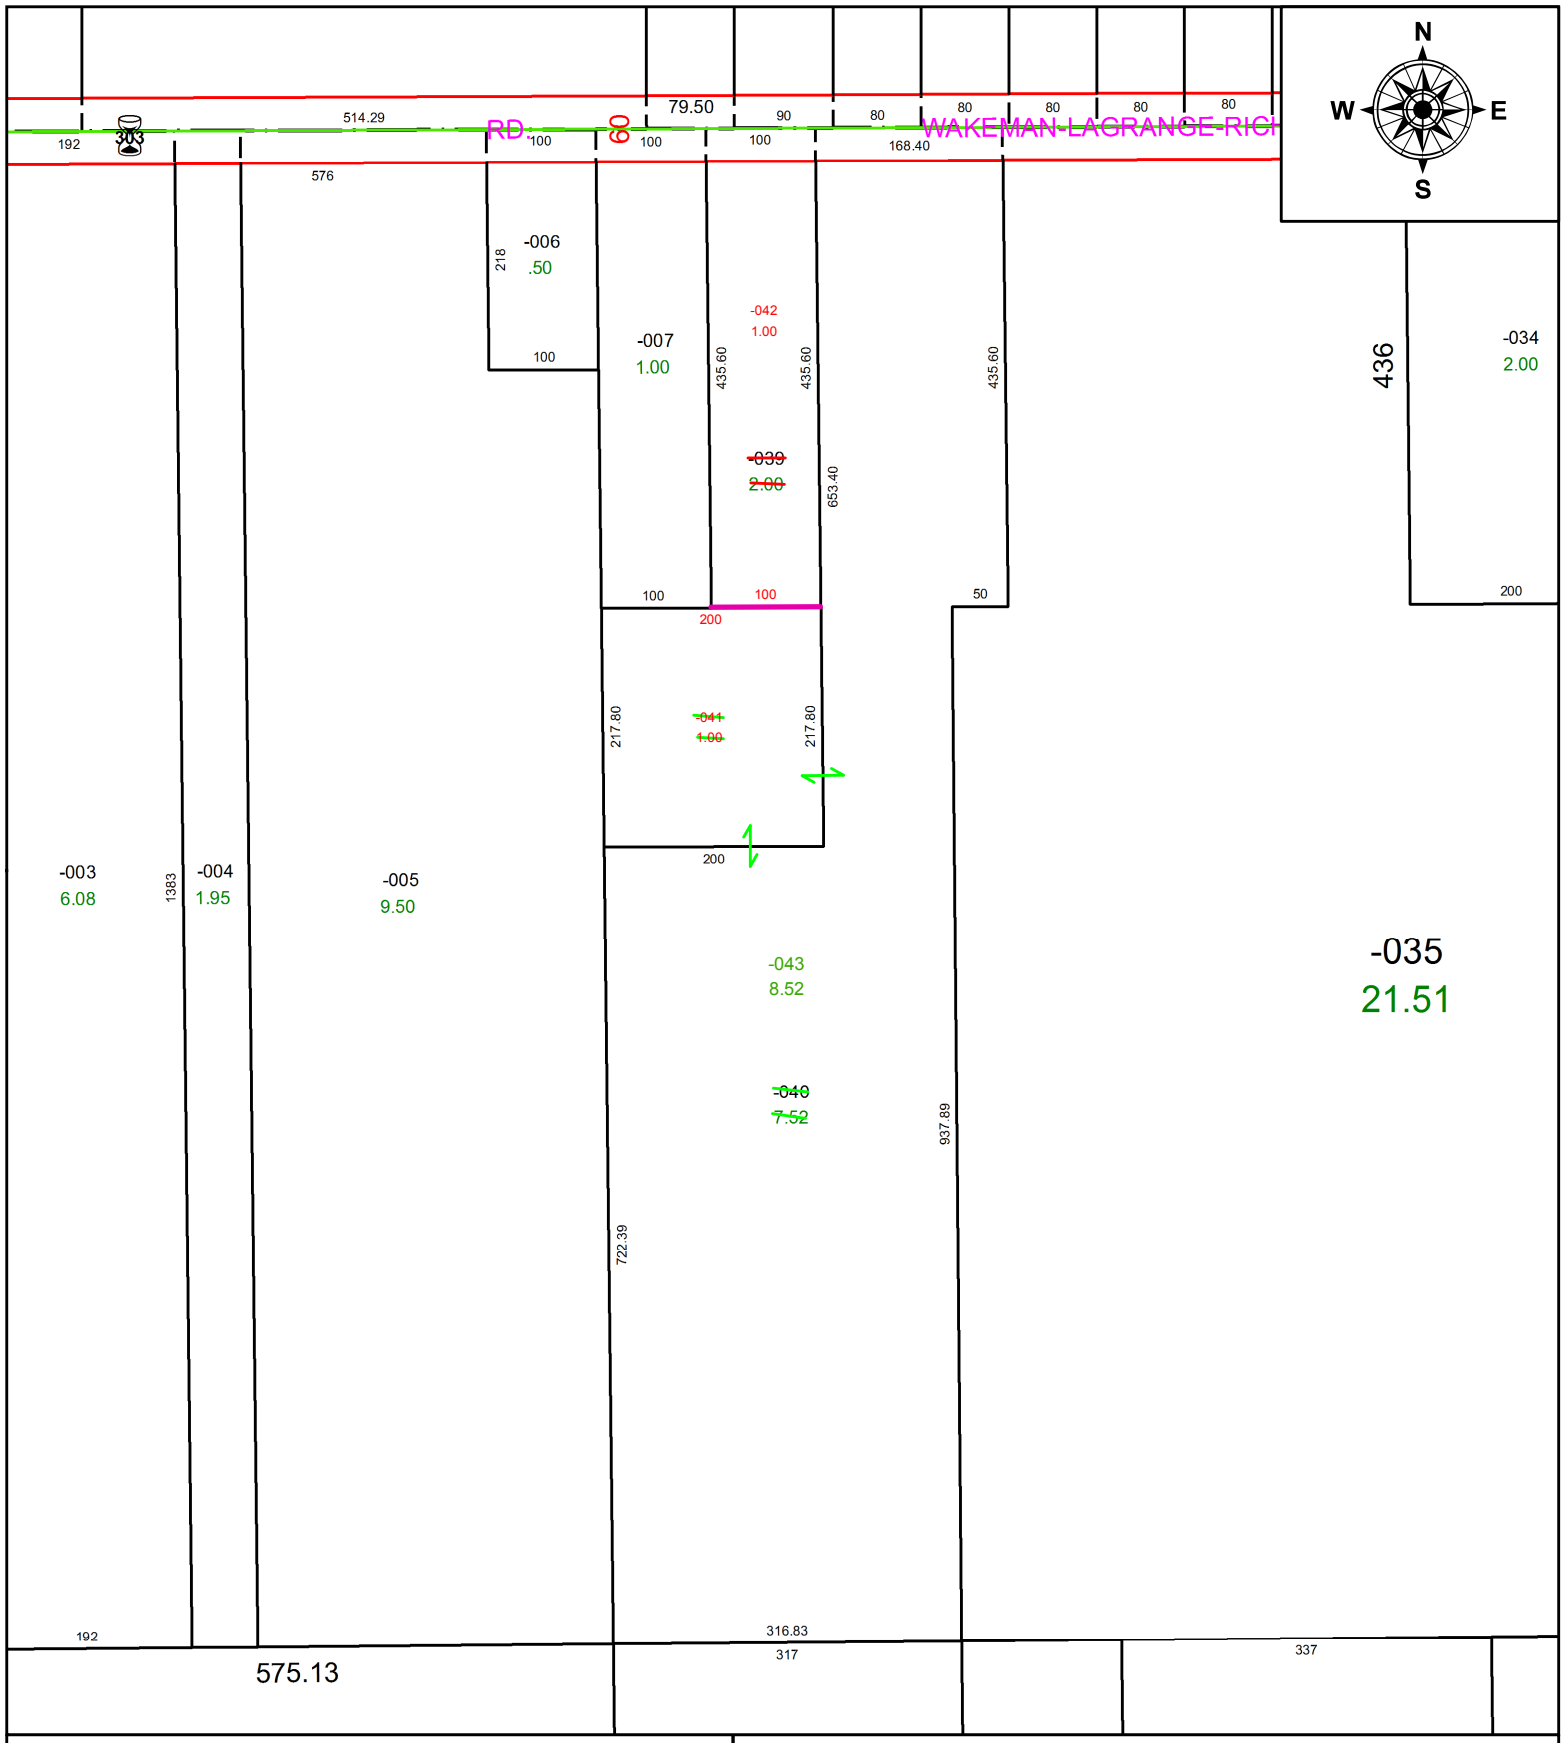

SPLITS/DEEDS PROCESSED

LORAIN COUNTY TAX MAP DEPARTMENT
226 MIDDLE AVE. ELYRIA, OH

SURVEYED BY: JOSHUA E. KAZMIERCZAK
CLOSURE: 1: 2147483648
MAP PAGE(S): 15-00-054-B
APPOVED BY: AC **DATE:** 5/6/2021
SCALE: 1" = 175 **PRIOR INSTRUMENT:** 2017-0641539