PARENT PARCEL: 01-00-043-000-018, -045, -035

CHILD PARCEL: 01-00-043-000-077 THRU -082

STARTING POINT: MONUMENT BOX AT SOUTHEAST CORNER OF OL 43 & C/L OF BAUMHART RD

21-04296

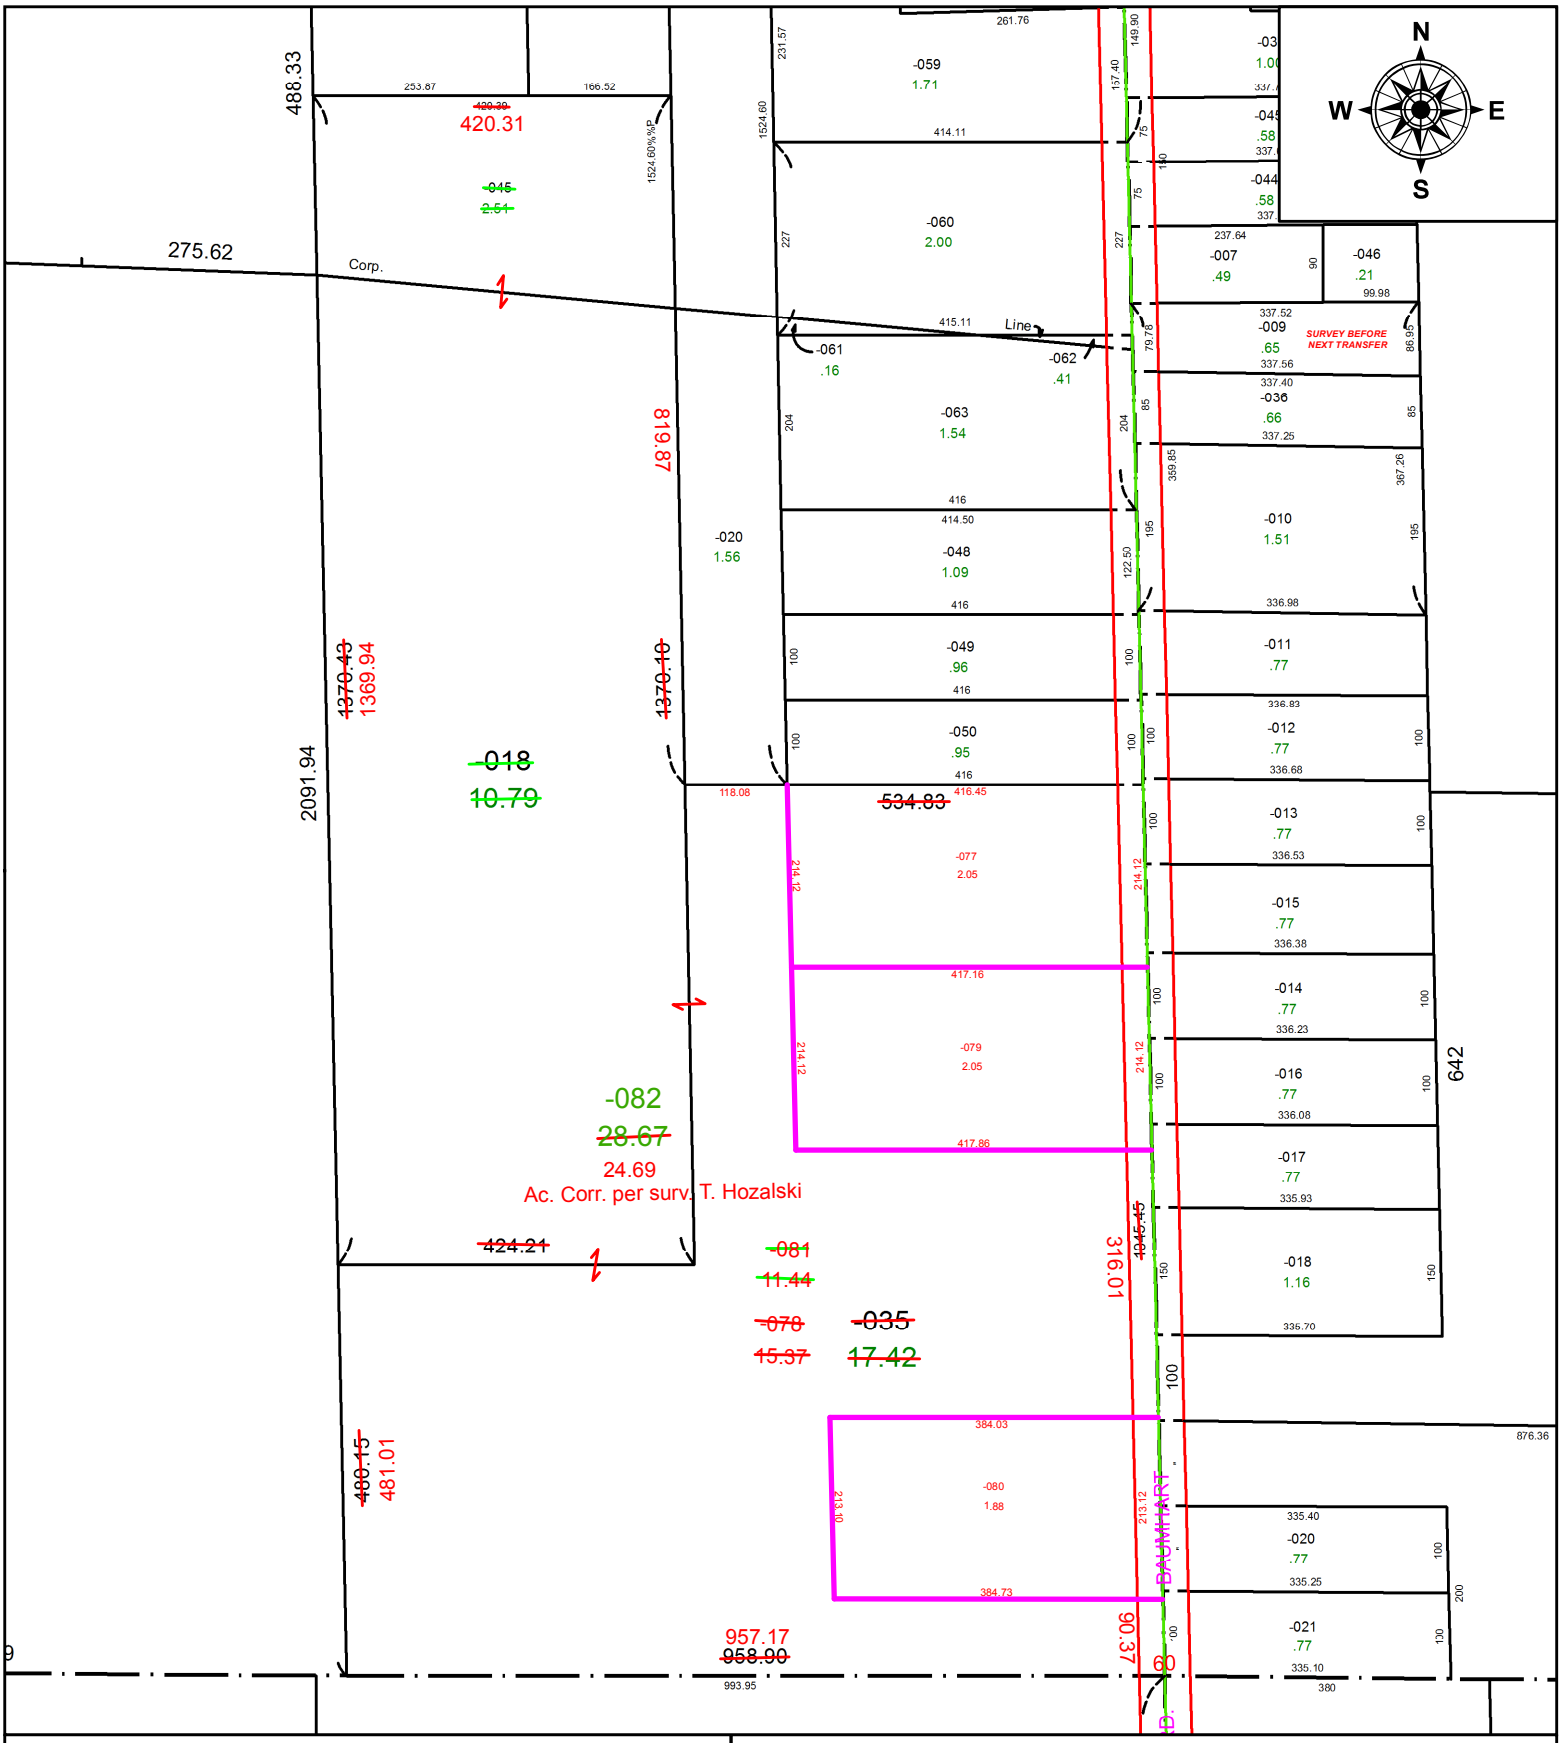

SPLITS/DEEDS PROCESSED

LORAIN COUNTY TAX MAP DEPARTMENT
226 MIDDLE AVE. ELYRIA, OH

SURVEYED BY: TIMOTHY D. HOZALSKI
CLOSURE: 1:350,147
MAP PAGE(S): 1-00-043
APPOVED BY: WRZ **DATE:** 5-7-21
SCALE: 1" = 225 **PRIOR INSTRUMENT:** 2021-0809786