**PARENT PARCEL:** 07-00-003-102-048, -049
**CHILD PARCEL:** 07-00-003-102-102 THRU -104
**STARTING POINT:** C/L OF LORAIN AND COOK ROAD

21-04298

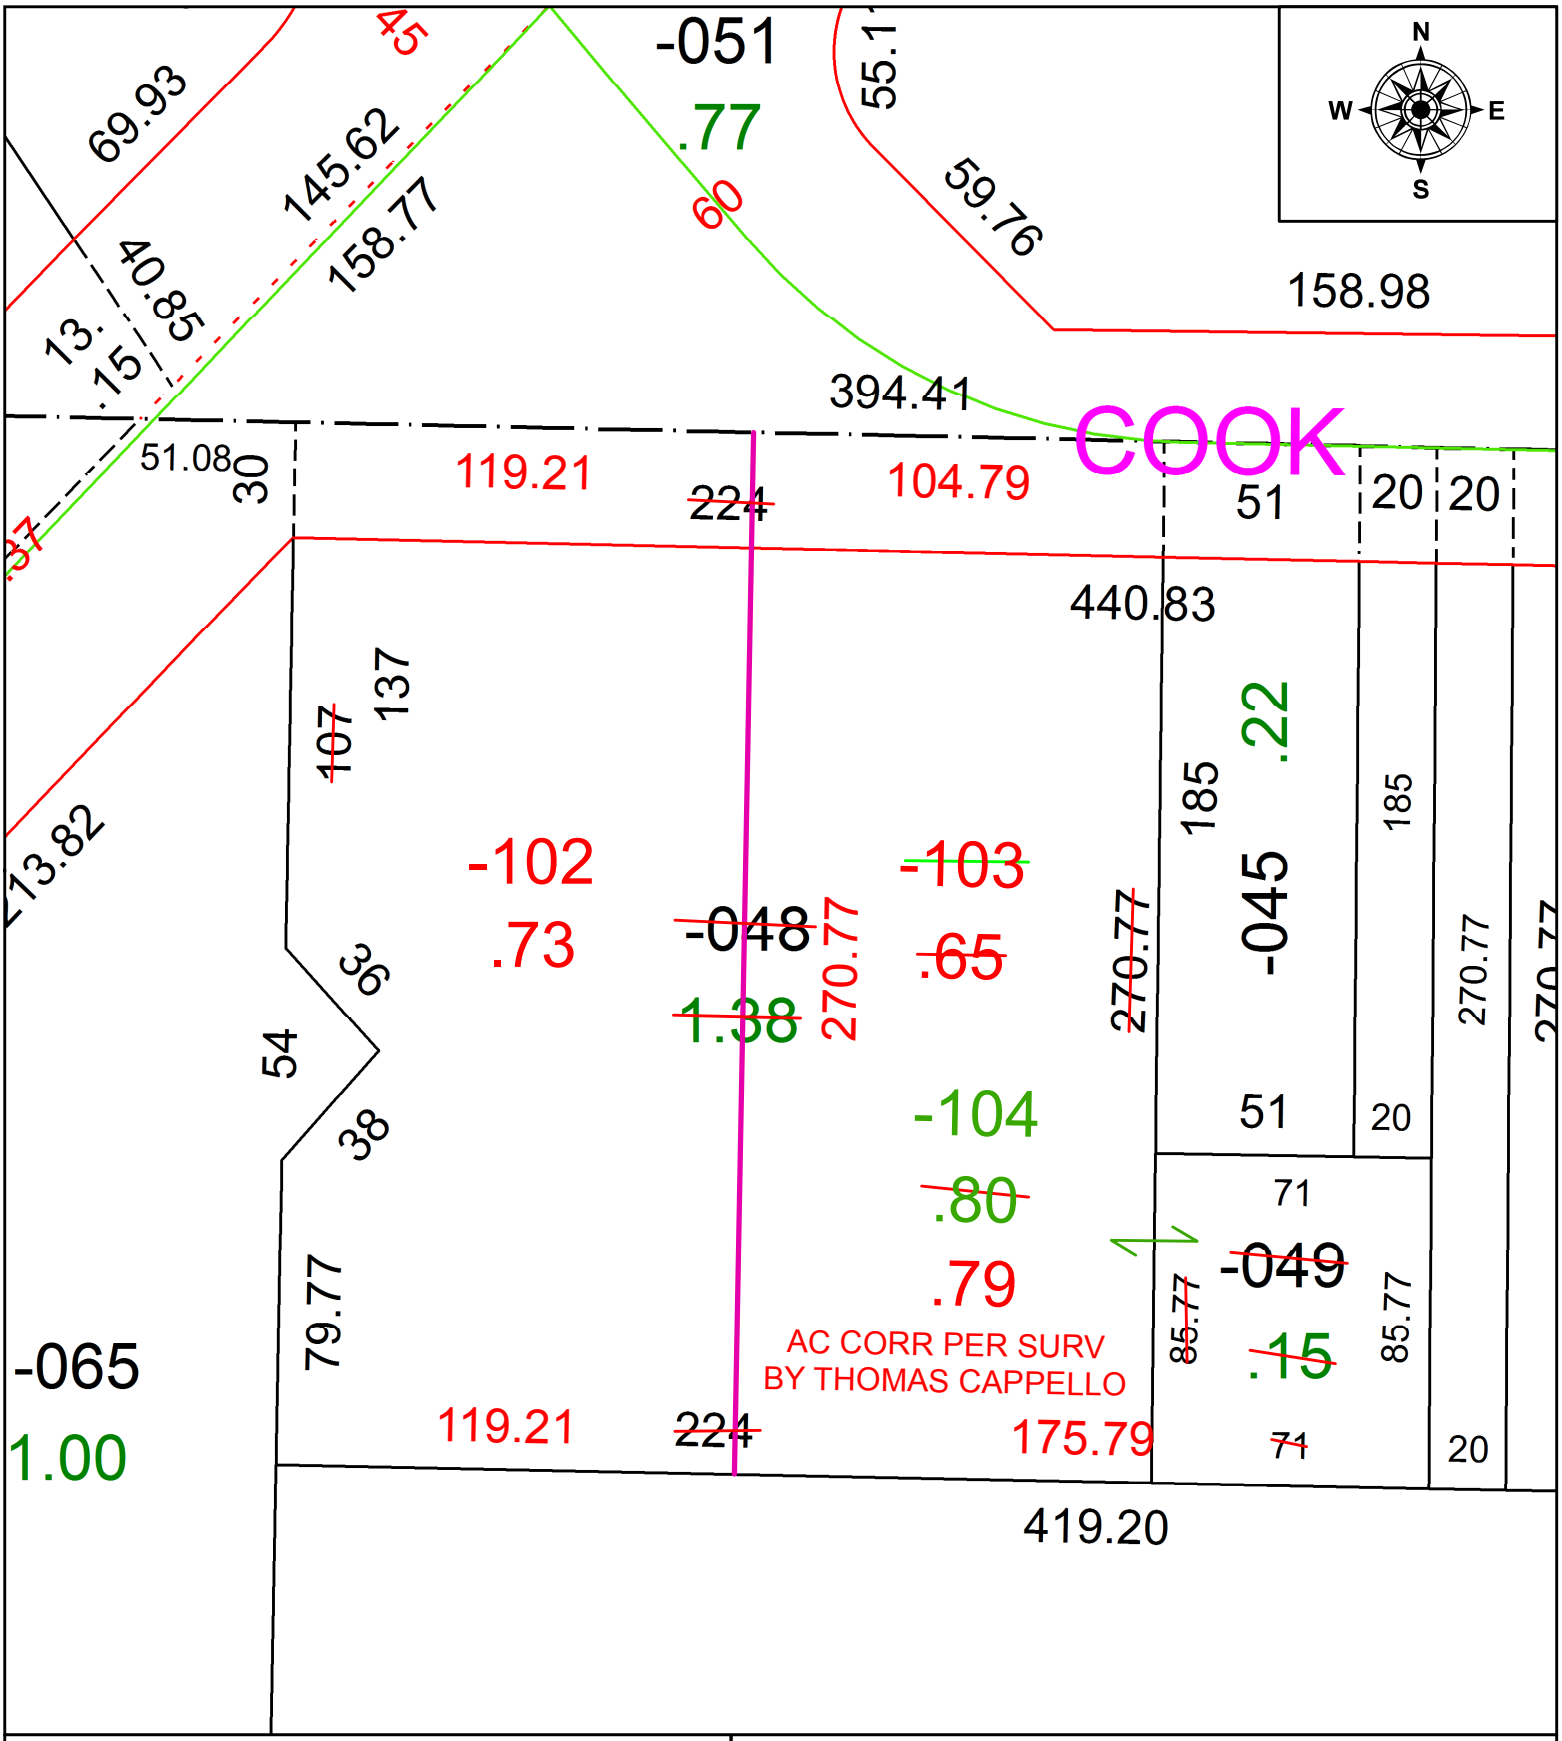


**SPLITS/DEEDS PROCESSED**
LORAIN COUNTY TAX MAP DEPARTMENT
226 MIDDLE AVE. ELYRIA, OH

**SURVEYED BY:** THOMAS CAPPELLO
**CLOSURE:** 1: 2147483648
**MAP PAGE(S):** 07-00-003
**APPOVED BY:** AC **DATE:** 5/11/2021
**SCALE:** 1" = 50 **PRIOR INSTRUMENT:** 2016-0612813