PARENT PARCEL: 03-00-113-107-004, -005, -006, -035 & -047

CHILD PARCEL: 03-00-113-107-055 thru -064

STARTING POINT: CL OF NORTH RIDGE RD & GLANTZ DR.

21-04300

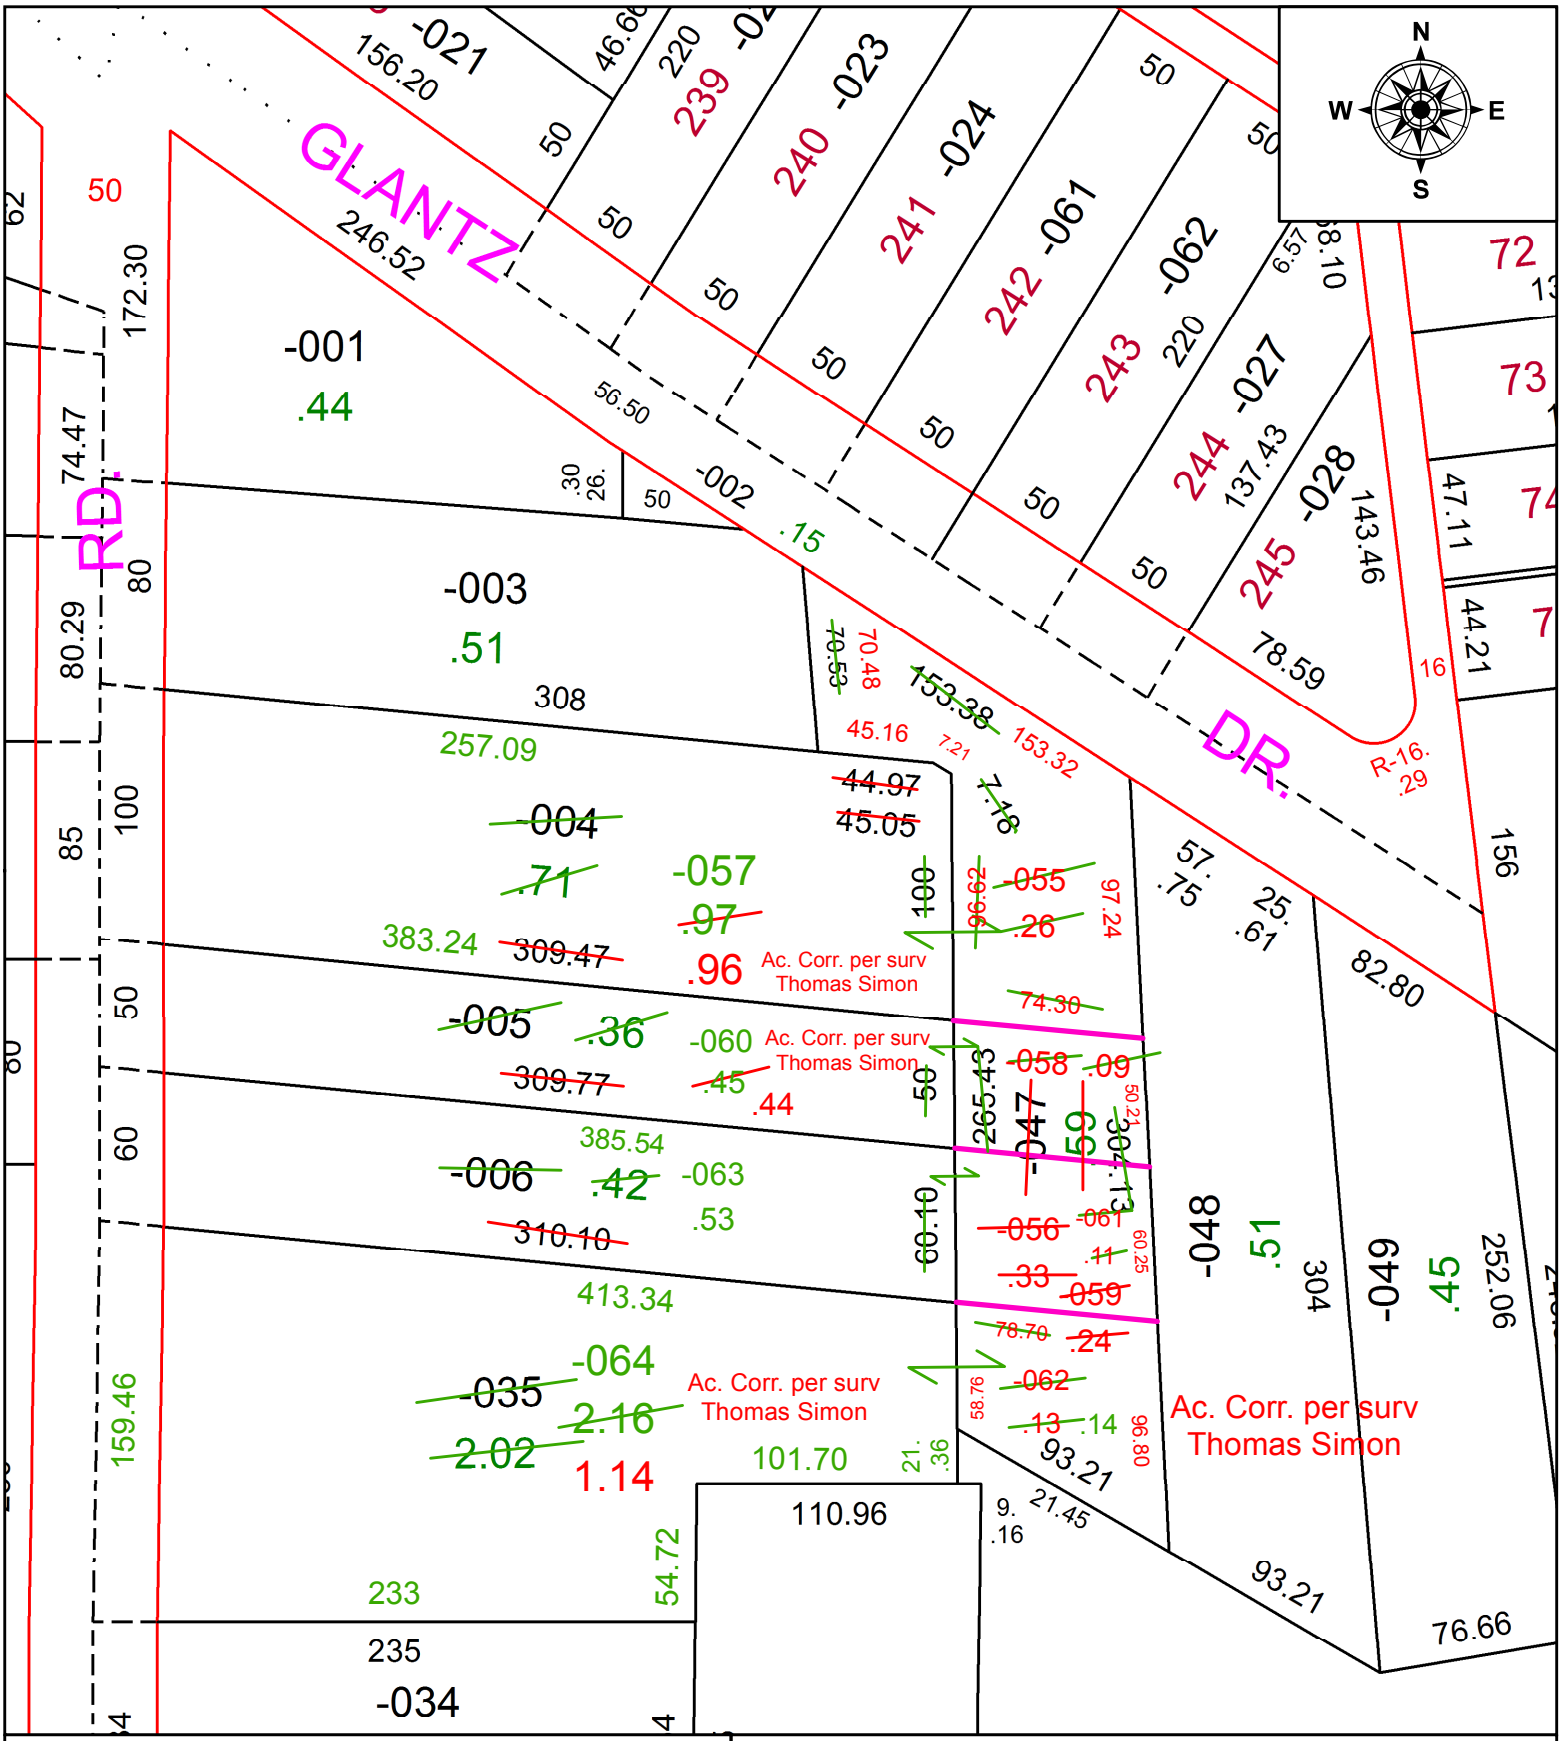

SPLITS/DEEDS PROCESSED

LORAIN COUNTY TAX MAP DEPARTMENT
226 MIDDLE AVE. ELYRIA, OH

SURVEYED BY: THOMAS SIMON
CLOSURE: 1: 105,450
MAP PAGE(S): 03-00-113
APPOVED BY: DMA **DATE:** 5/17/2021
SCALE: 1" = 75 **PRIOR INSTRUMENT:** 20040023026