PARENT PARCEL: 20-05-022-102-028 & -045

CHILD PARCEL: 20-05-022-102-050 THRU -052

STARTING POINT: S.E. CORNER OF ORIGINAL ROCHESTER TWP. LOT 22, TRACT 5

21-04301

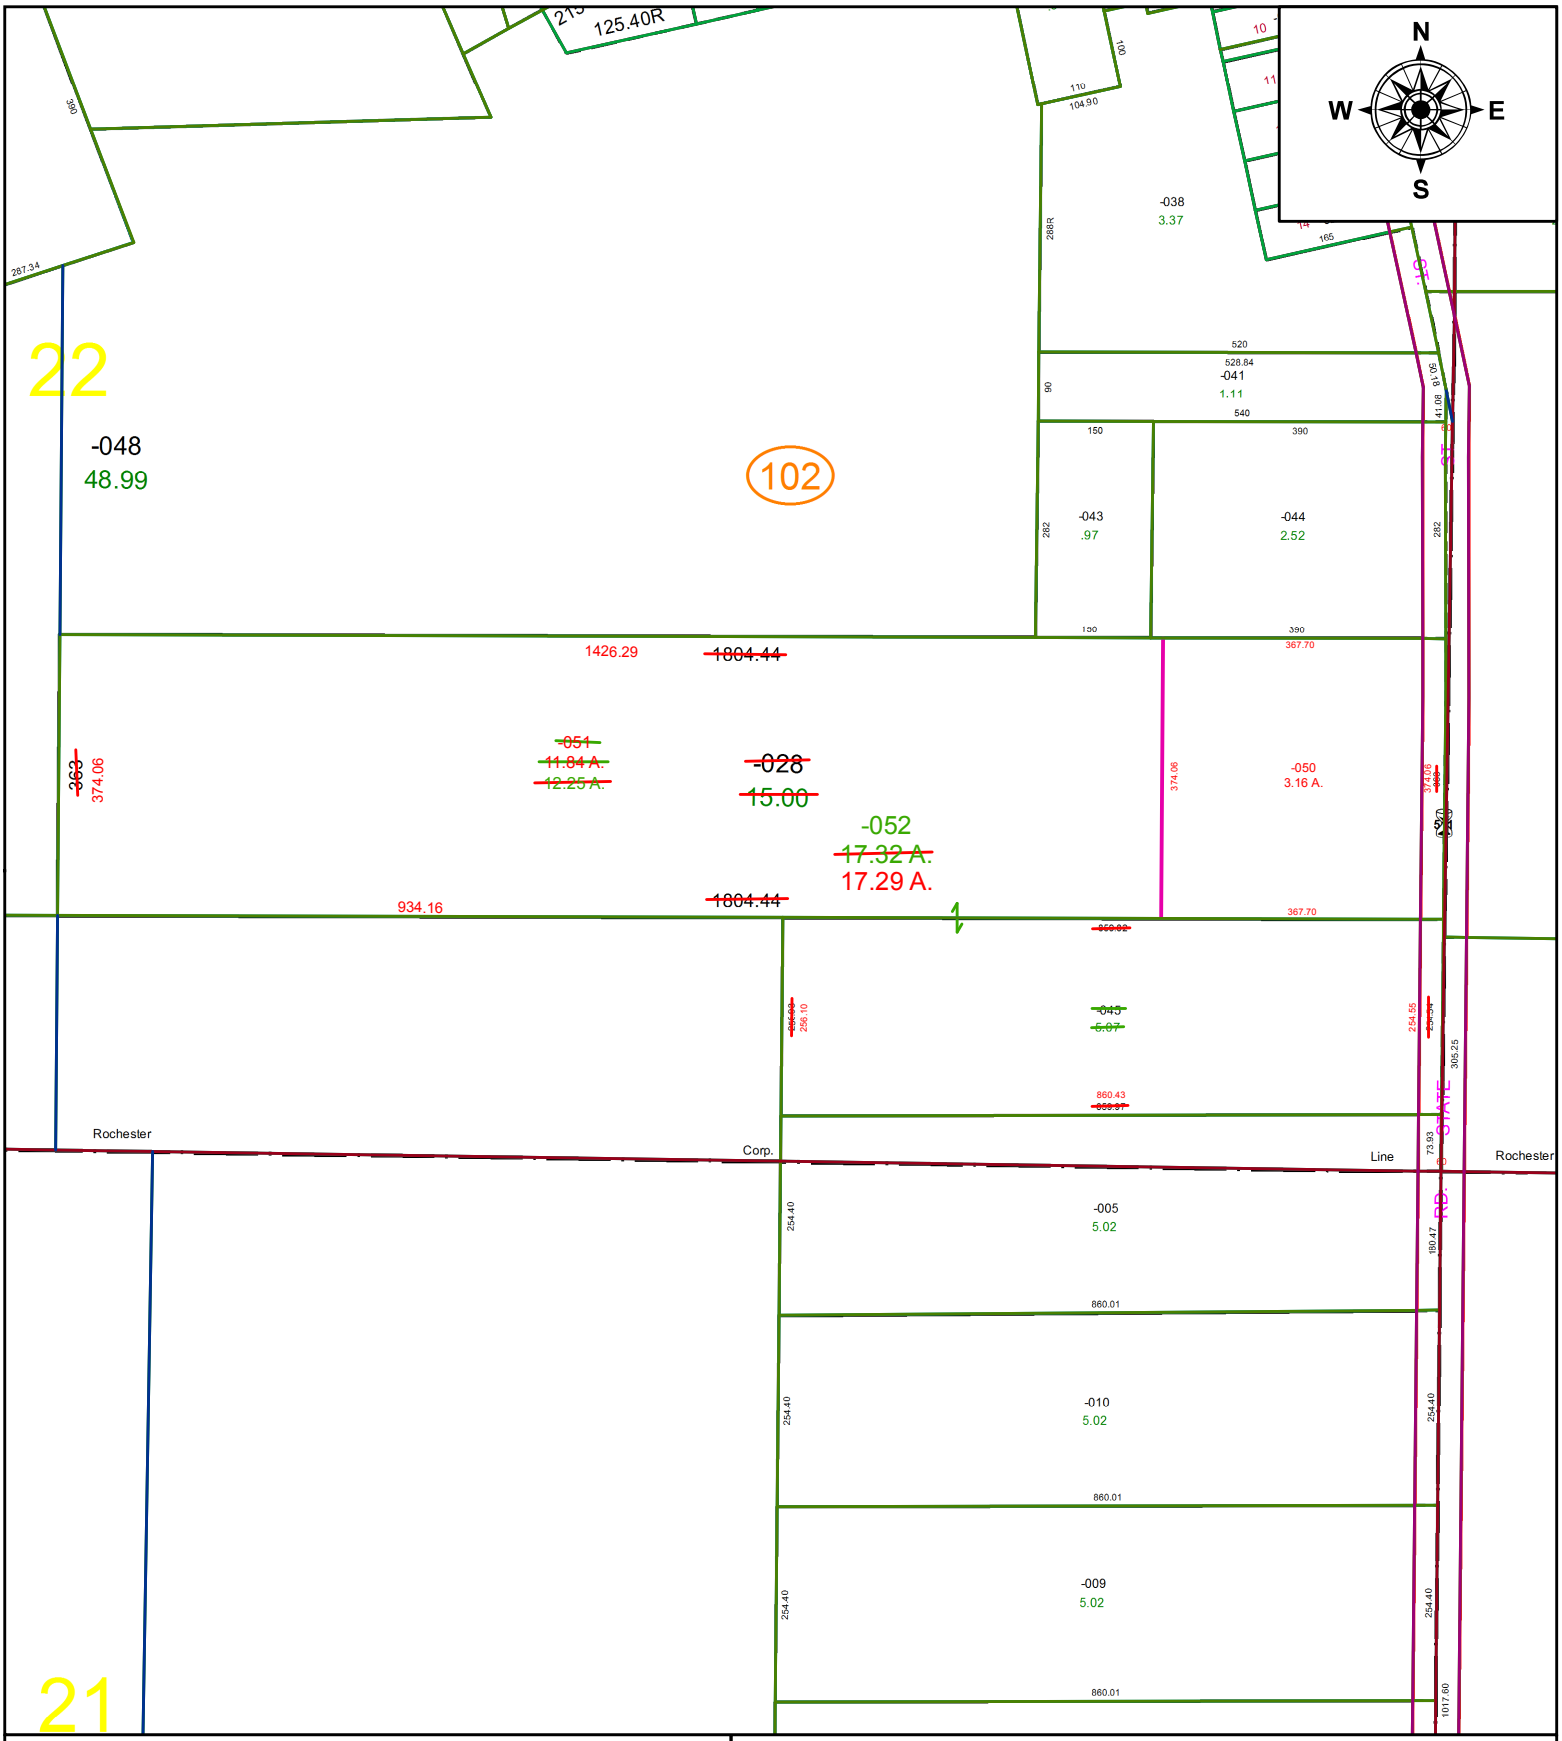

SPLITS/DEEDS PROCESSED

LORAIN COUNTY TAX MAP DEPARTMENT
226 MIDDLE AVE. ELYRIA, OH

SURVEYED BY: T. SIMON
CLOSURE: 1:547536
MAP PAGE(S): 20-05-022
APPOVED BY: TJS **DATE:** 5/18/2021
SCALE: 1" = 250' **PRIOR INSTRUMENT:** OR. 1000/274