PARENT PARCEL: 06-24-032-103-032, -033, & -045

CHILD PARCEL: 06-24-032-103-052

STARTING POINT: I.P. MON. BOX, CL OF GRISWOLD & CL OF LORAIN BLVD. (S.R. 57)

21-04303

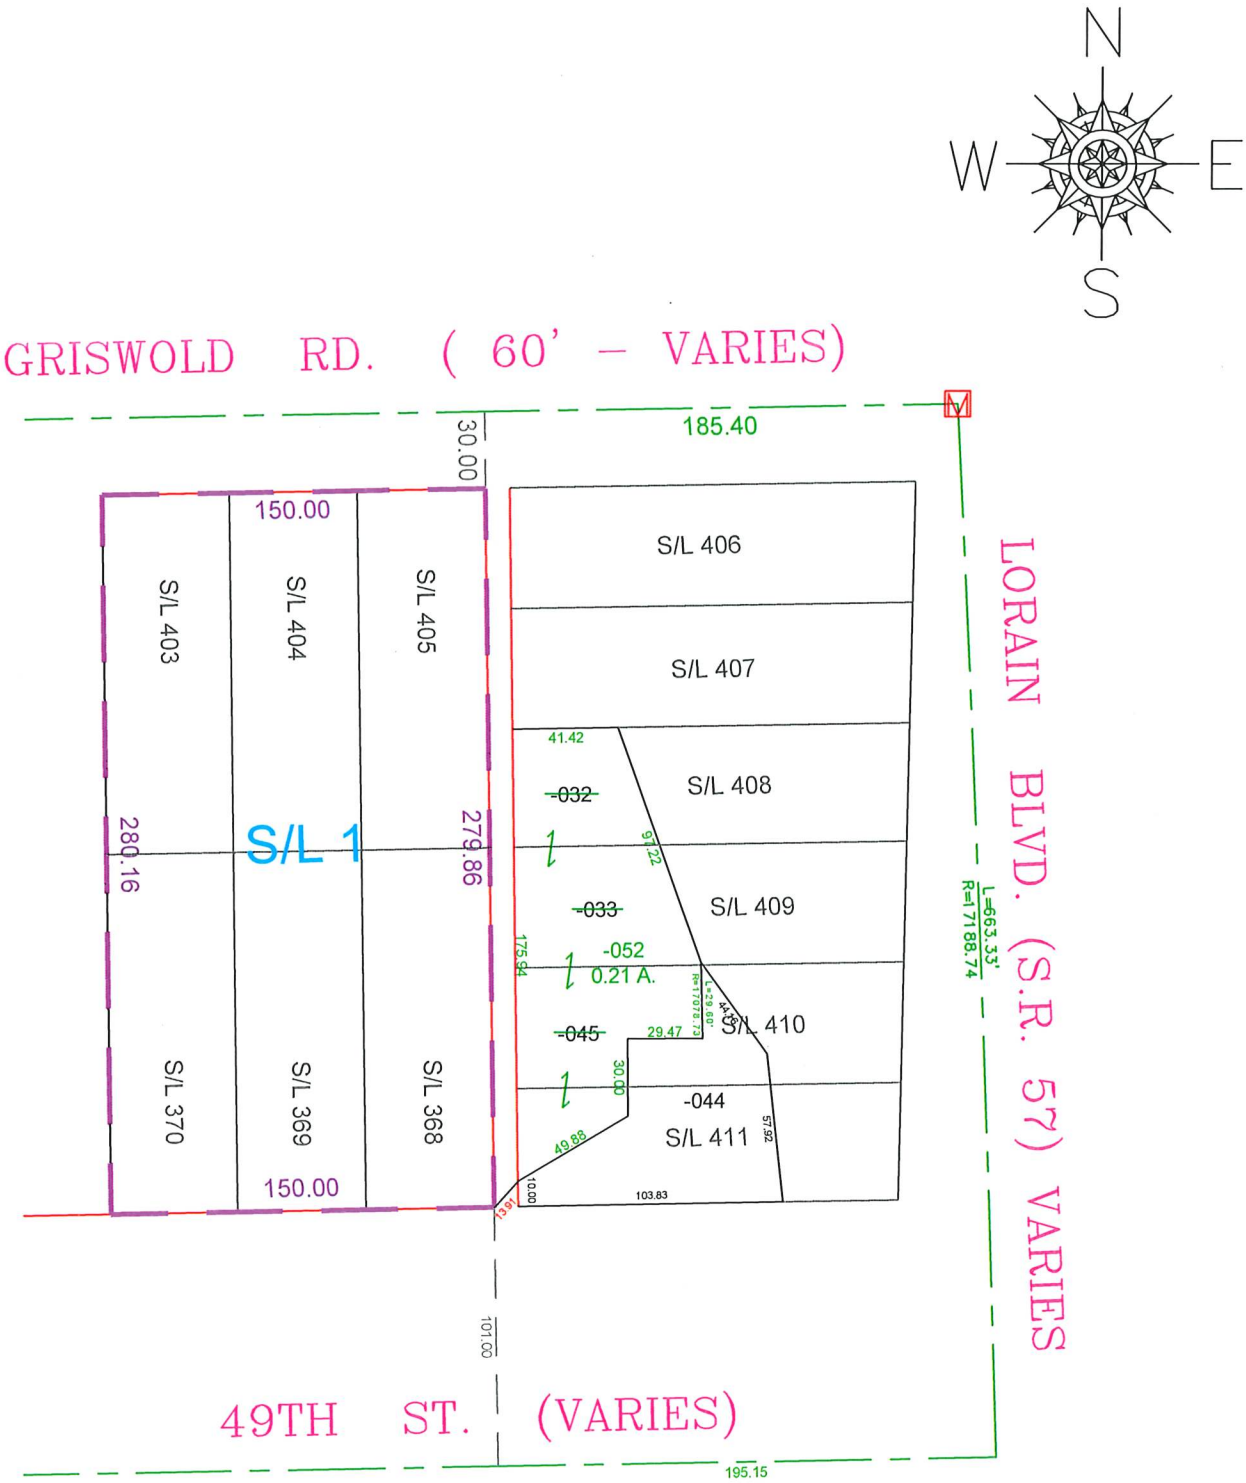

SPLITS/DEEDS PROCESSED

LORAIN COUNTY TAX MAP DEPARTMENT
226 MIDDLE AVE. ELYRIA, OHIO

SURVEYED BY: STEVEN J. METCALF

CLOSURE: XXXXXX

MAP PAGE(S): 06-24-032

APPROVED BY: TJS DATE: 5/17/2021

SCALE: 1"= 75' PRIOR INST.: 2019-0742370