PARENT PARCEL: 04-00-008-104-189 & -191

CHILD PARCEL: 04-00-008-104-195 THRU -197

STARTING POINT: CENTERLINE OF WEBBER RD. & CENTERLINE OV AVON-BELDEN RD. (S.R. 83)

21-04306

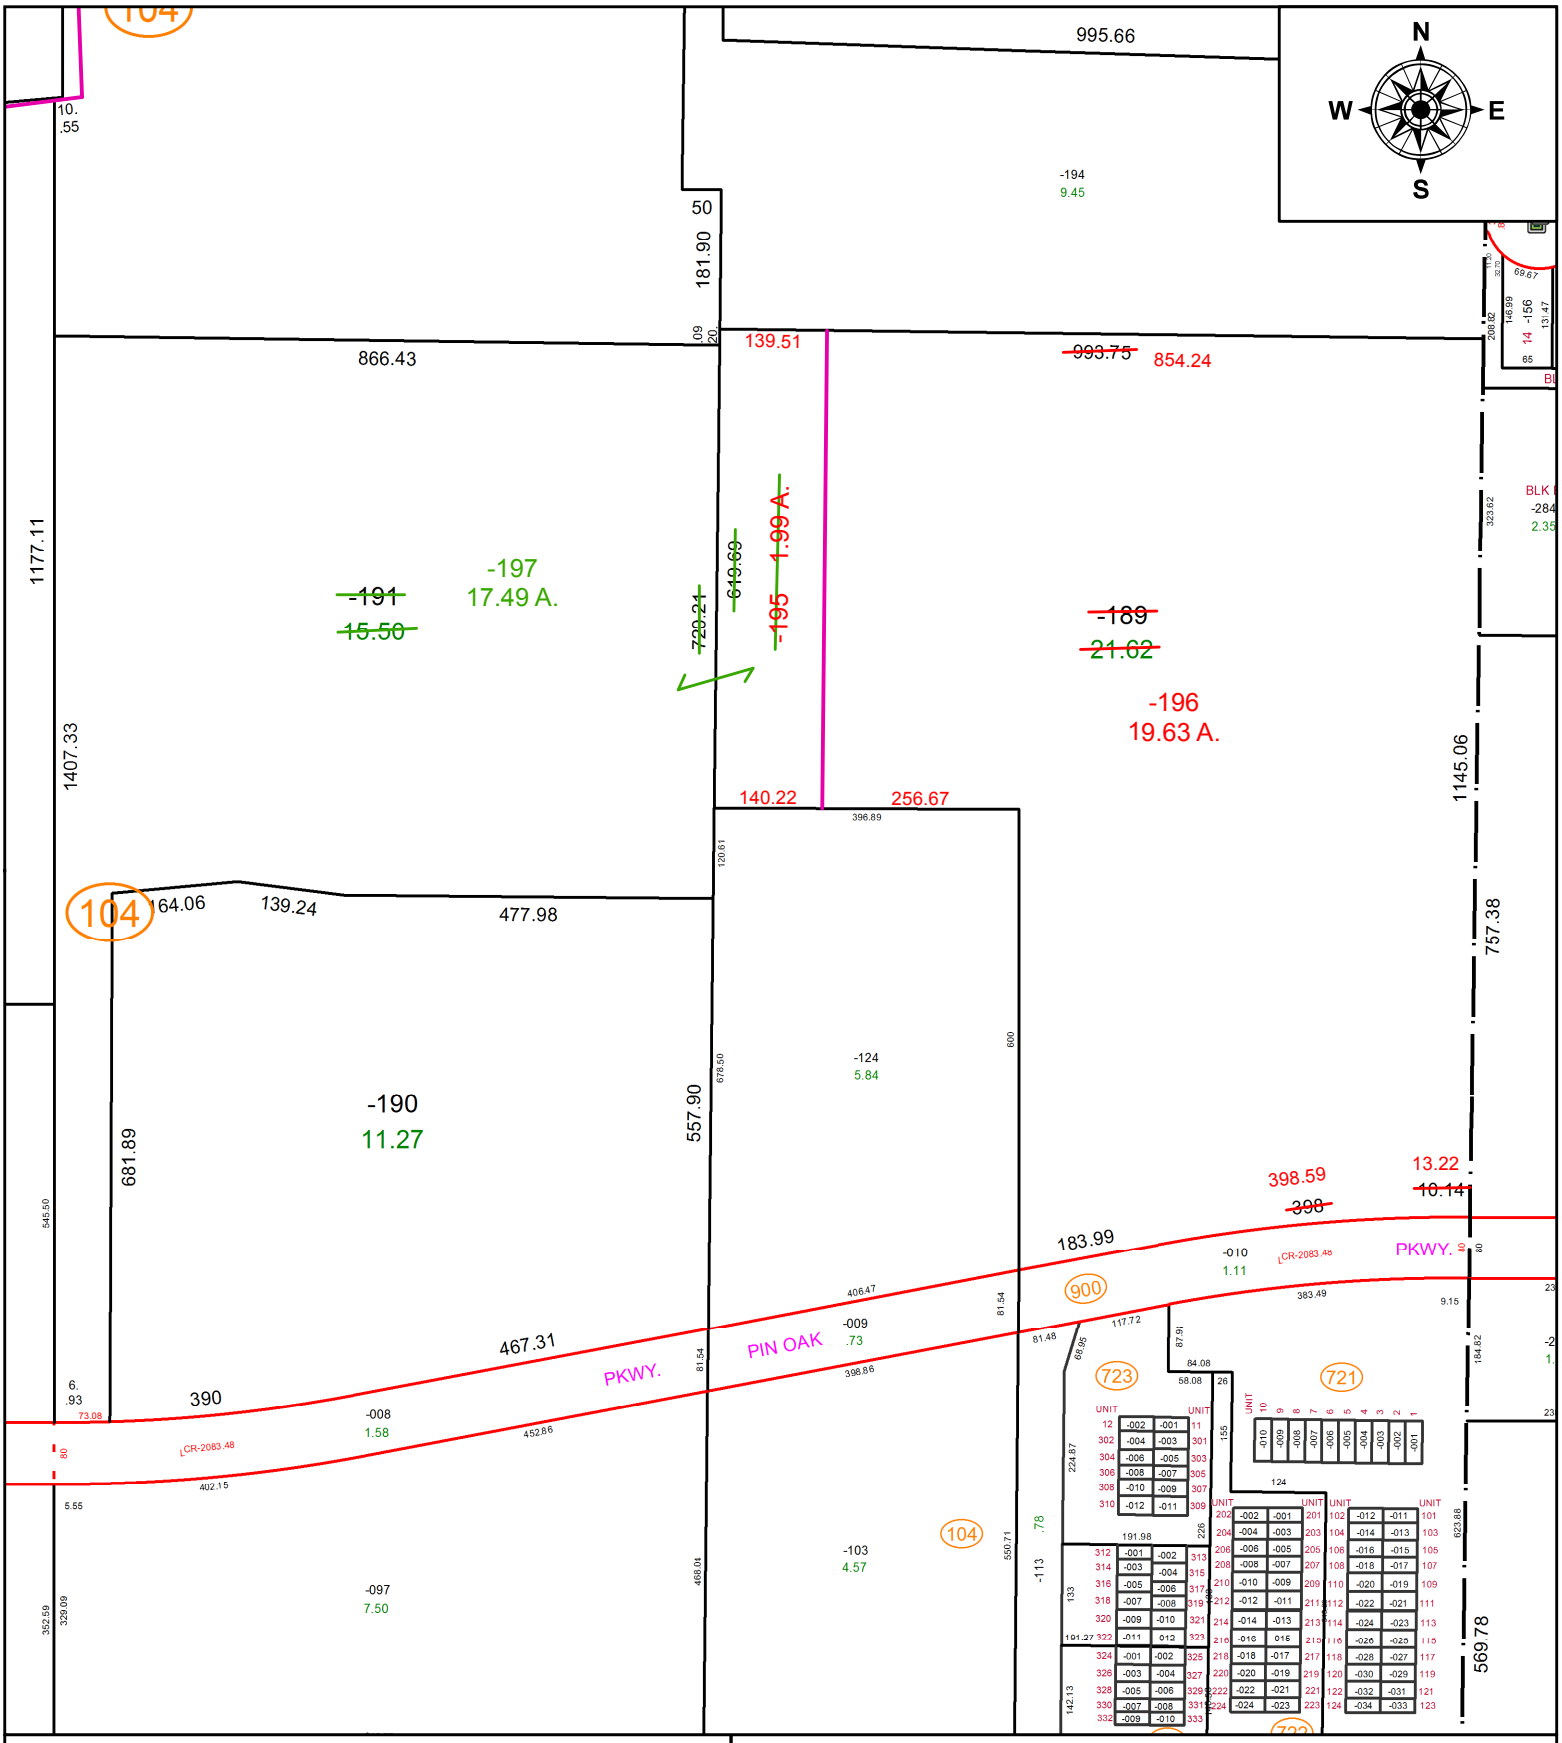

SPLITS/DEEDS PROCESSED

LORAIN COUNTY TAX MAP DEPARTMENT
226 MIDDLE AVE. ELYRIA, OH

SURVEYED BY: JAMES T. SAYLER

CLOSURE: 1: 33,000

MAP PAGE(S): 04-00-008

APPOVED BY: TJS **DATE:** 6/2/2021

SCALE: 1" = 250' **PRIOR INSTRUMENT:** 2014-000342