PARENT PARCEL: 16-00-080-000-019

CHILD PARCEL:

STARTING POINT: NORTHEAST CORNER OF O.L.80

20-04310-A

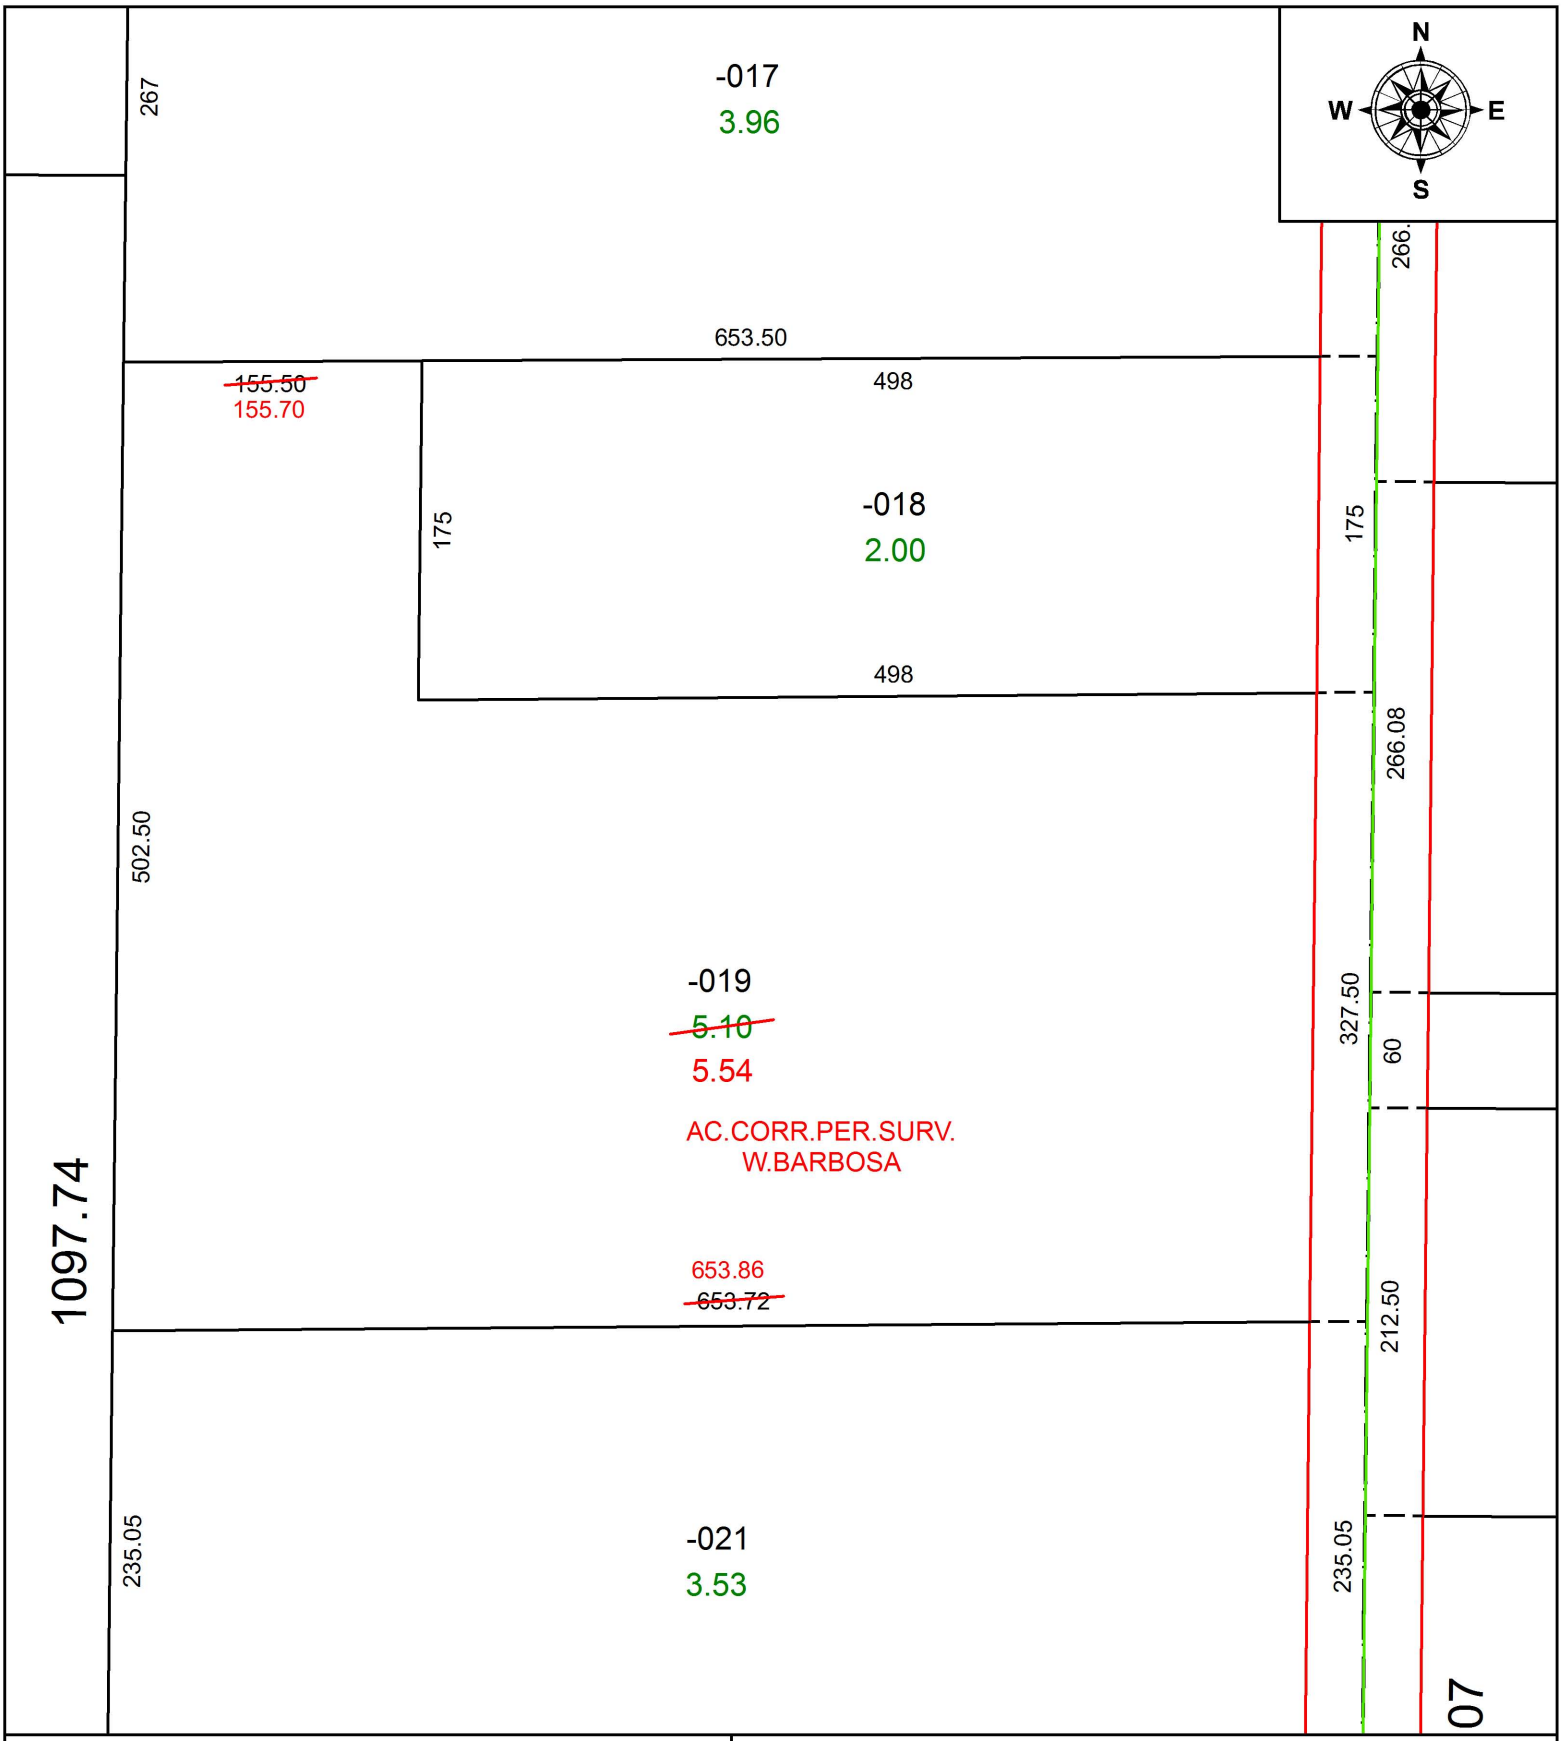

SPLITS/DEEDS PROCESSED

LORAIN COUNTY TAX MAP DEPARTMENT
226 MIDDLE AVE. ELYRIA, OH

SURVEYED BY: WILFREDO BARBOSA
CLOSURE: 1:253,094
MAP PAGE(S): 16-00-080
APPOVED BY: RRM **DATE:** 3-27-20
SCALE: 1" = 100 **PRIOR INSTRUMENT:** 20200747712