PARENT PARCEL: 06-21-003-101-038, 06-21-004102-028, -029

CHILD PARCEL: 06-21-003-101-038, 06-21-004-102-030 THRU -032

STARTING POINT: INTERSECTION OF C/L LAKE AVE & C/L MURRAY RIDGE RD

21-04312

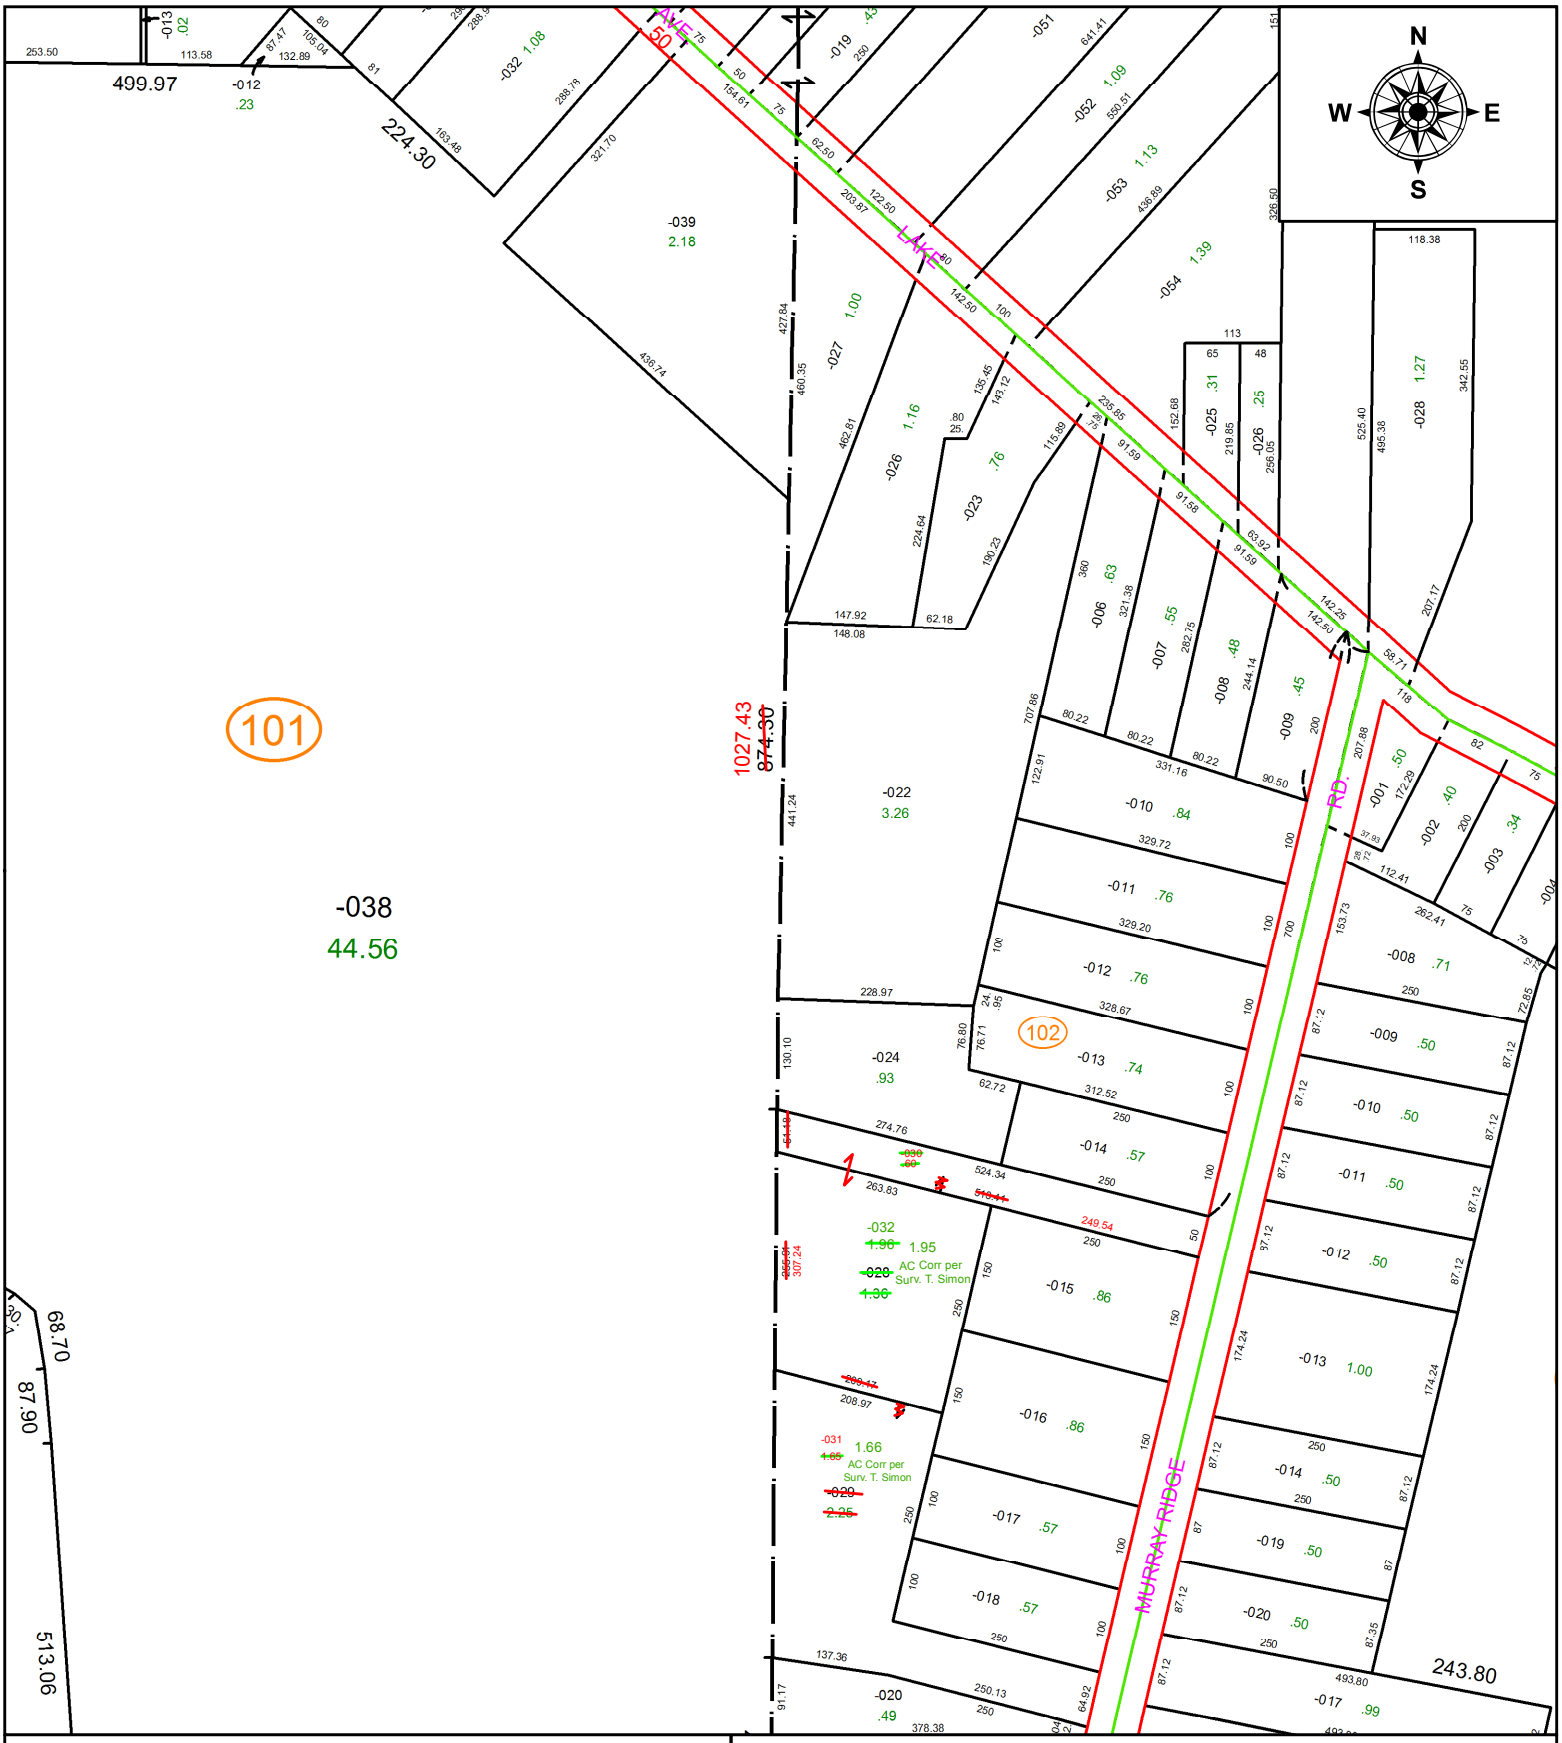

SPLITS/DEEDS PROCESSED

LORAIN COUNTY TAX MAP DEPARTMENT
226 MIDDLE AVE. ELYRIA, OH

SURVEYED BY: THOMAS SIMON
CLOSURE: 1: 400,289
MAP PAGE(S): 06-21-004
APPOVED BY: WRZ **DATE:** 6-7-2021
SCALE: 1" = 225 **PRIOR INSTRUMENT:** 2014-0510482