**PARENT PARCEL:** 13-11-025-000-014, -016, -020

**CHILD PARCEL:** 13-11-025-000-016, -022

**STARTING POINT:** INTERSECTION OF C/L SR 511 & NORTHWESTERLY CORNER OF OL 26

# 21-04315

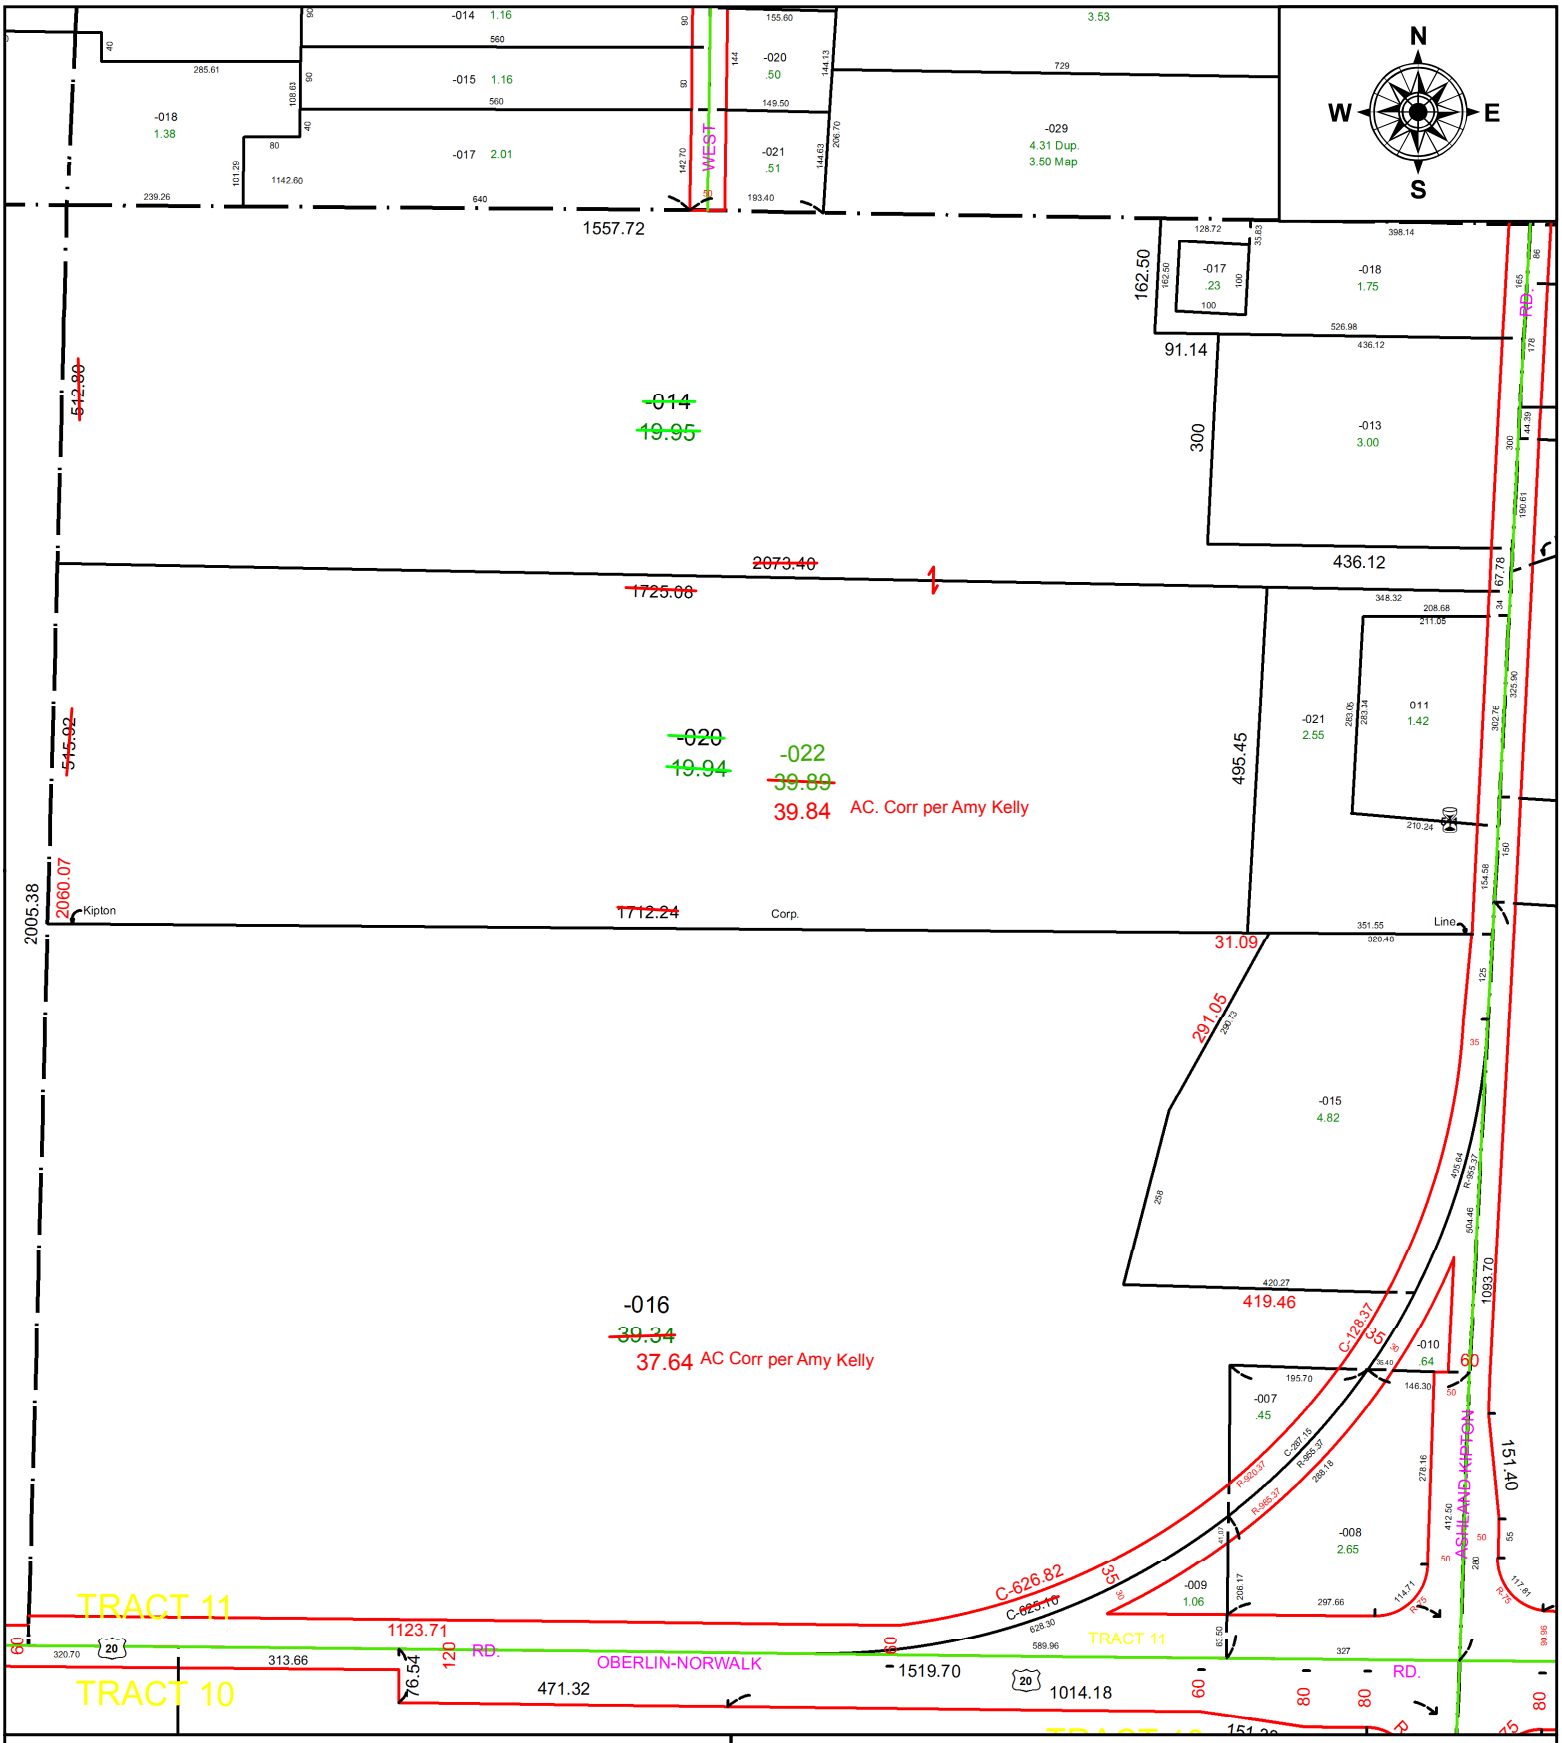


**SPLITS/DEEDS PROCESSED**

LORAIN COUNTY TAX MAP DEPARTMENT
226 MIDDLE AVE. ELYRIA, OH

**SURVEYED BY:** AMY KELLY
**CLOSURE:** 1: 798,357
**MAP PAGE(S):** 13-11-025
**APPOVED BY:** WRZ **DATE:** 6-10-2021
**SCALE:** 1" = 275 **PRIOR INSTRUMENT:** 2021-0810887