PARENT PARCEL: 10-00-006-118-026

CHILD PARCEL:

STARTING POINT: INTERSECTION OF C/L OF BUTTERNUT RIDGE RD. AND WEST LINE OF TOWN PLAT OF LAPORTE

20-04316-D

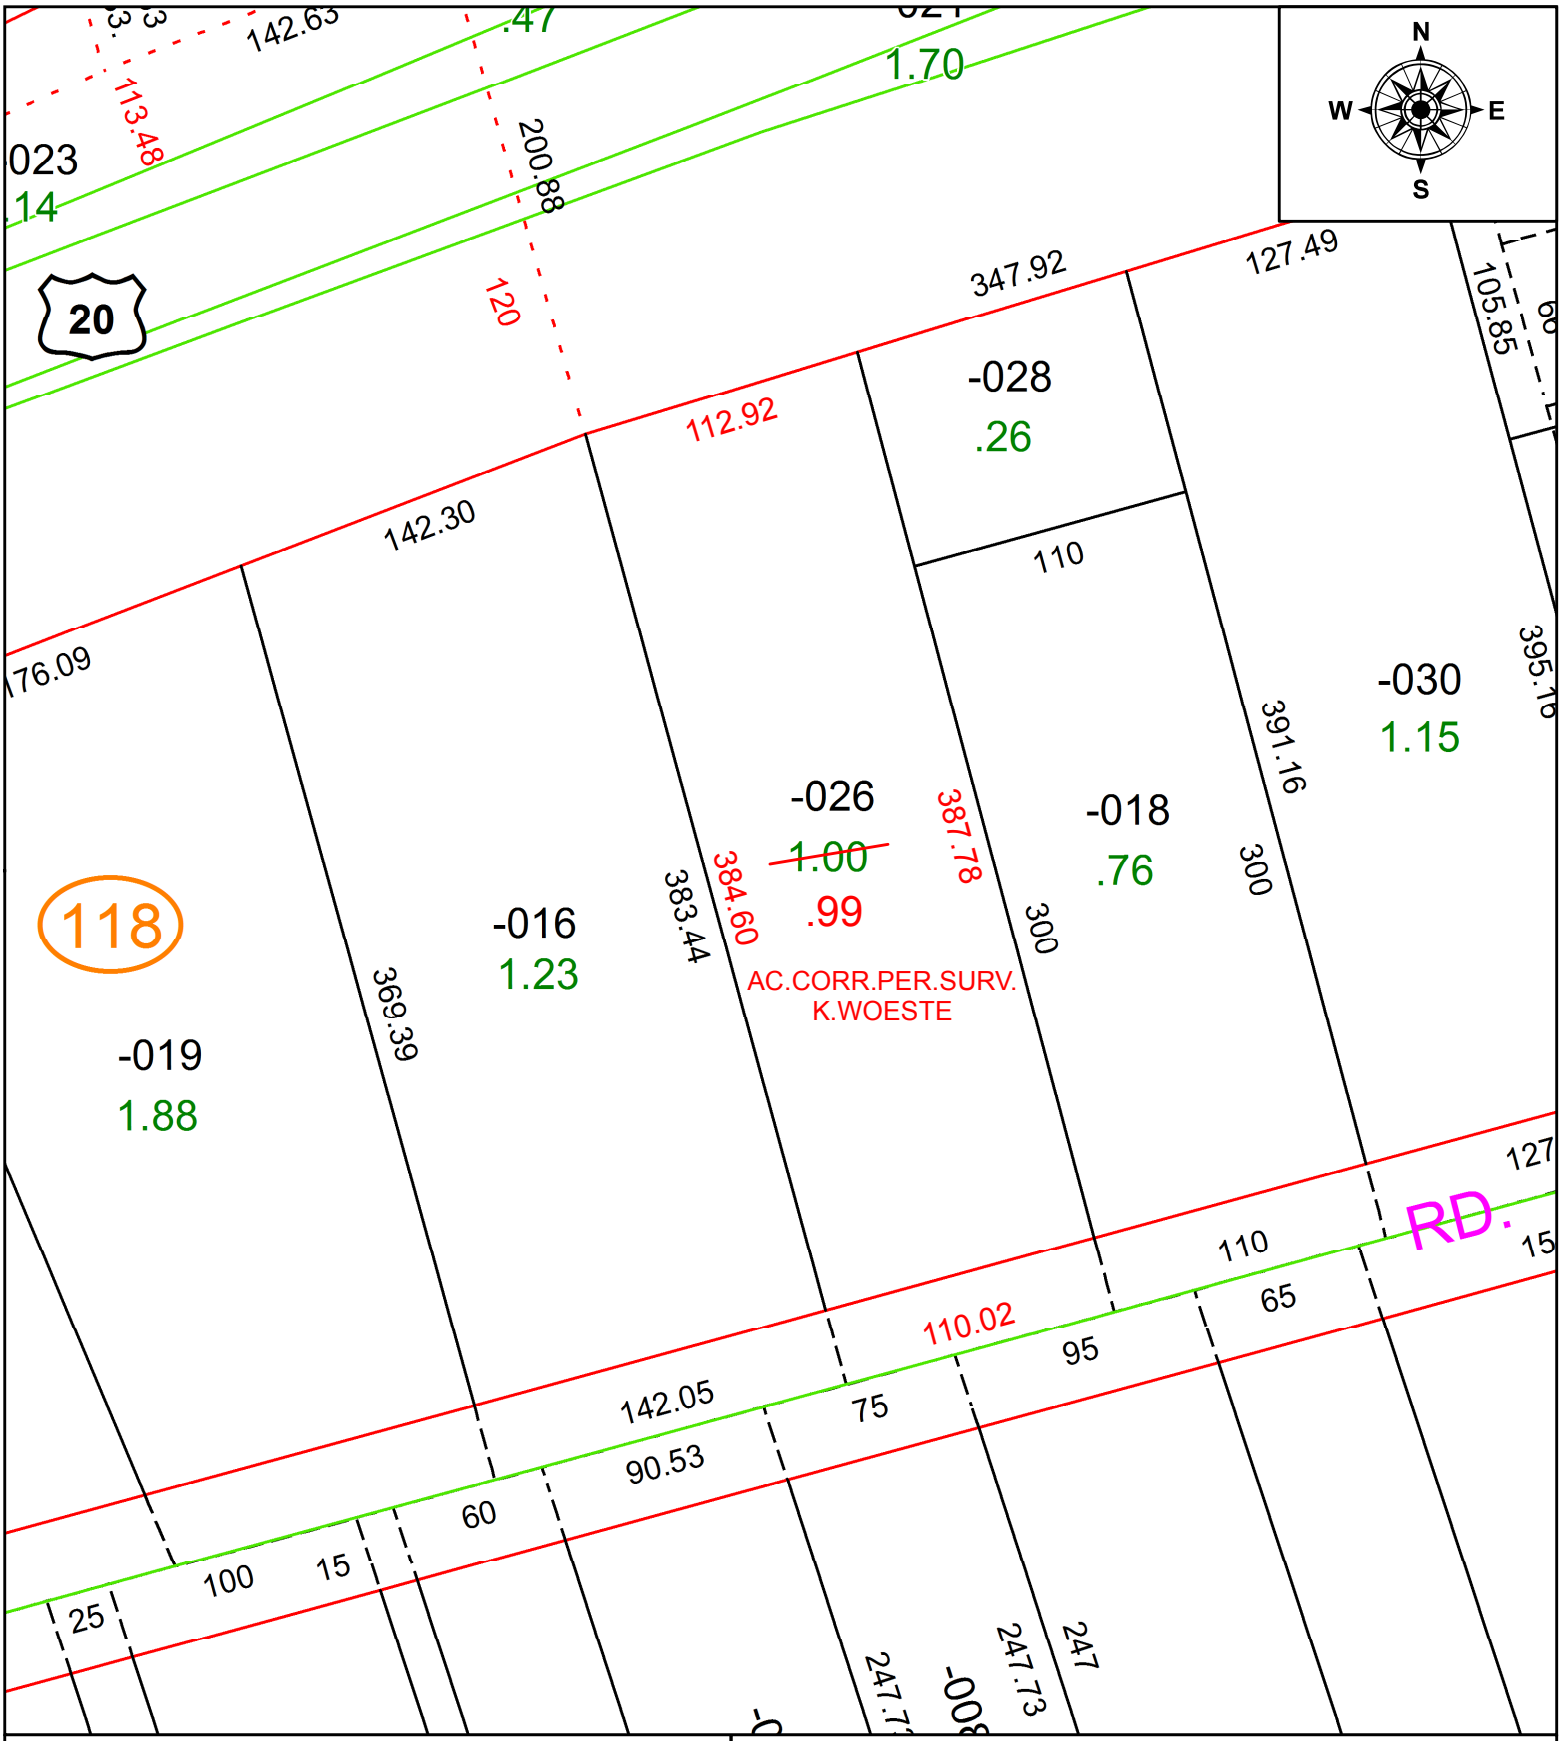

SPLITS/DEEDS PROCESSED

LORAIN COUNTY TAX MAP DEPARTMENT
226 MIDDLE AVE. ELYRIA, OH

SURVEYED BY: KEVIN WOESTE
CLOSURE: 1:253,855
MAP PAGE(S): 10-00-006
APPOVED BY: RRM **DATE:** 4-15-20
SCALE: 1" = 75 **PRIOR INSTRUMENT:** 20200753106