PARENT PARCEL: 05-00-049-000-027 & 05-00-050-000-017

CHILD PARCEL: 05-00-031-000-021, 05-00-049-000--042, 05-00-050-000-018

STARTING POINT: CL OF LEAVITT RD & COMMON CORNER OF O.L. 31, 32, 49 & 50

21-04323

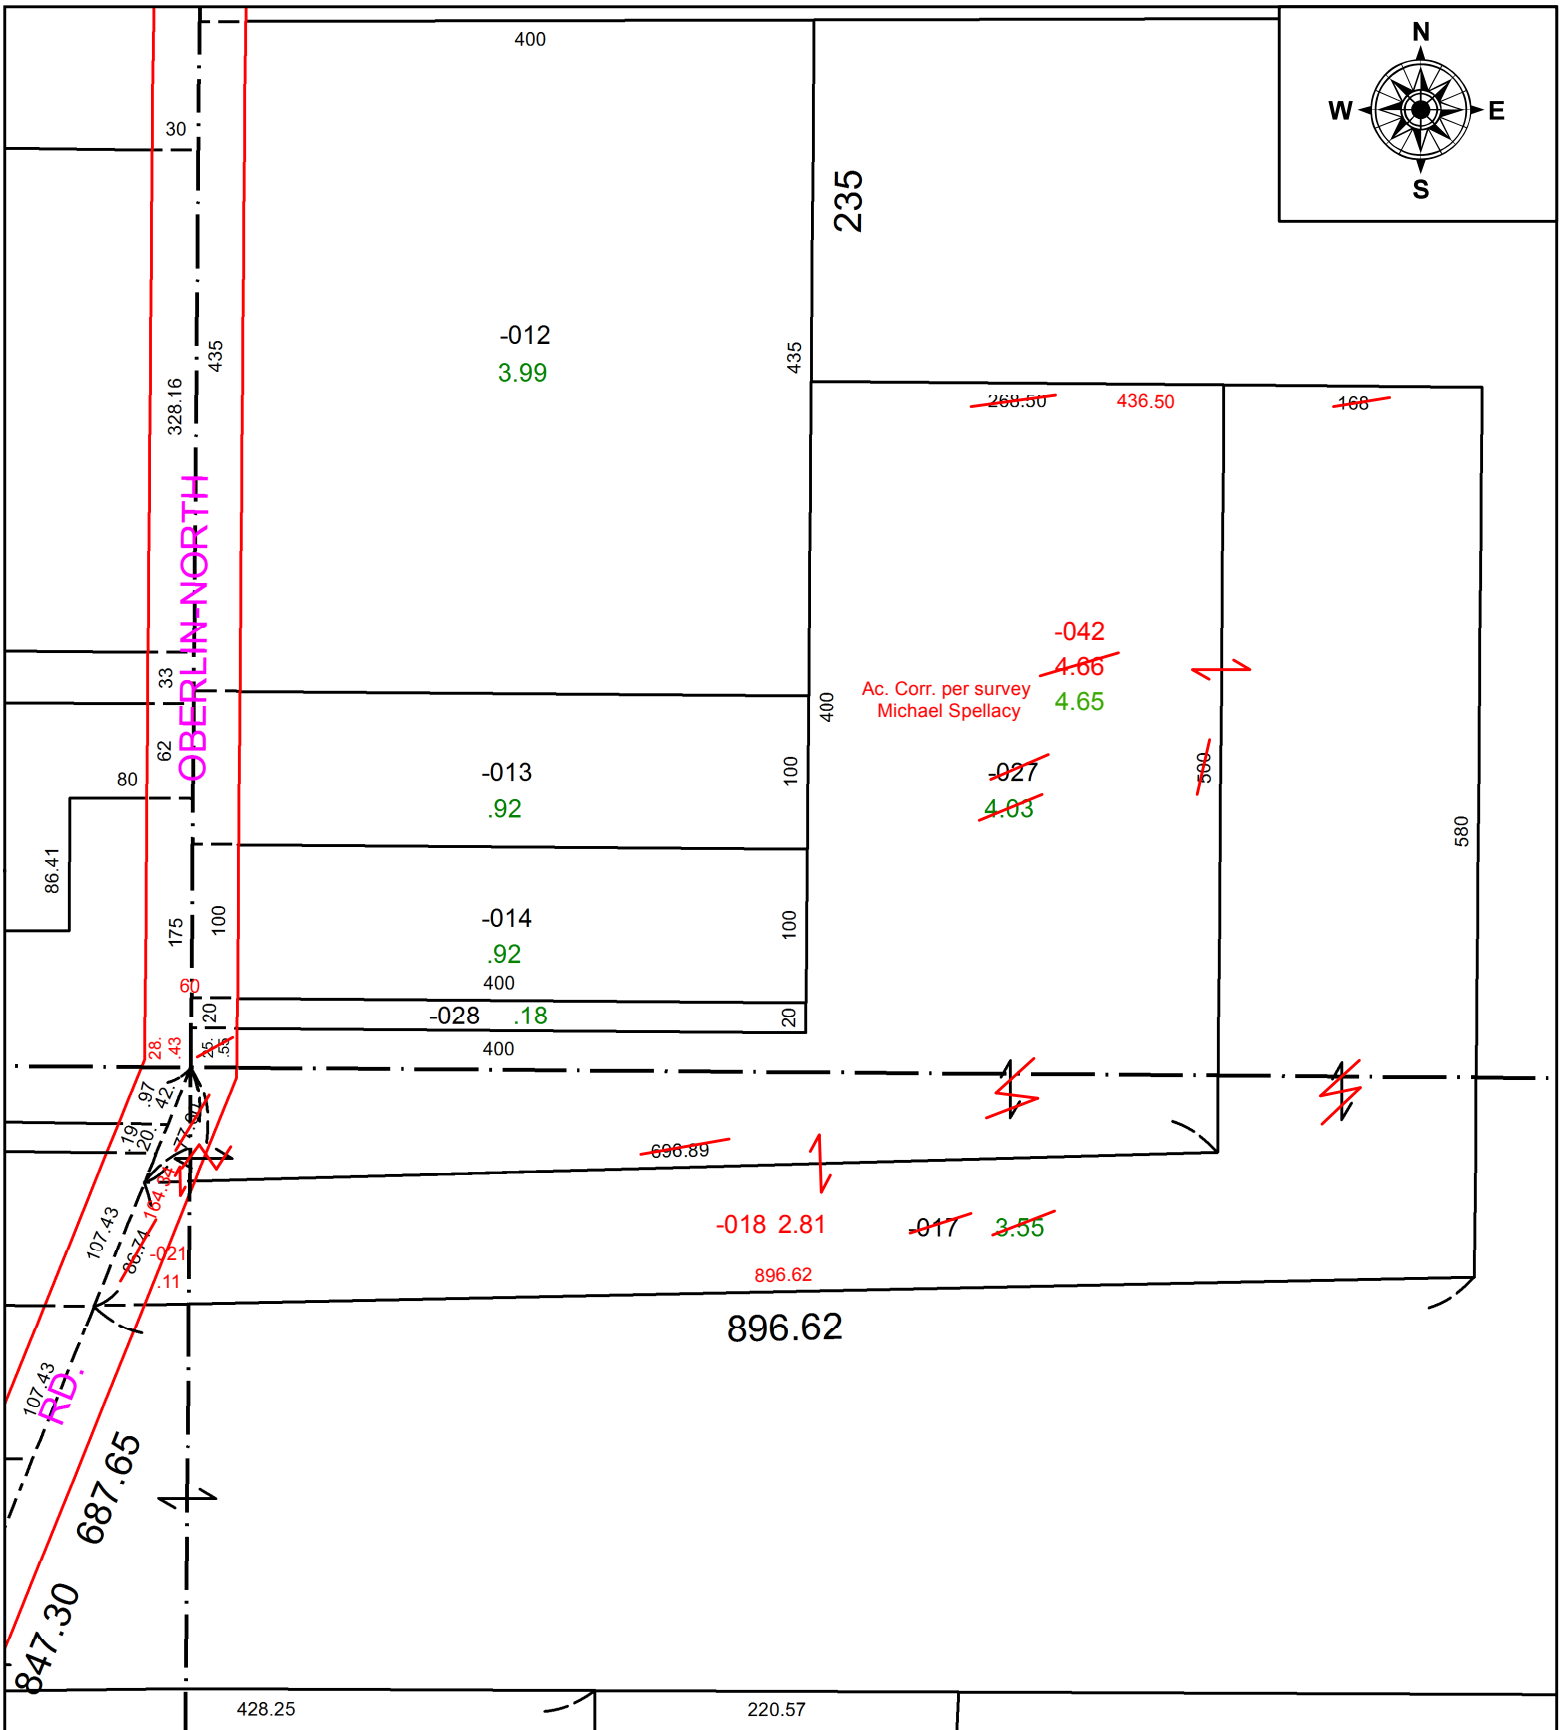

SPLITS/DEEDS PROCESSED

LORAIN COUNTY TAX MAP DEPARTMENT
226 MIDDLE AVE. ELYRIA, OH

SURVEYED BY: MICHAEL SPELLACY
CLOSURE: 1: 33,000
MAP PAGE(S): 05-00-049
APPOVED BY: DMA **DATE:** 7/1/2021
SCALE: 1" = 125 **PRIOR INSTRUMENT:** 20110389590