PARENT PARCEL: 02-01-008-101-172, -173, -174

CHILD PARCEL:

STARTING POINT: POINT ON TANGENCY ON C/L OF BUCKINGHAM DR. IN FRONT OF S/L 15 IN NOTTINGHAM WOODS SUB.

20-04324-C

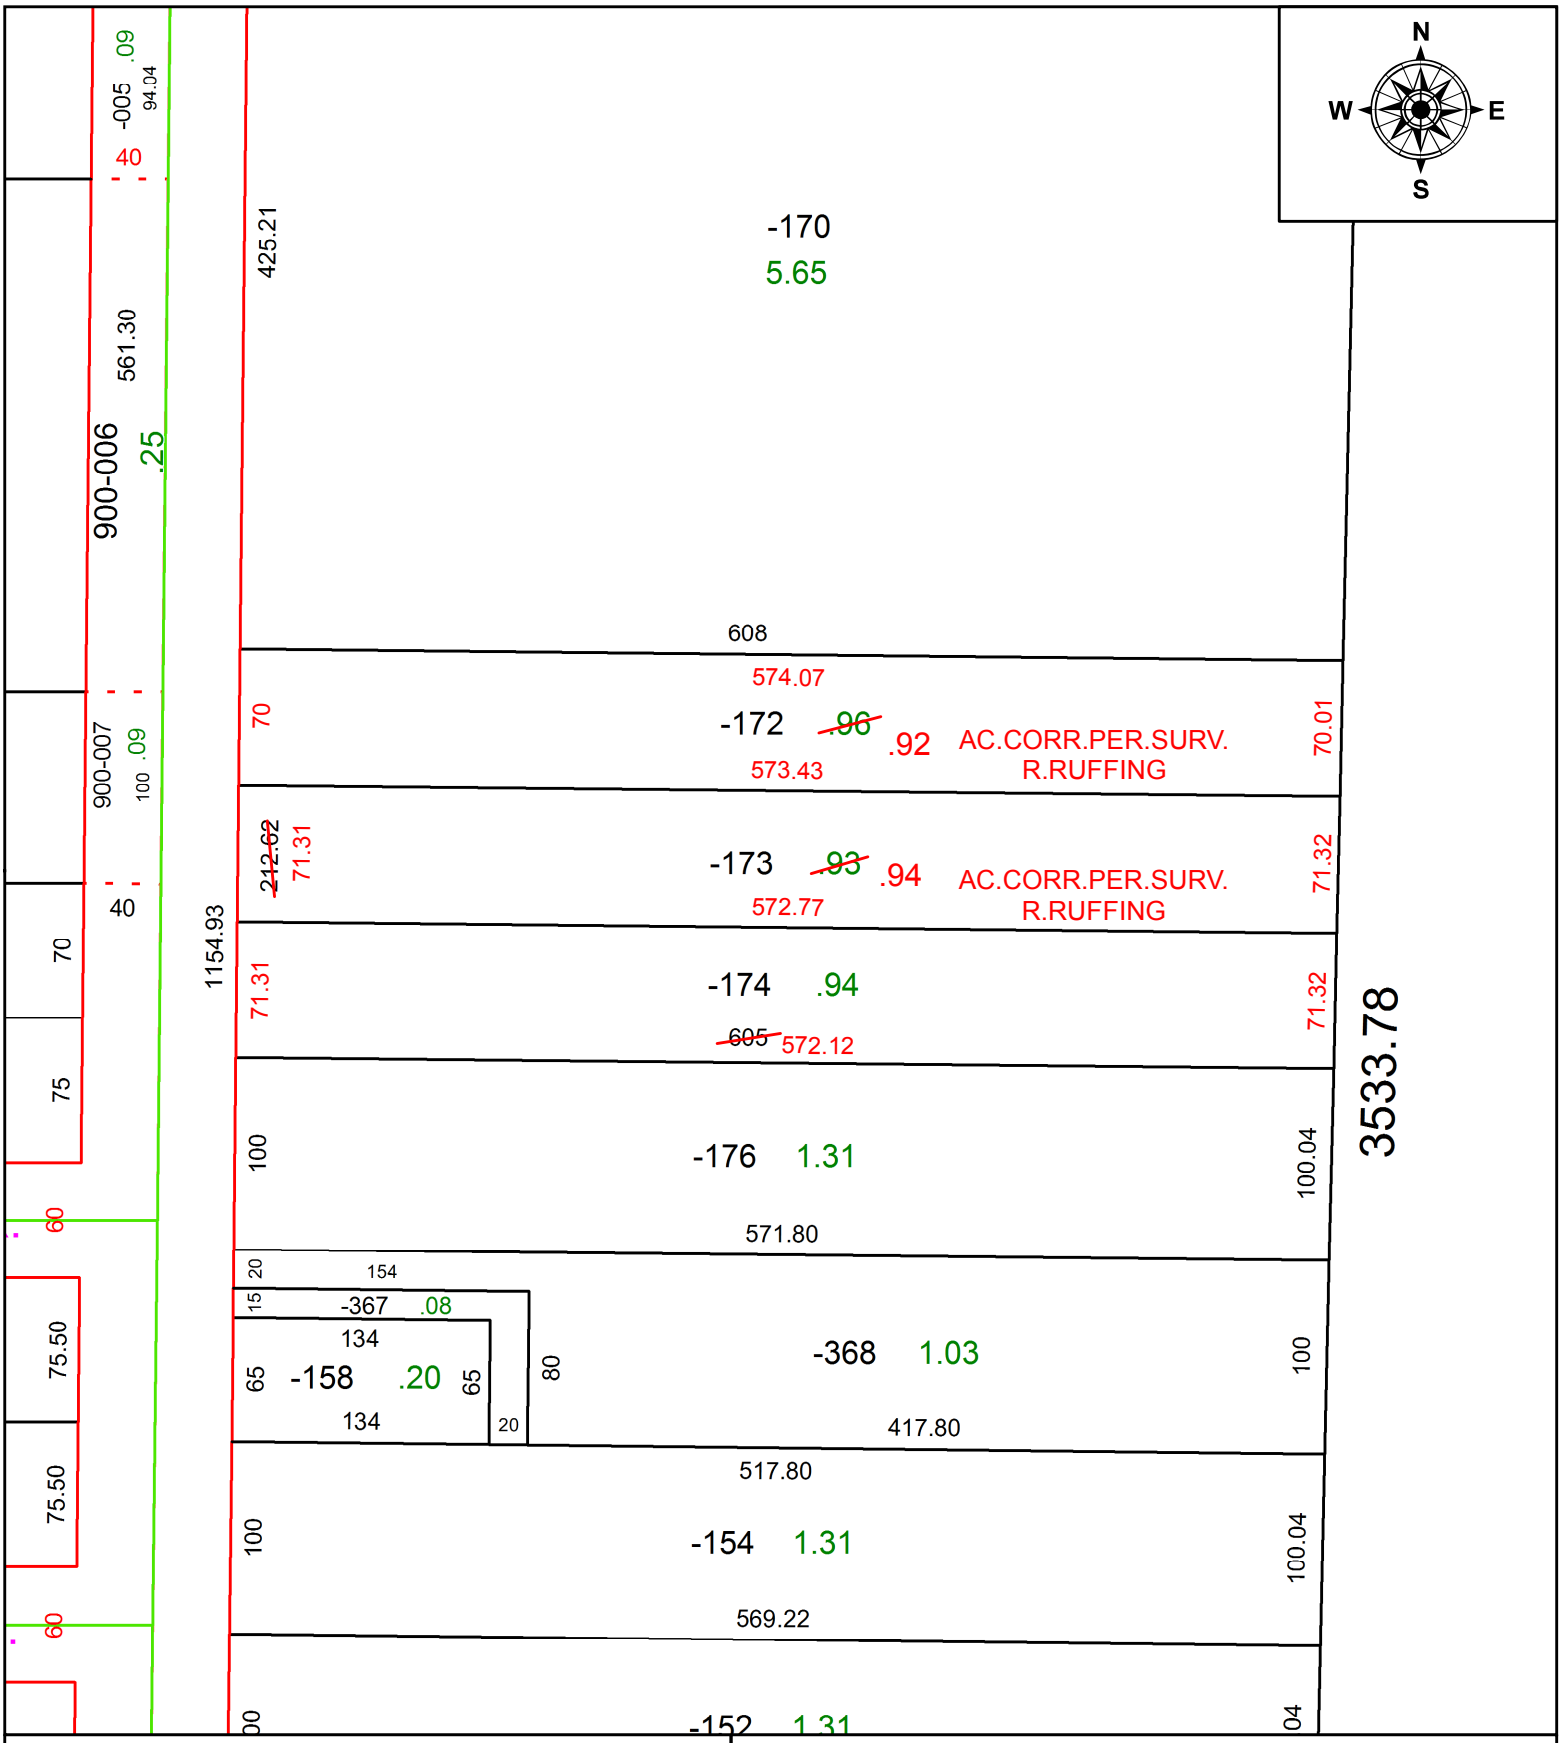

SPLITS/DEEDS PROCESSED

LORAIN COUNTY TAX MAP DEPARTMENT
226 MIDDLE AVE. ELYRIA, OH

SURVEYED BY: ROBERT M. RUFFING
CLOSURE: 1:306,443
MAP PAGE(S): 2-01-008
APPOVED BY: RRM **DATE:** 5-6-20
SCALE: 1" = 100 **PRIOR INSTRUMENT:** 20110380788