PARENT PARCEL: 09-00-058-000-009 & -017

CHILD PARCEL: 09-00-058-000-038 THRU -040

STARTING POINT: INTERSECTION OF C/LS BUTTERNUT RIDGE RD & OBERLIN RD

21-04331

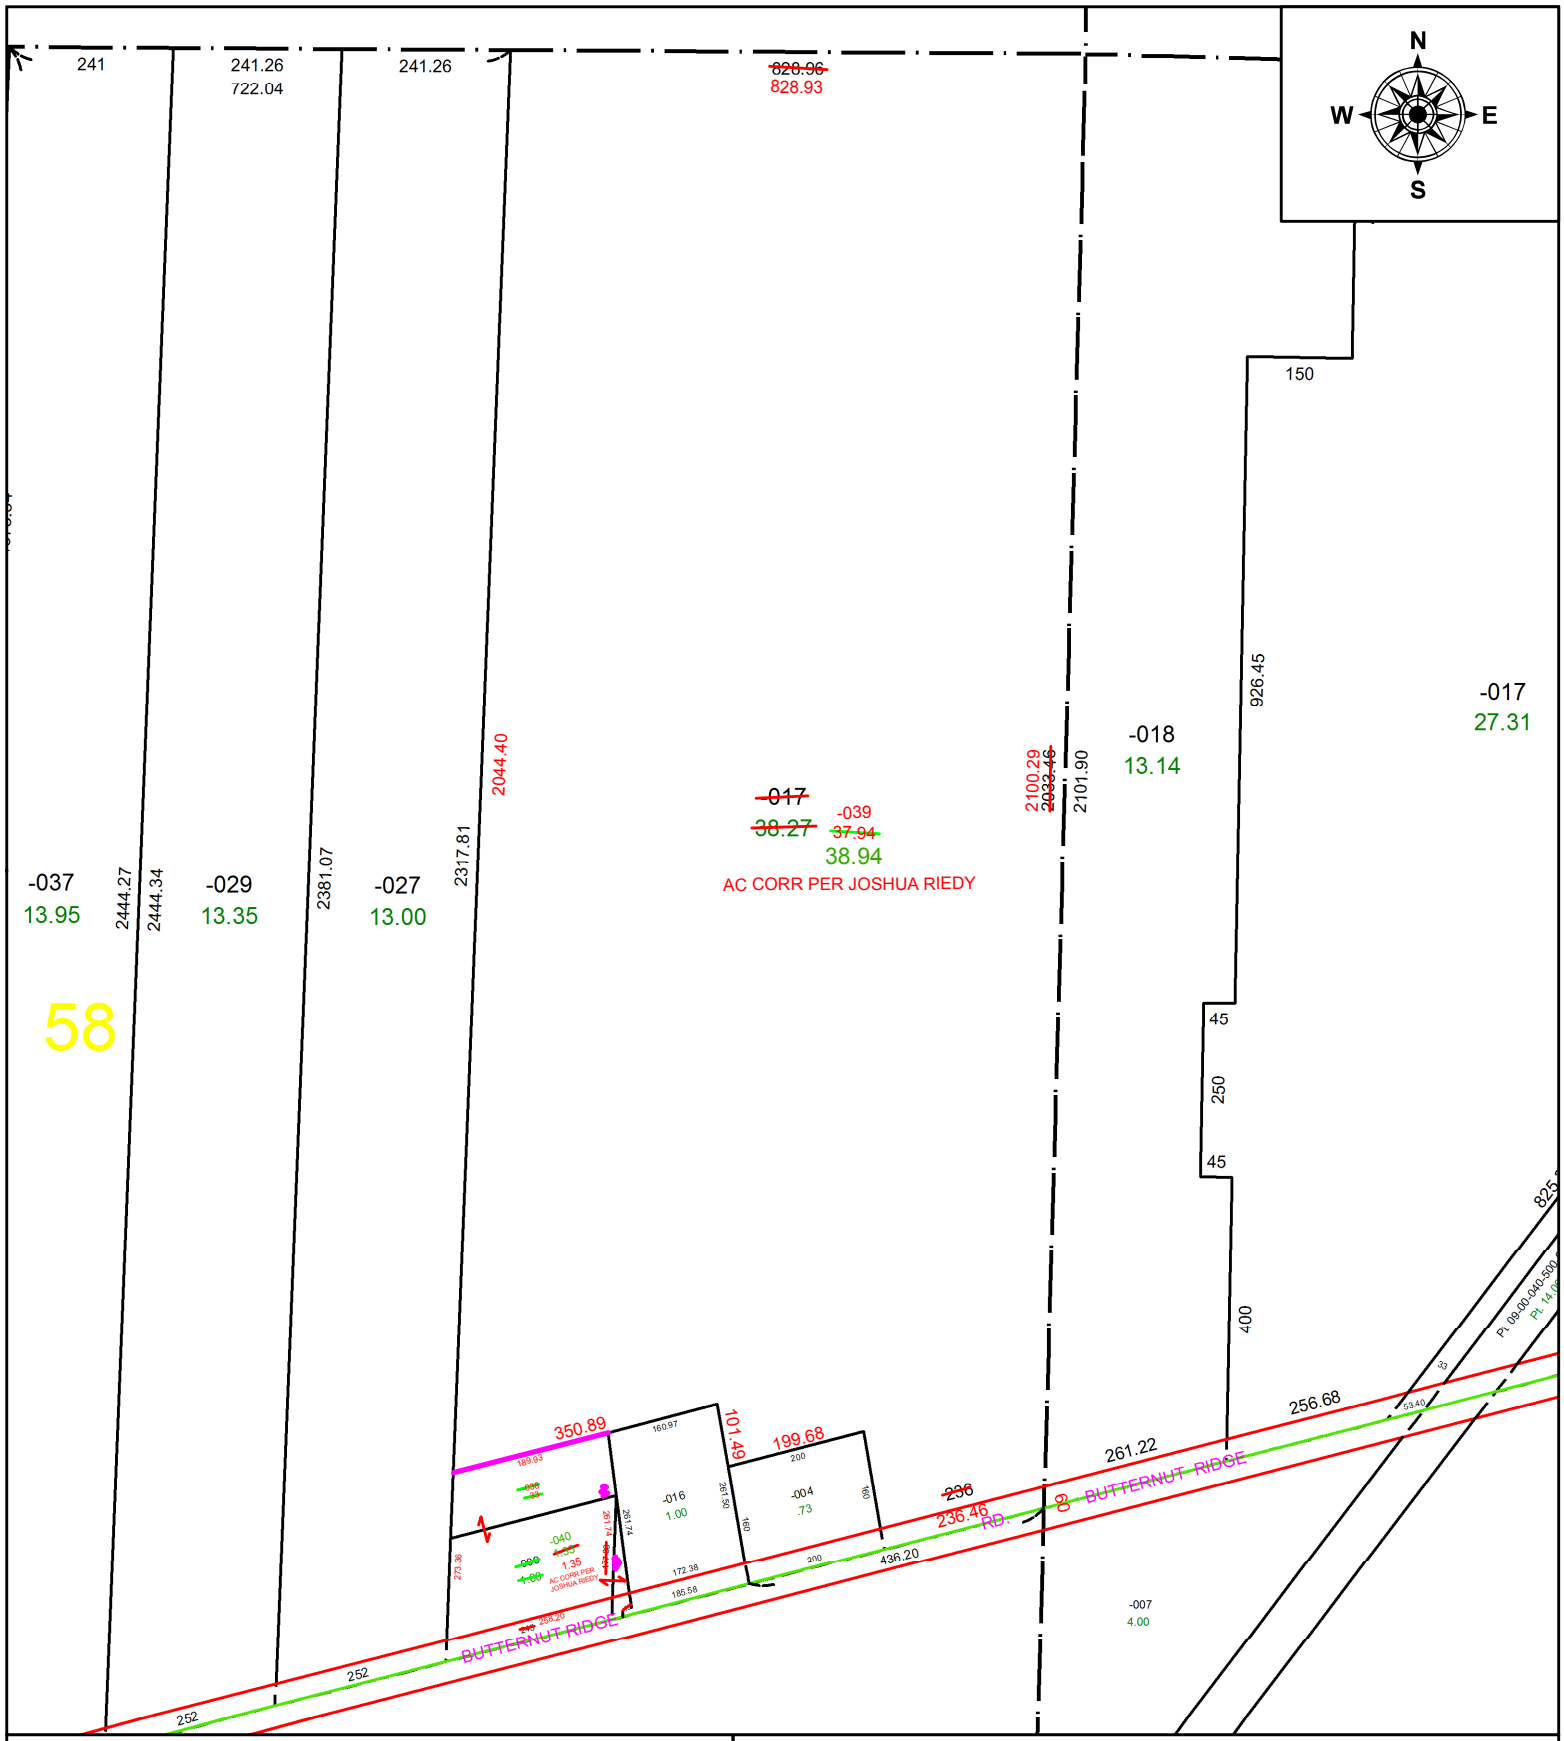

SPLITS/DEEDS PROCESSED

LORAIN COUNTY TAX MAP DEPARTMENT
226 MIDDLE AVE. ELYRIA, OH

SURVEYED BY: JOSHUA RIEDY
CLOSURE: 1:121,956
MAP PAGE(S): 09-00-058
APPOVED BY: WRZ **DATE:** 7/22/2021
SCALE: 1" = 275 **PRIOR INSTRUMENT:** O.R. V 1072 PG 168