PARENT PARCEL: 11-00-007-000-003 THRU -005, & -038

CHILD PARCEL: 11-00-007-000-081, -082, -083

STARTING POINT: INTERSECTION OF C/LS COOLEY RD & HAWKE RD

21-04334

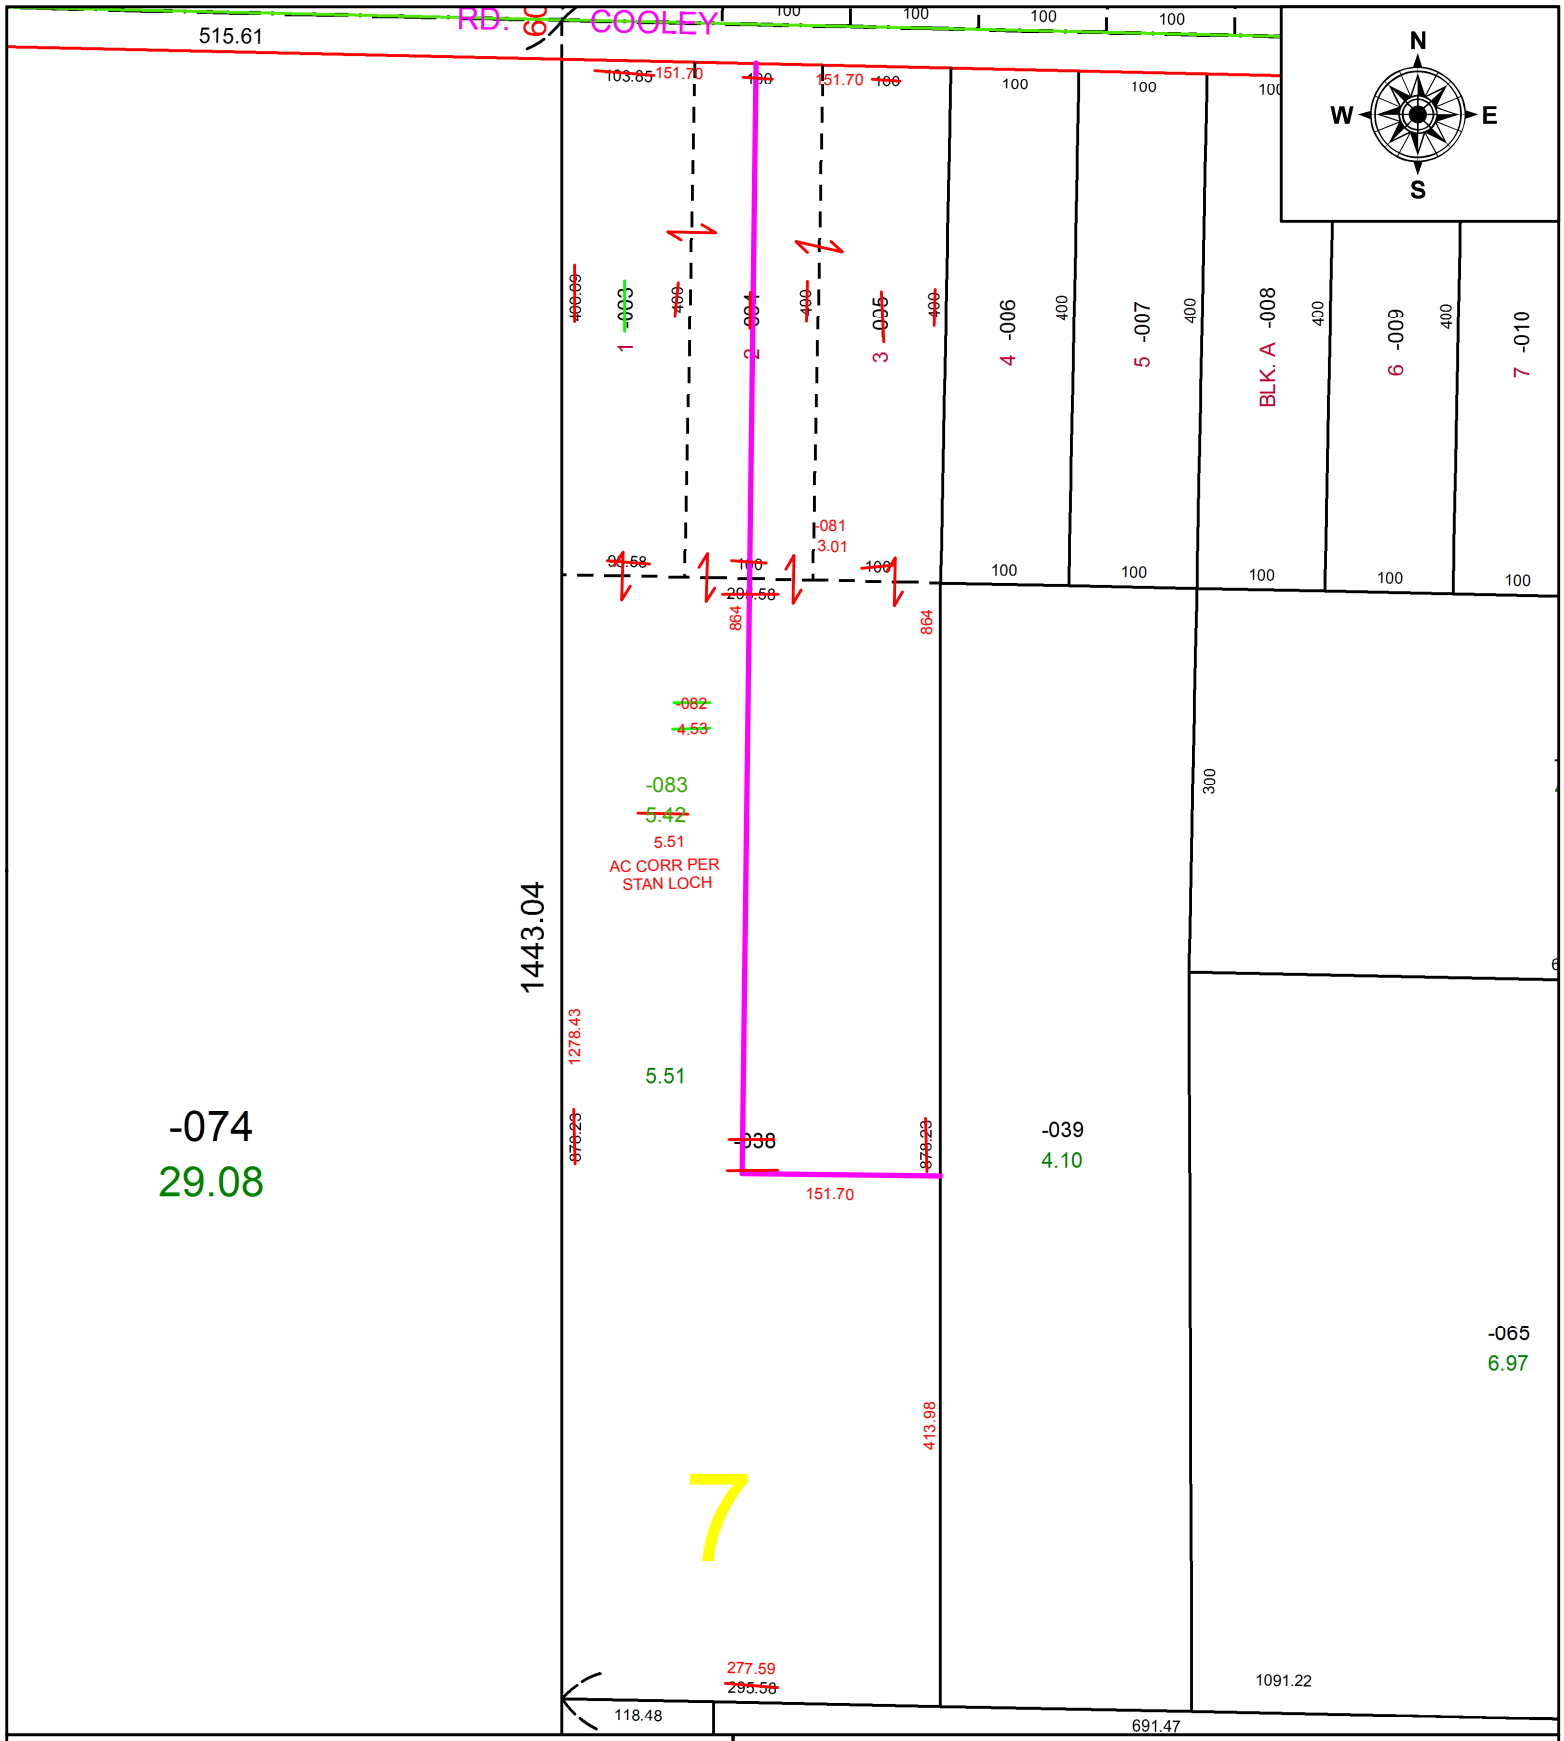

SPLITS/DEEDS PROCESSED

LORAIN COUNTY TAX MAP DEPARTMENT
226 MIDDLE AVE. ELYRIA, OH

SURVEYED BY: STAN LOCH
CLOSURE: 1: -2147483648
MAP PAGE(S): 11-00-007
APPOVED BY: WRZ **DATE:** 7/28/2021
SCALE: 1" = 150 **PRIOR INSTRUMENT:** 1994-0269647