PARENT PARCEL: 02-02-026-106-007 & -008

CHILD PARCEL: 02-02-02-106-037

STARTING POINT: SOUTHERLY LINE OF WEST ERIE AVE. & WEST LINE OF OBERLIN AVE.

21-04335

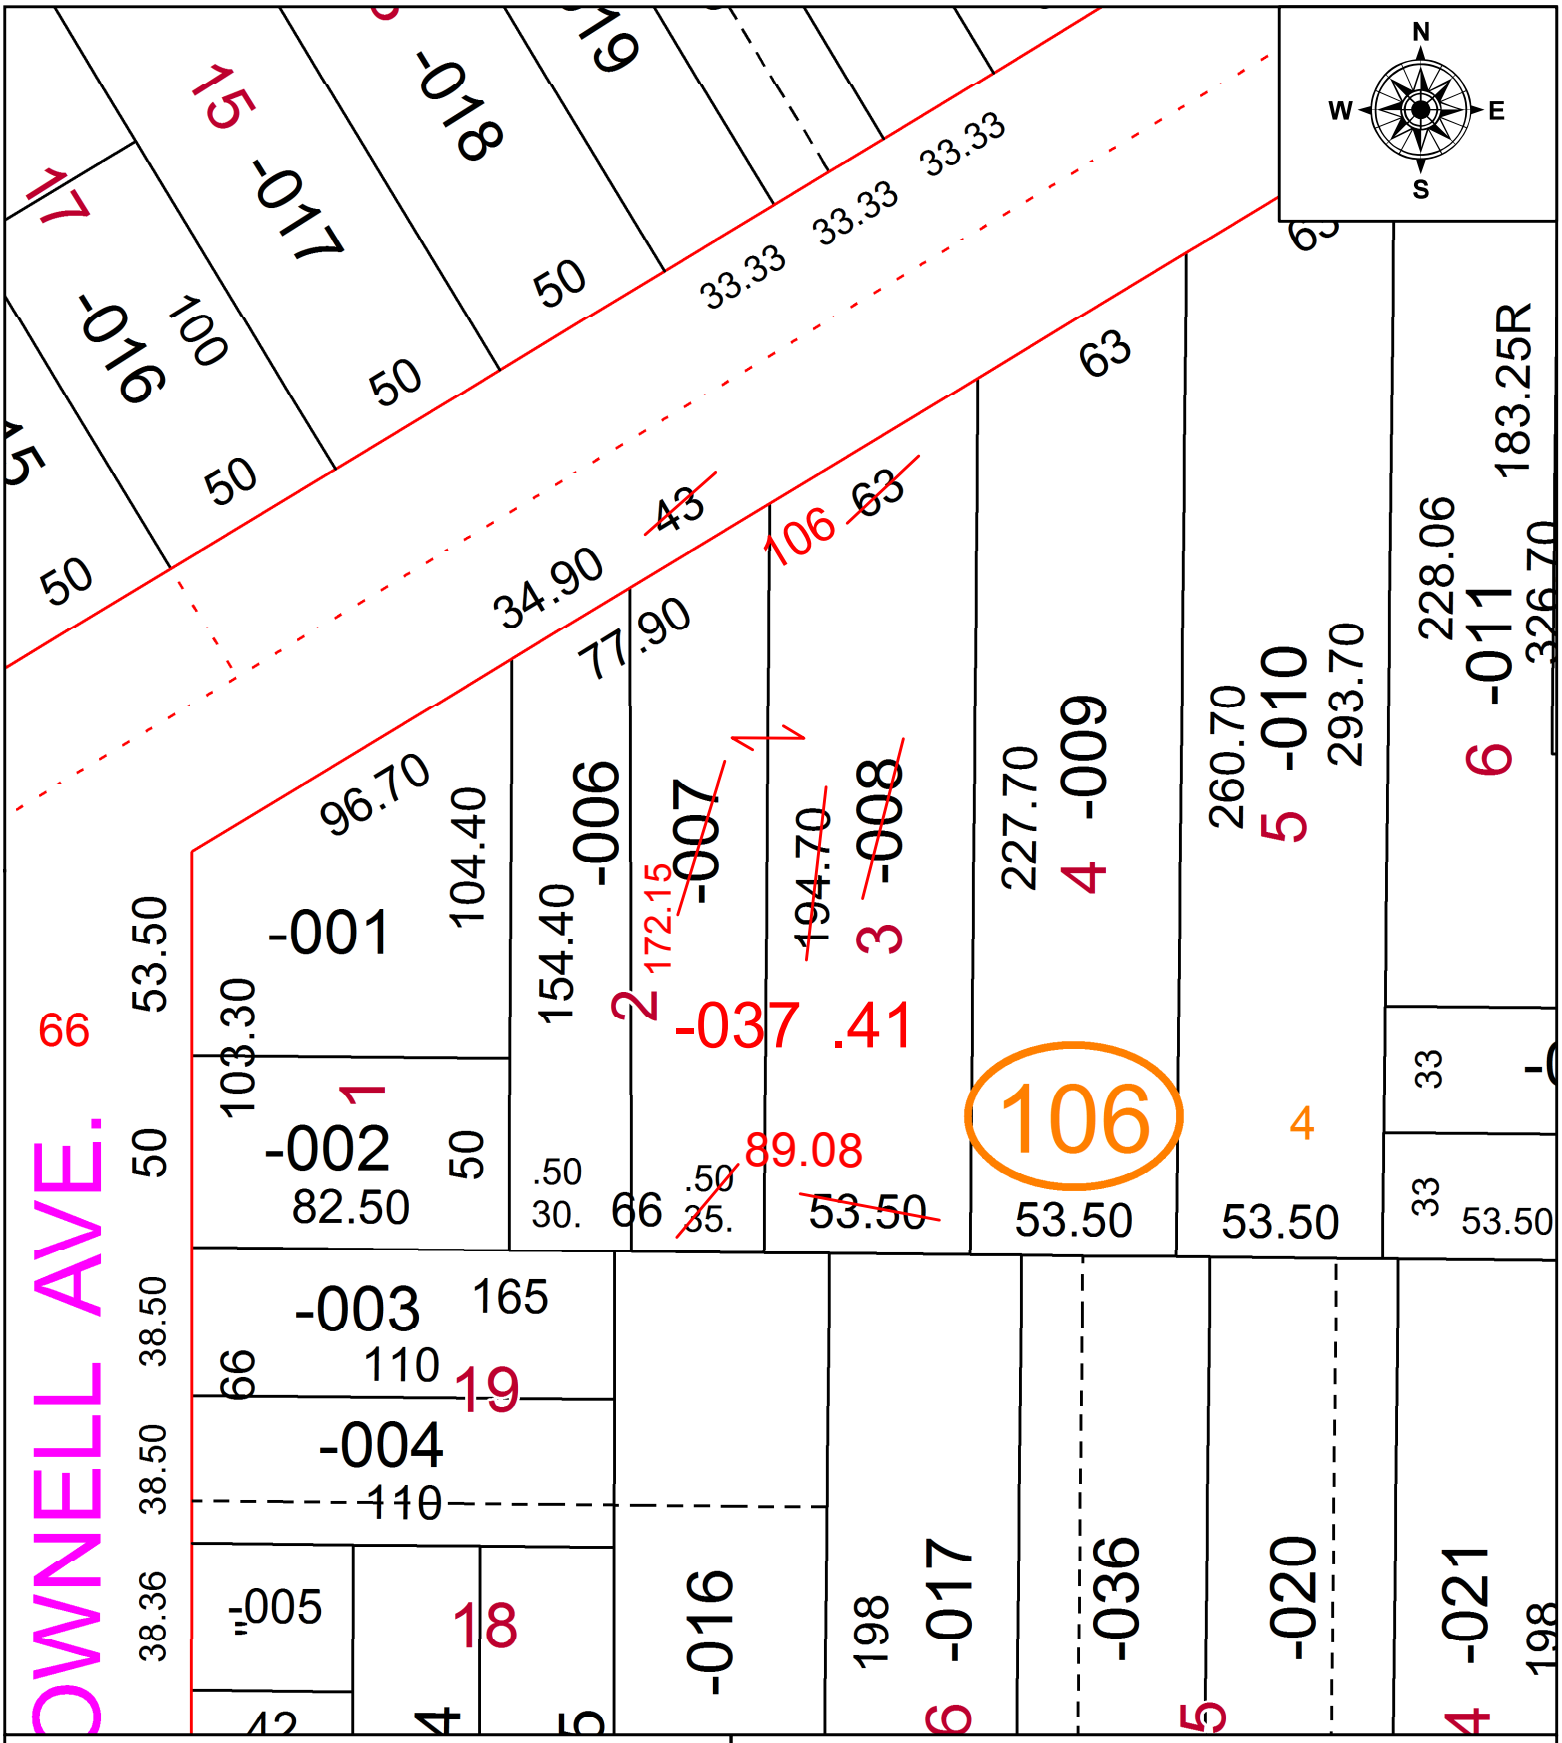

SPLITS/DEEDS PROCESSED

LORAIN COUNTY TAX MAP DEPARTMENT
226 MIDDLE AVE. ELYRIA, OH

SURVEYED BY: PATRICK MCGANNON
CLOSURE: 1: 123,769
MAP PAGE(S): 02-02-026
APPOVED BY: DMA **DATE:** 8/11/2021
SCALE: 1" = 50' **PRIOR INSTRUMENT:** 20210815856