**PARENT PARCEL:** 14-00-132-000-001
**CHILD PARCEL:** 14-00-132-000-002 & -003
**STARTING POINT:** CL OF PITTS RD. & MERRIAM RD (S.E. CORNER O.L. 133)

# 21-04337

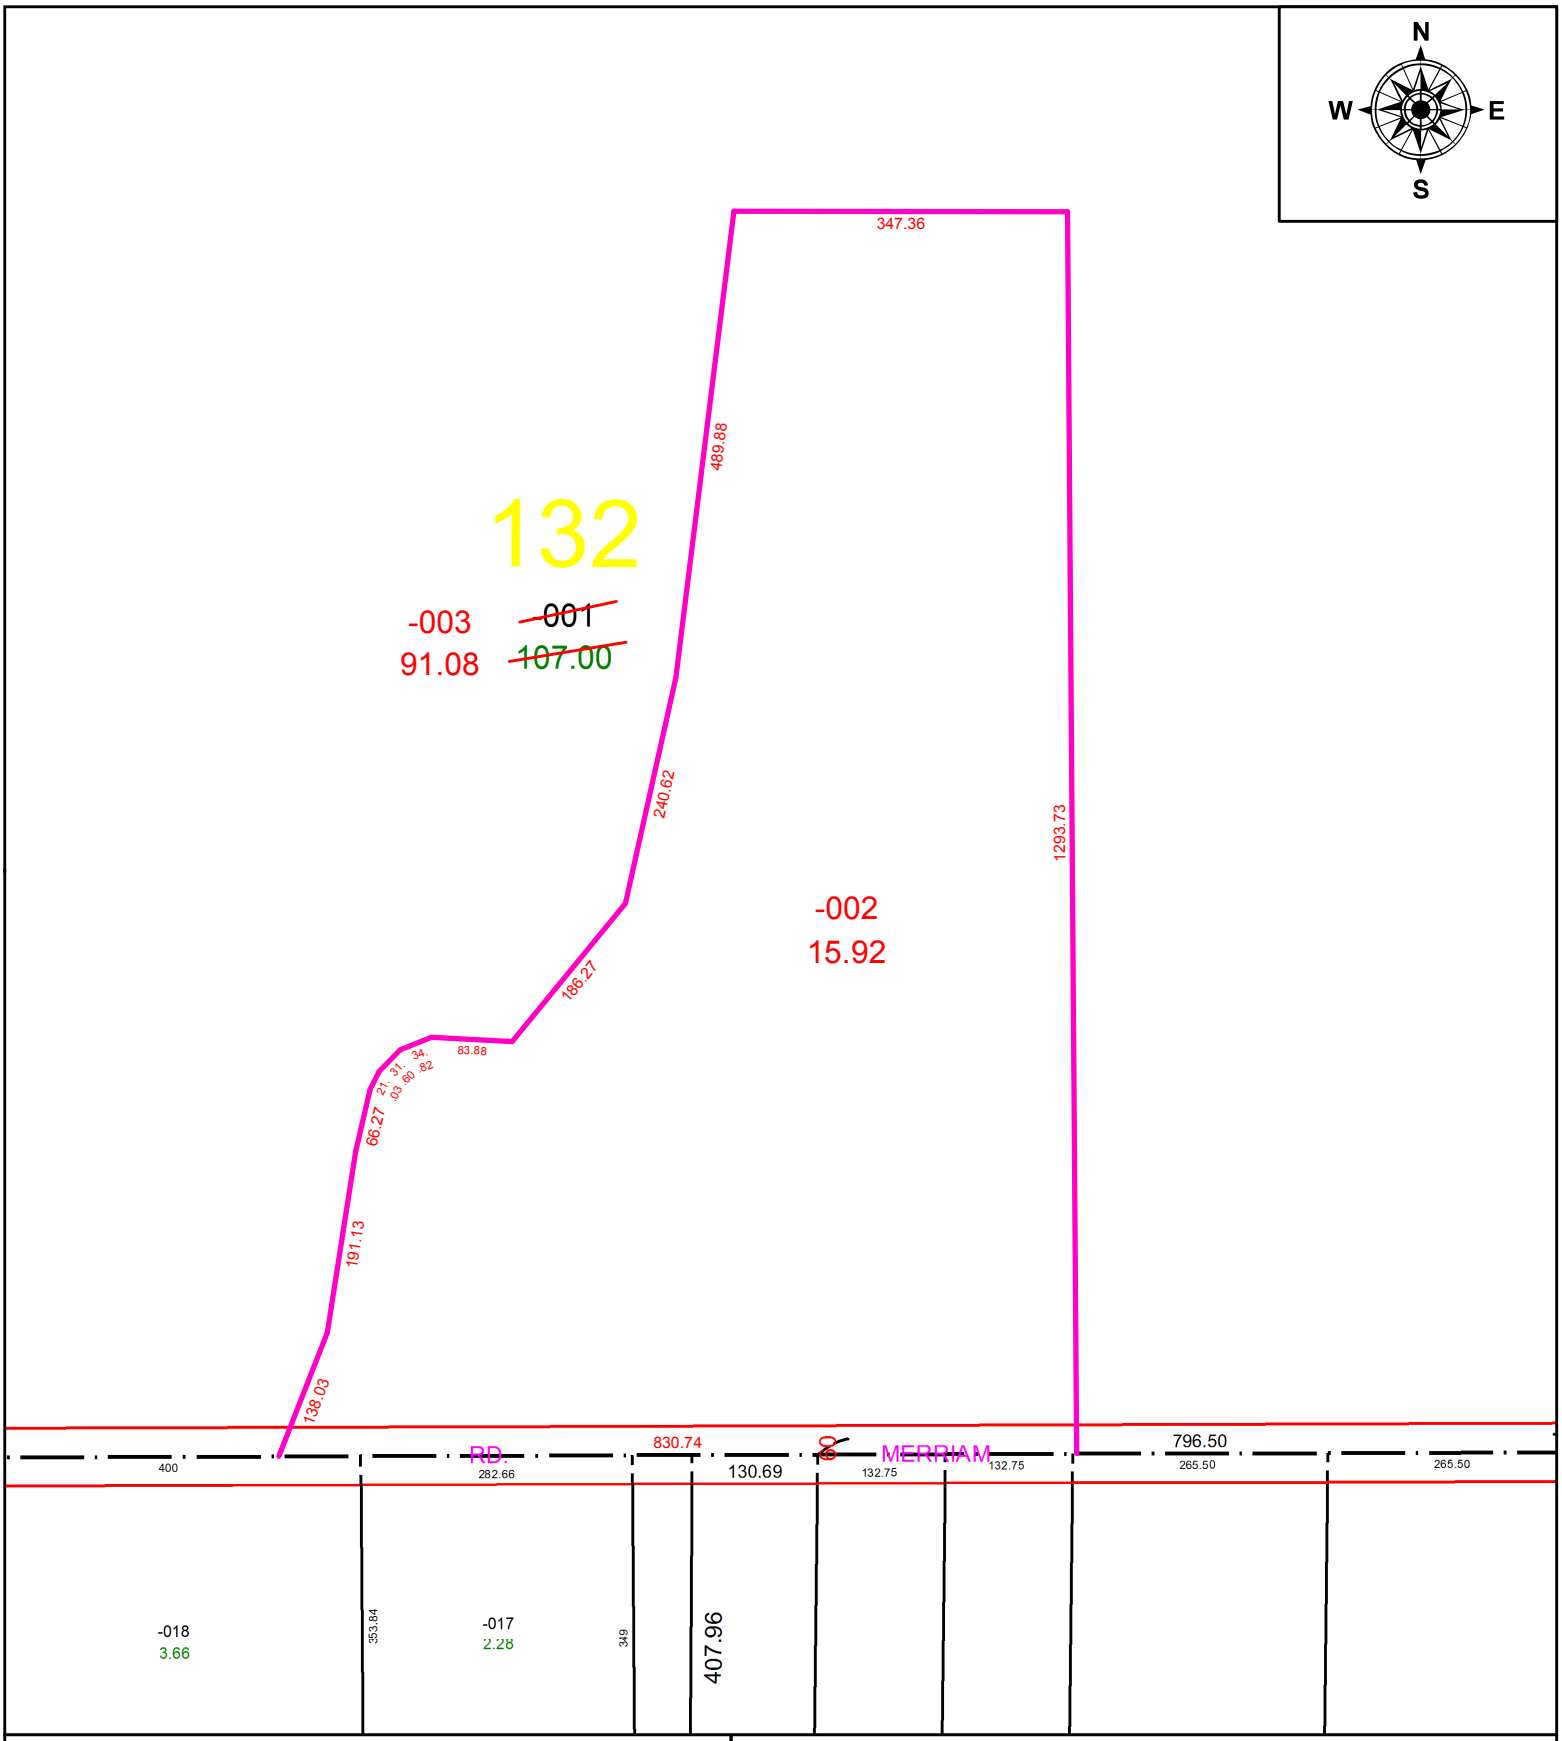


**SPLITS/DEEDS PROCESSED**

LORAIN COUNTY TAX MAP DEPARTMENT
226 MIDDLE AVE. ELYRIA, OH

**SURVEYED BY:** TIMOTHY HOLZALSKI
**CLOSURE:** 1: 615,719
**MAP PAGE(S):** 14-00-132
**APPOVED BY:** DMA **DATE:** 7/30/2021
**SCALE:** 1" = 200' **PRIOR INSTRUMENT:** 20210824010