PARENT PARCEL: 04-00-001-102-027

CHILD PARCEL:

STARTING POINT: INTERSECTION OF C/L OF EVERGREEN DR. AND C/L OF CASE RD.

20-04340-D

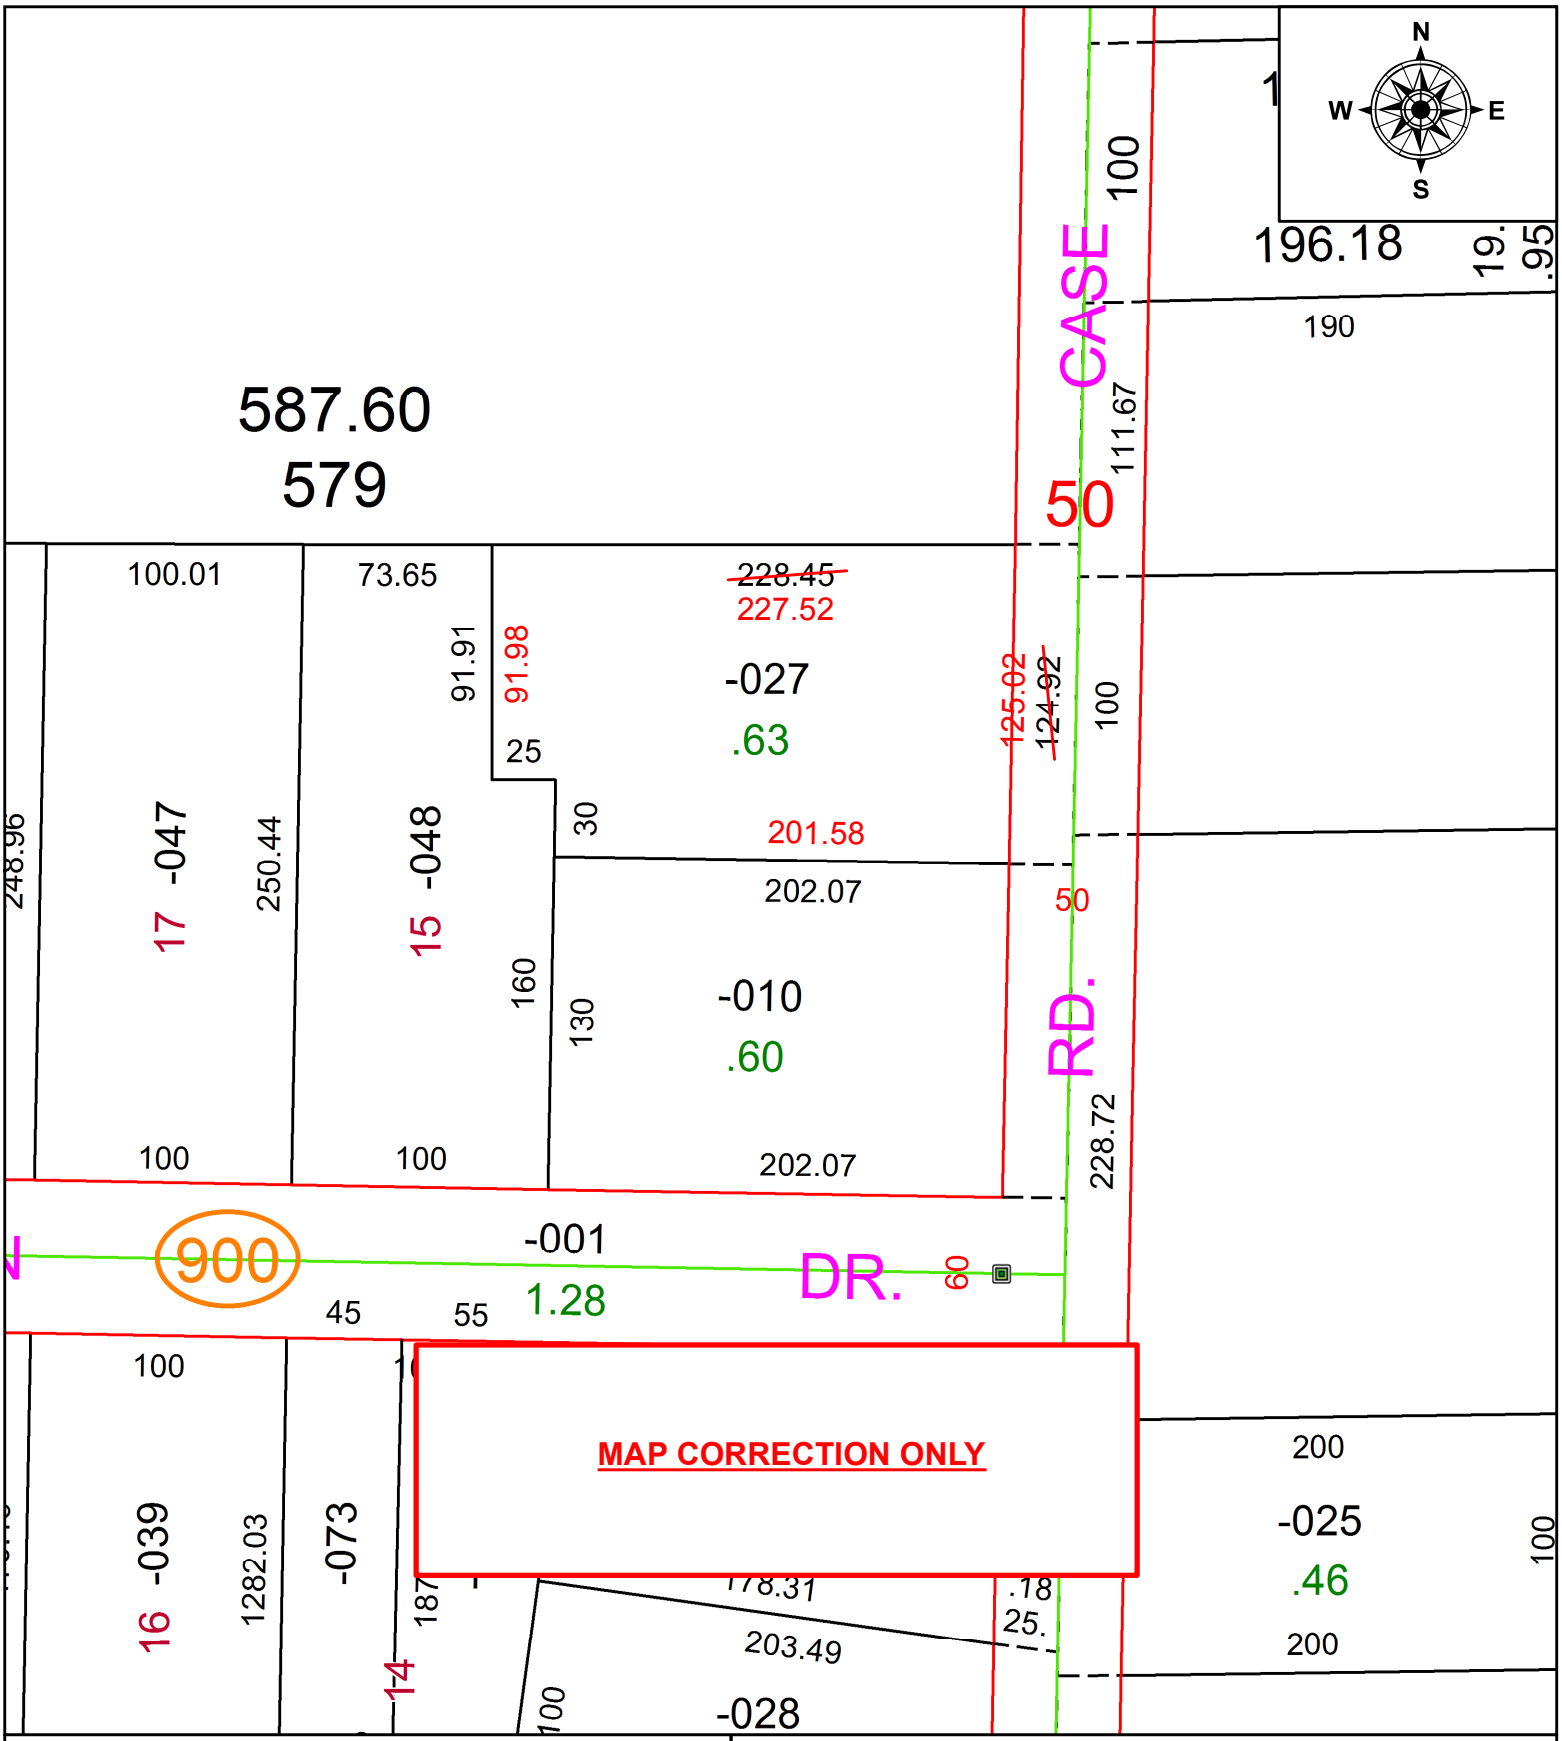

SPLITS/DEEDS PROCESSED

LORAIN COUNTY TAX MAP DEPARTMENT
226 MIDDLE AVE. ELYRIA, OH

SURVEYED BY: THOMAS A. SIMON
CLOSURE: 1:201,637
MAP PAGE(S): 4-00-001
APPOVED BY: RRM **DATE:** 5-26-20
SCALE: 1" = 75 **PRIOR INSTRUMENT:** 20190741827