PARENT PARCEL: 10-00-004-127-018, 10-00-007-102-003, -014, -015

CHILD PARCEL: 10-00-004-127-018 & 10-00-007-102-017

STARTING POINT: AC CORR PER SURV BY ALEX MARKS

21-04340

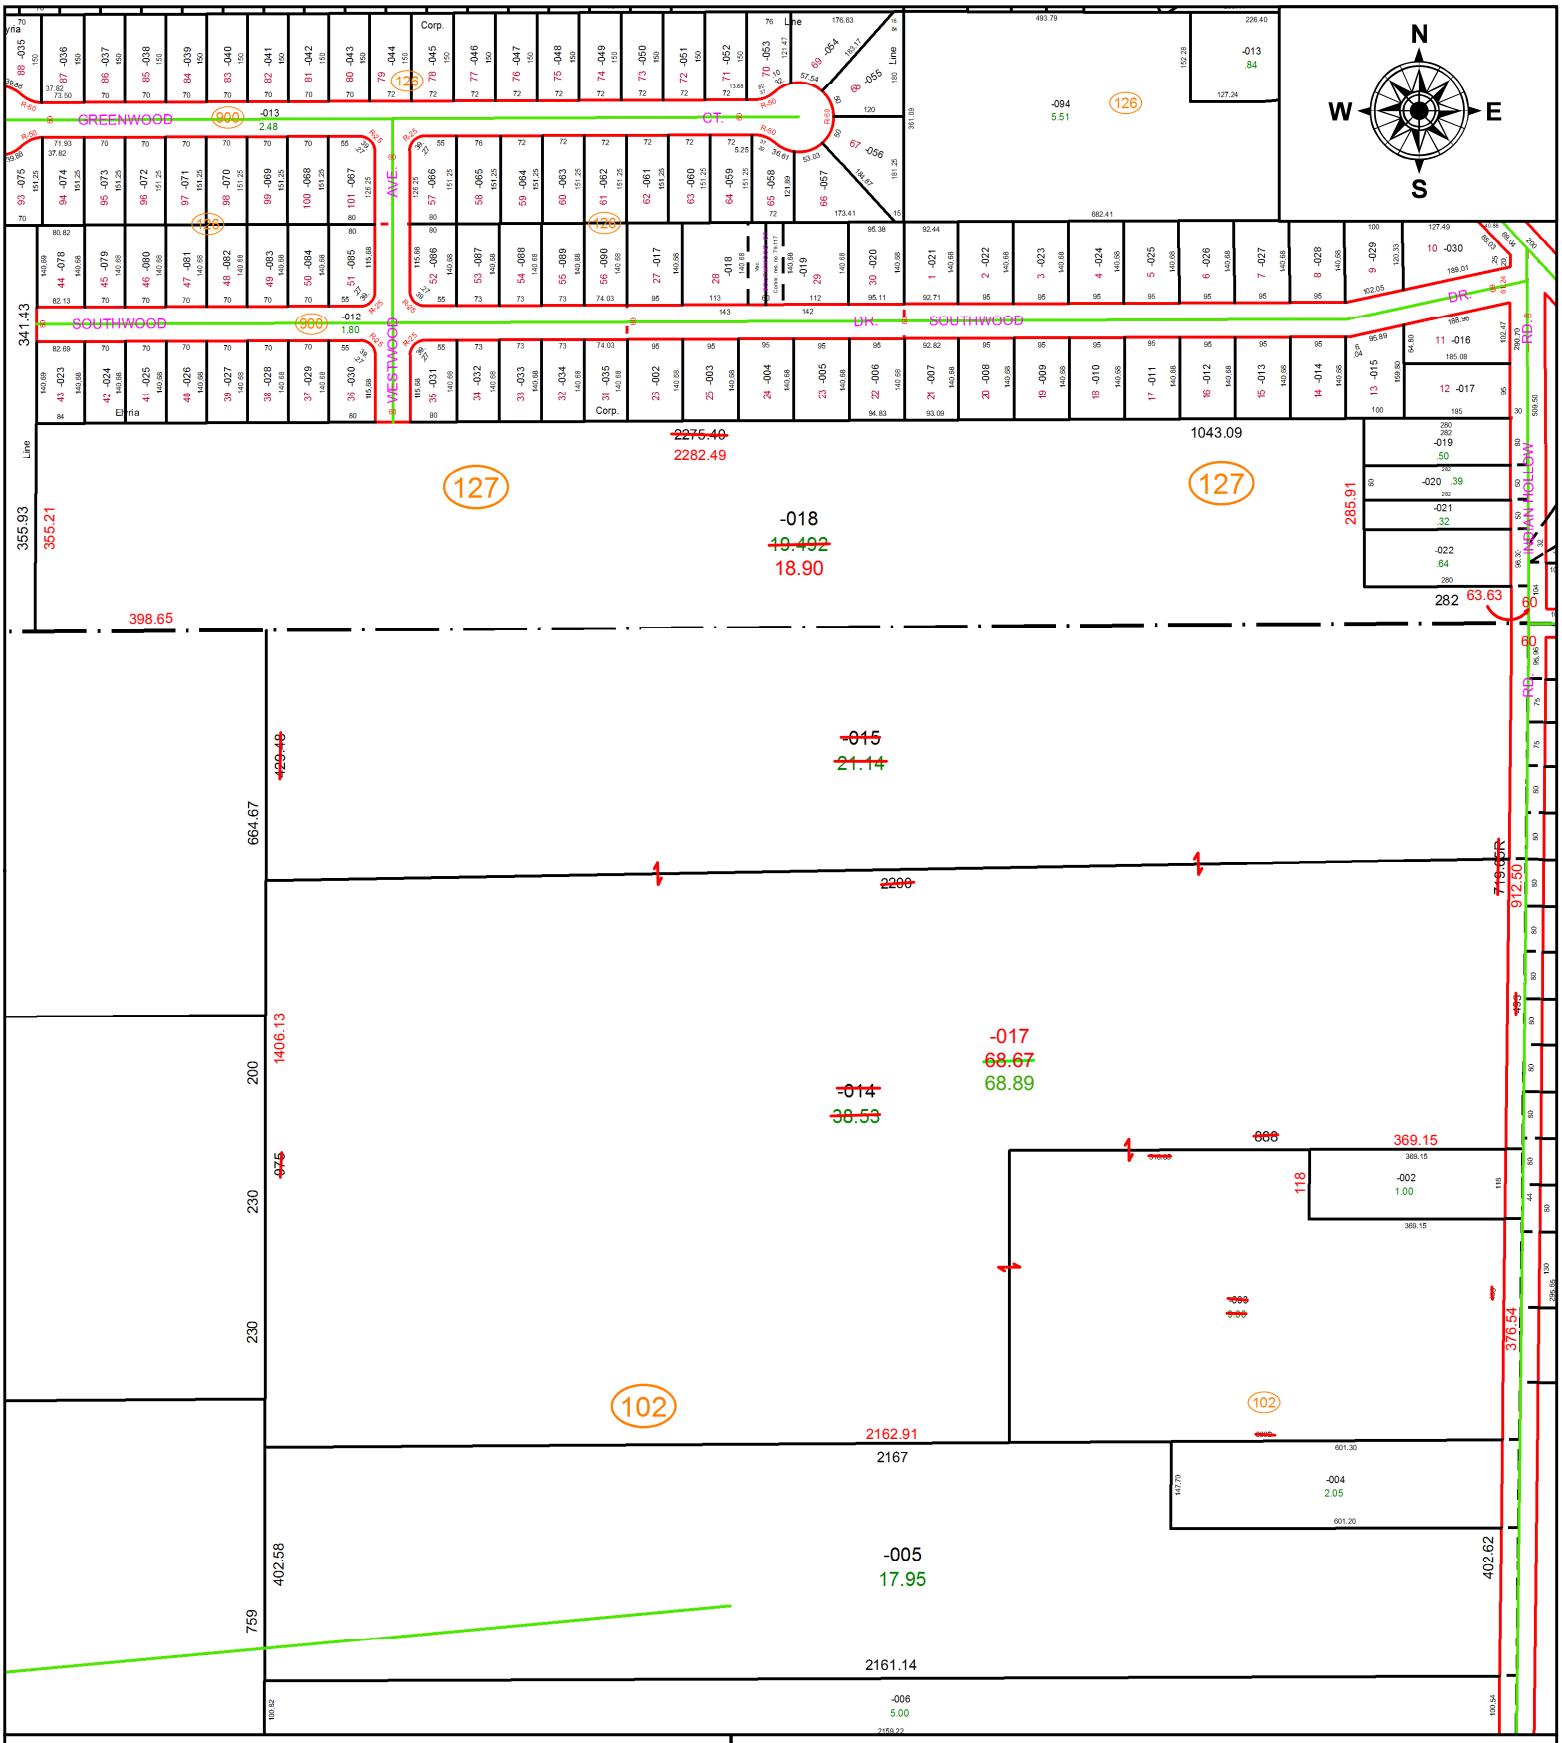

SPLITS/DEEDS PROCESSED

LORAIN COUNTY TAX MAP DEPARTMENT
226 MIDDLE AVE. ELYRIA, OH

SURVEYED BY: ALEX MARKS
CLOSURE: 1: 429476
MAP PAGE(S): 10-00-007
APPOVED BY: AC **DATE:** 8/5/2021
SCALE: 1" = 330 **PRIOR INSTRUMENT:** 2008-0237106