PARENT PARCEL: 20-05-017-105-004, -005, 20-05-022-105-004, -005

CHILD PARCEL: 20-05-017-105-005, 20-05-022-105-005,-009

STARTING POINT: INTERSECTION OF NORTH LINE OF SOUTH ST. AND EAST LINE OF STATE ST.

20-04344-D

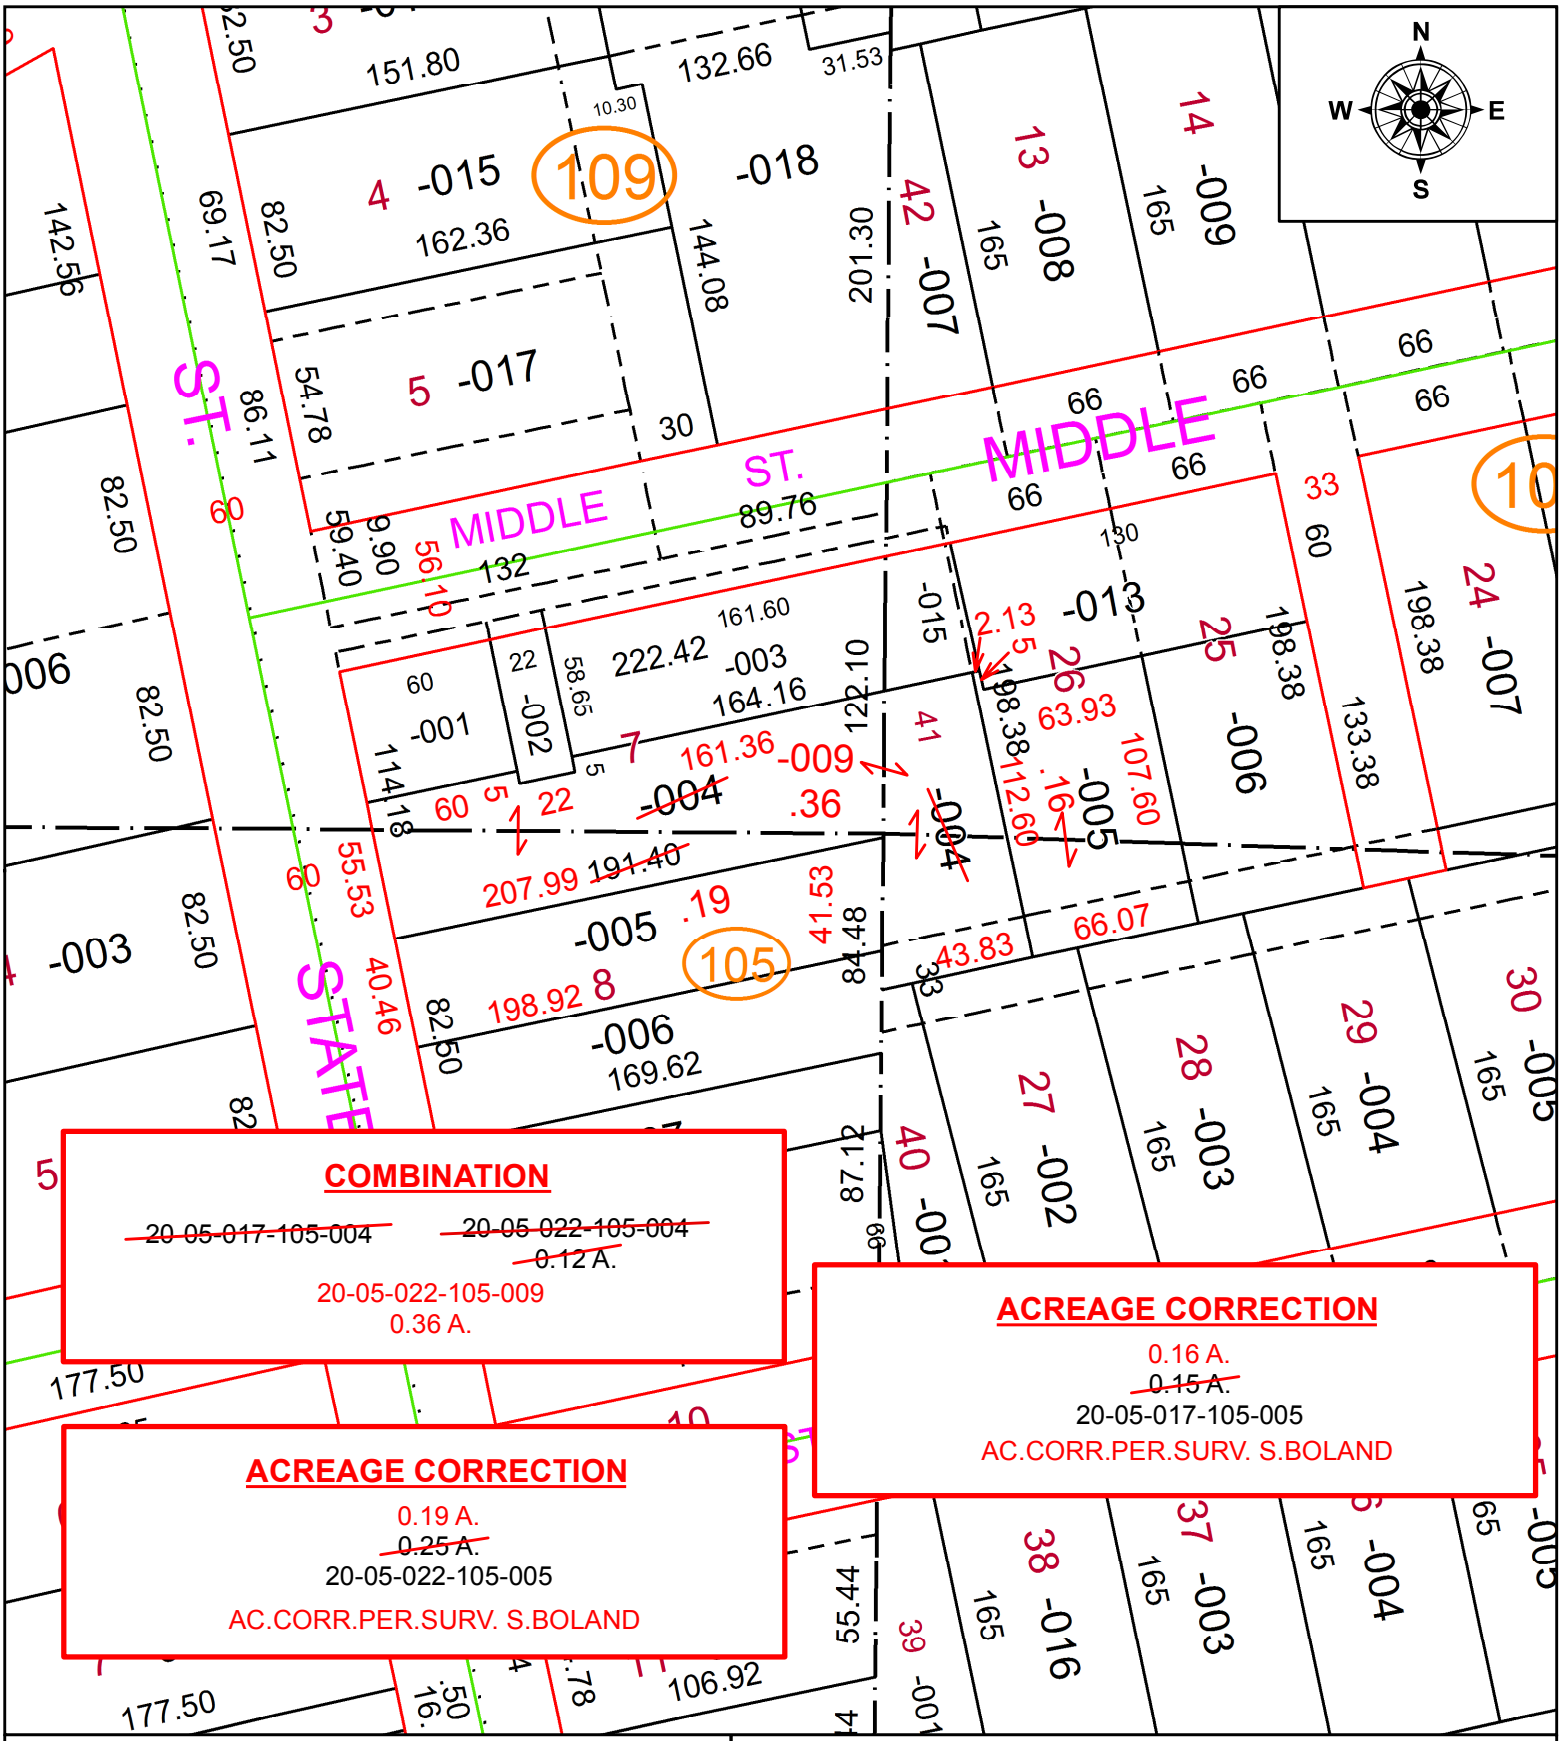

SPLITS/DEEDS PROCESSED

LORAIN COUNTY TAX MAP DEPARTMENT
226 MIDDLE AVE. ELYRIA, OH

SURVEYED BY: SEAN A. BOLAND
CLOSURE: 1:137,441
MAP PAGE(S): 20-05-022
APPOVED BY: RRM **DATE:** 6-3-20
SCALE: 1" = 75 **PRIOR INSTRUMENT:** 20190743006