PARENT PARCEL: 04-00-006-101-056 & -057

CHILD PARCEL: 04-00-006-101-091 0.29 A.

STARTING POINT: CL LAKE RD. & CL OF WEST SHORE RD.

21-04344

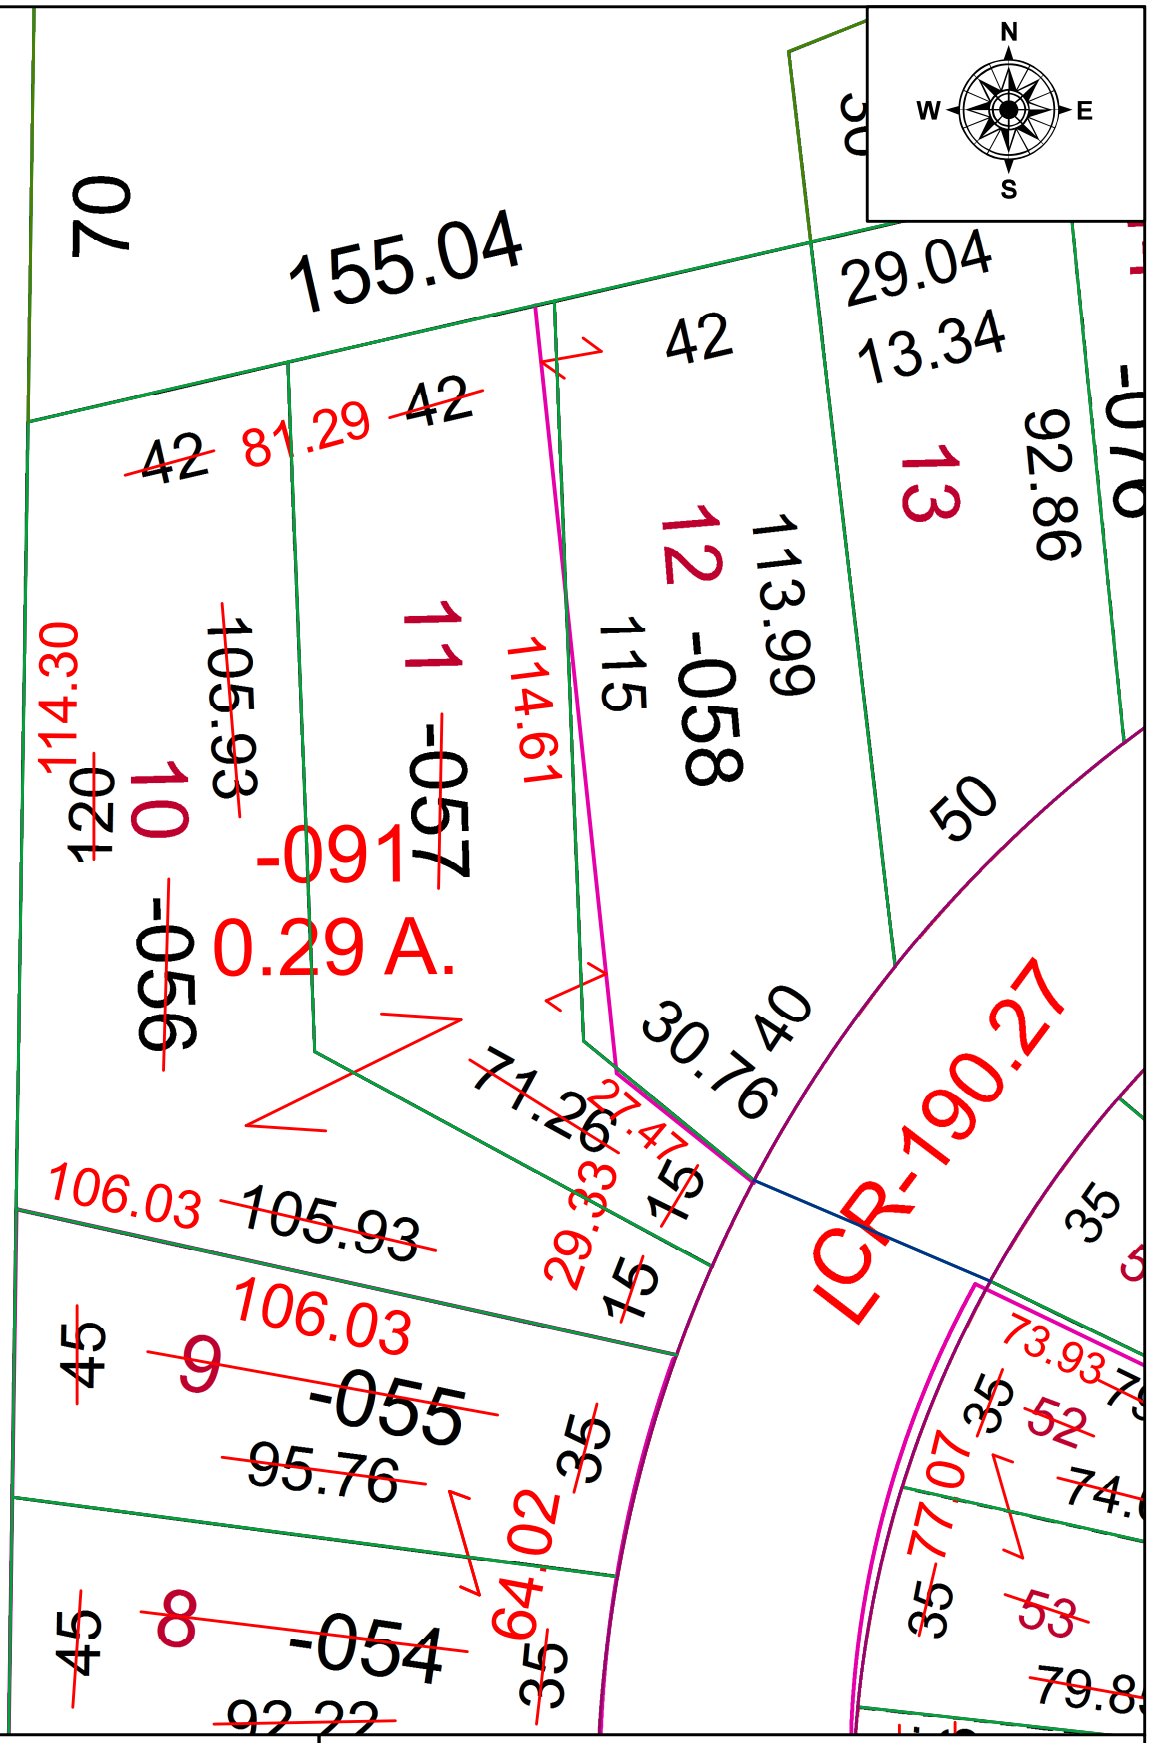

SPLITS/DEEDS PROCESSED

LORAIN COUNTY TAX MAP DEPARTMENT
226 MIDDLE AVE. ELYRIA, OH

SURVEYED BY: STEVE METCALF
CLOSURE: 1: 33,000
MAP PAGE(S): 04-00-006
APPOVED BY: TJS **DATE:** 8/24/2021
SCALE: 1" = 30' **PRIOR INSTRUMENT:** 2014-0505377