PARENT PARCEL: 03-00-037-101-032 UNCOMBINATION

CHILD PARCEL: 03-00-037-101-040 & -041

STARTING POINT: 257.73' WEST OF A 1/2" I.P FD., S.E. CORNER OF BLOCK "G" IN CORAL BEACH SUB.

20-04348-U

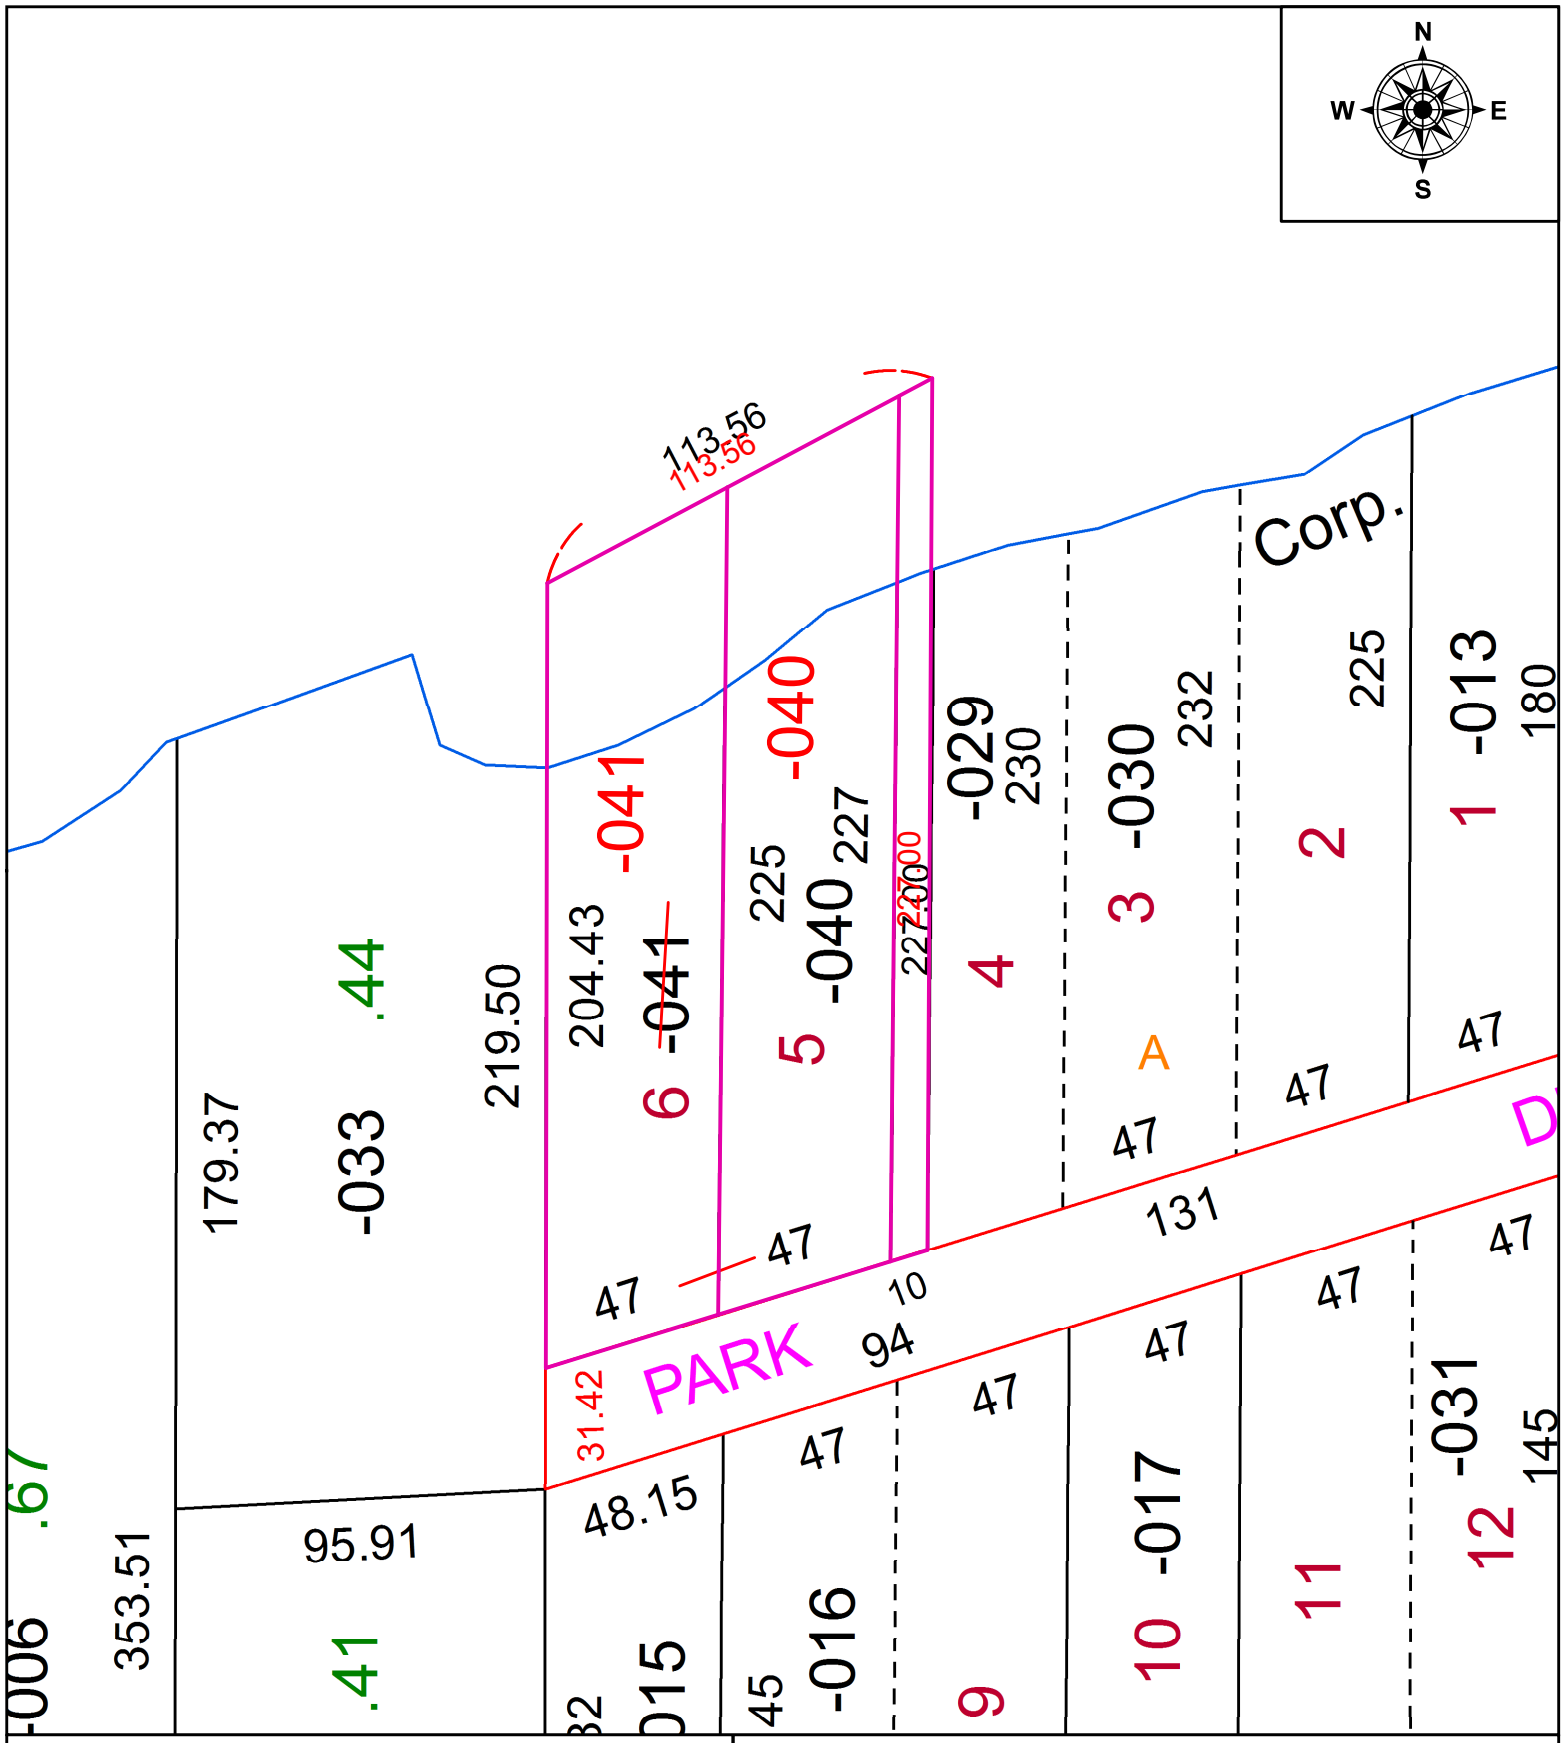

SPLITS/DEEDS PROCESSED

LORAIN COUNTY TAX MAP DEPARTMENT
226 MIDDLE AVE. ELYRIA, OH

SURVEYED BY: JAMES RESAR
CLOSURE: 1: 127,000
MAP PAGE(S): 03-00-037
APPOVED BY: TJS **DATE:** 6/9/2020
SCALE: 1" = 50' **PRIOR INSTRUMENT:** 2019-0731153