PARENT PARCEL: 16-00-025-101-004

CHILD PARCEL:

STARTING POINT: NORTHWEST CORNER OF O.L.25

20-04350-C

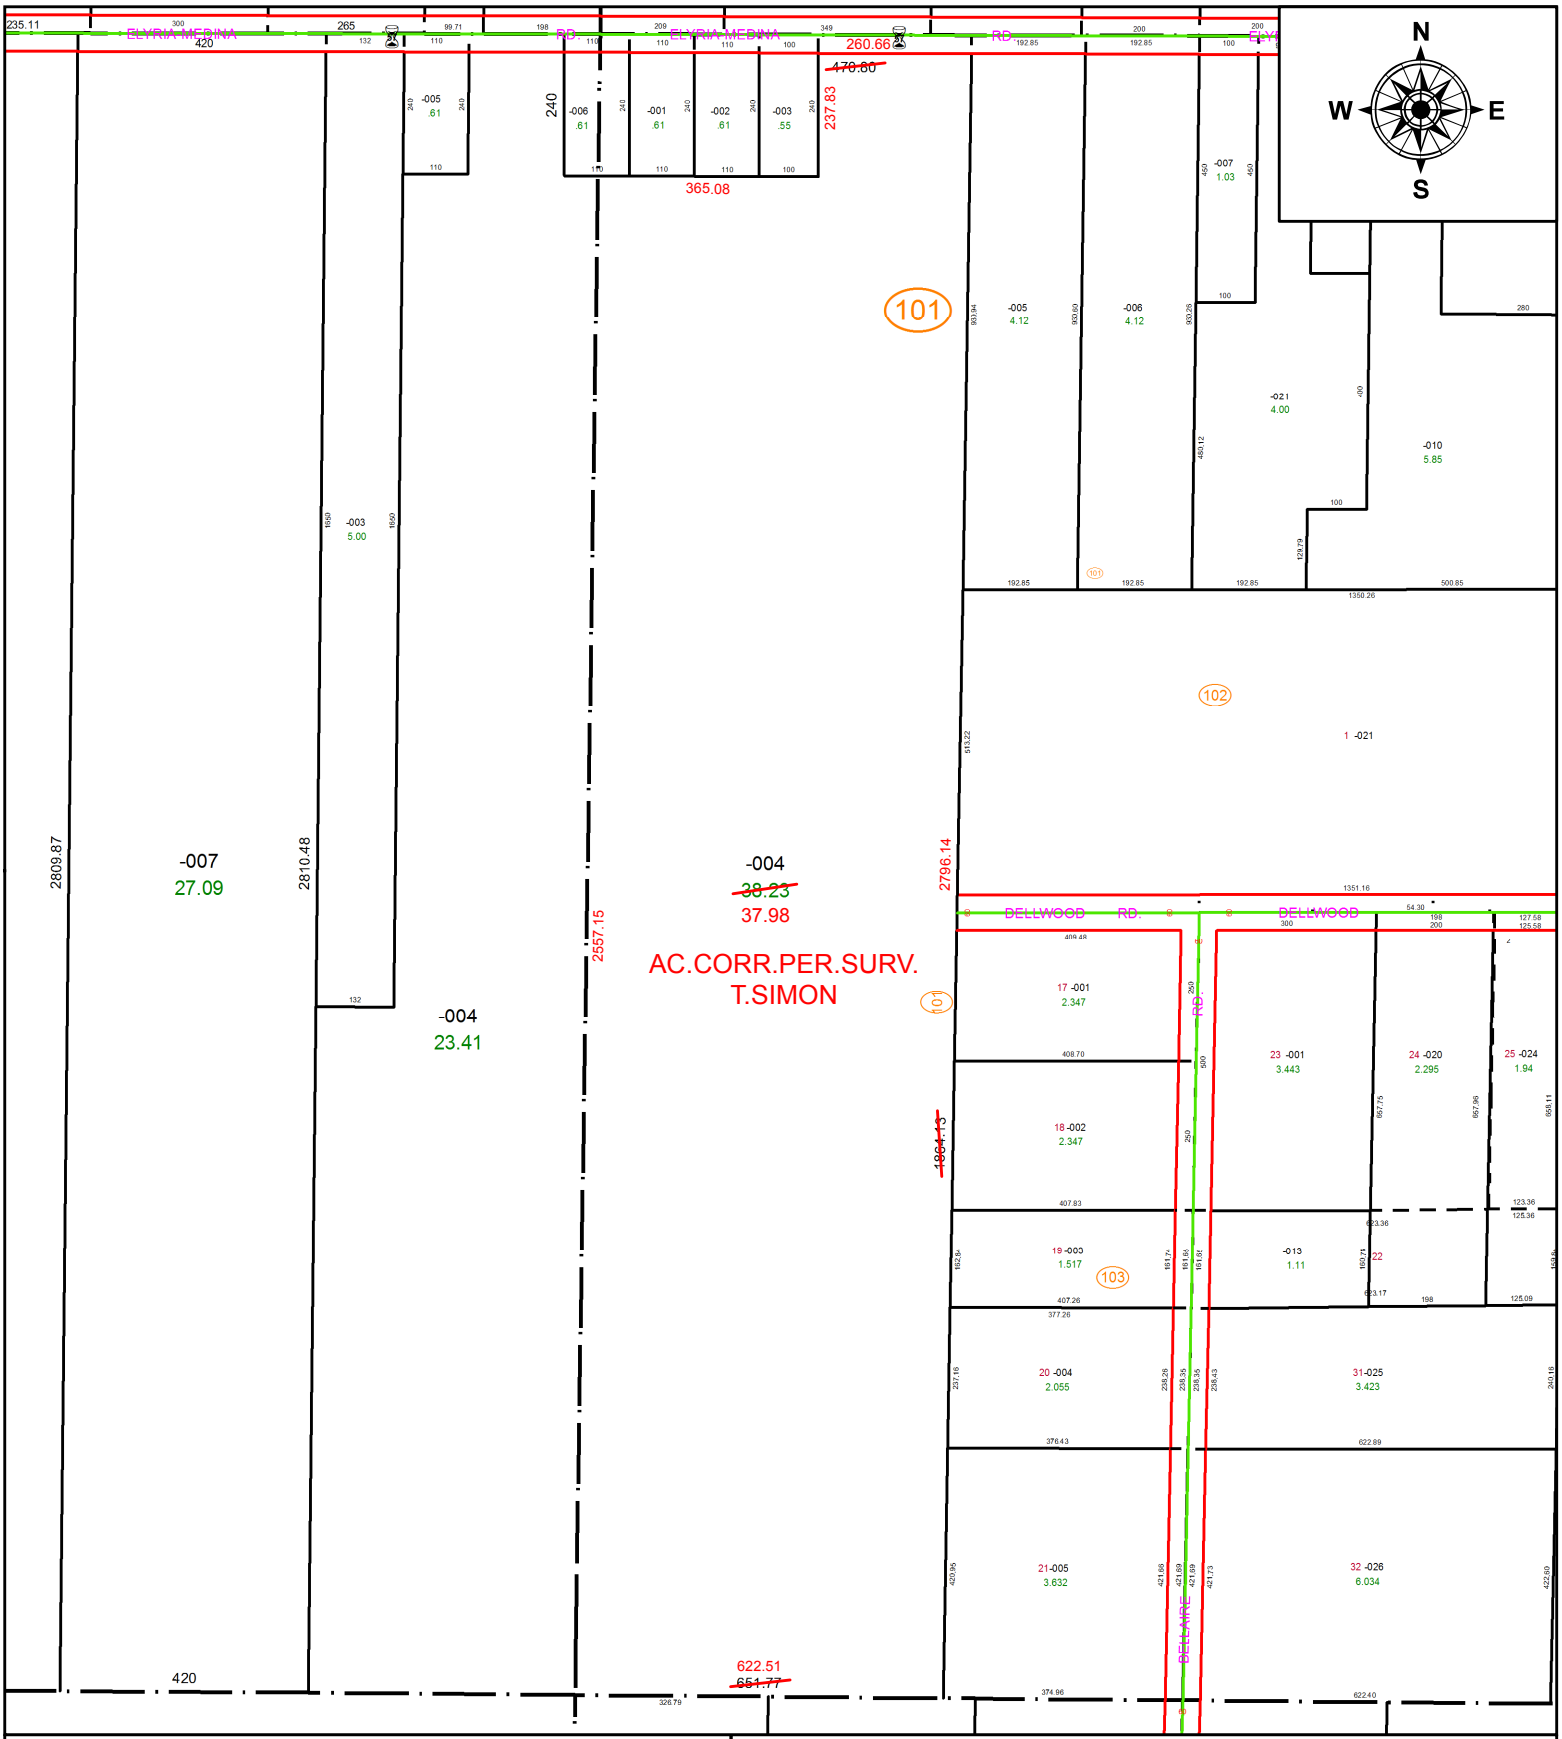

SPLITS/DEEDS PROCESSED

LORAIN COUNTY TAX MAP DEPARTMENT
226 MIDDLE AVE. ELYRIA, OH

SURVEYED BY: THOMAS A. SIMON
CLOSURE: 1:1,012,276
MAP PAGE(S): 16-00-025
APPOVED BY: RRM **DATE:** 6-15-20
SCALE: 1" = 325 **PRIOR INSTRUMENT:** 20180669472