PARENT PARCEL: 03-00-001-000-185 & -187

CHILD PARCEL: 03-00-001-000-204

STARTING POINT: CL OF ABBE RD & HOAG DR.

21-04350

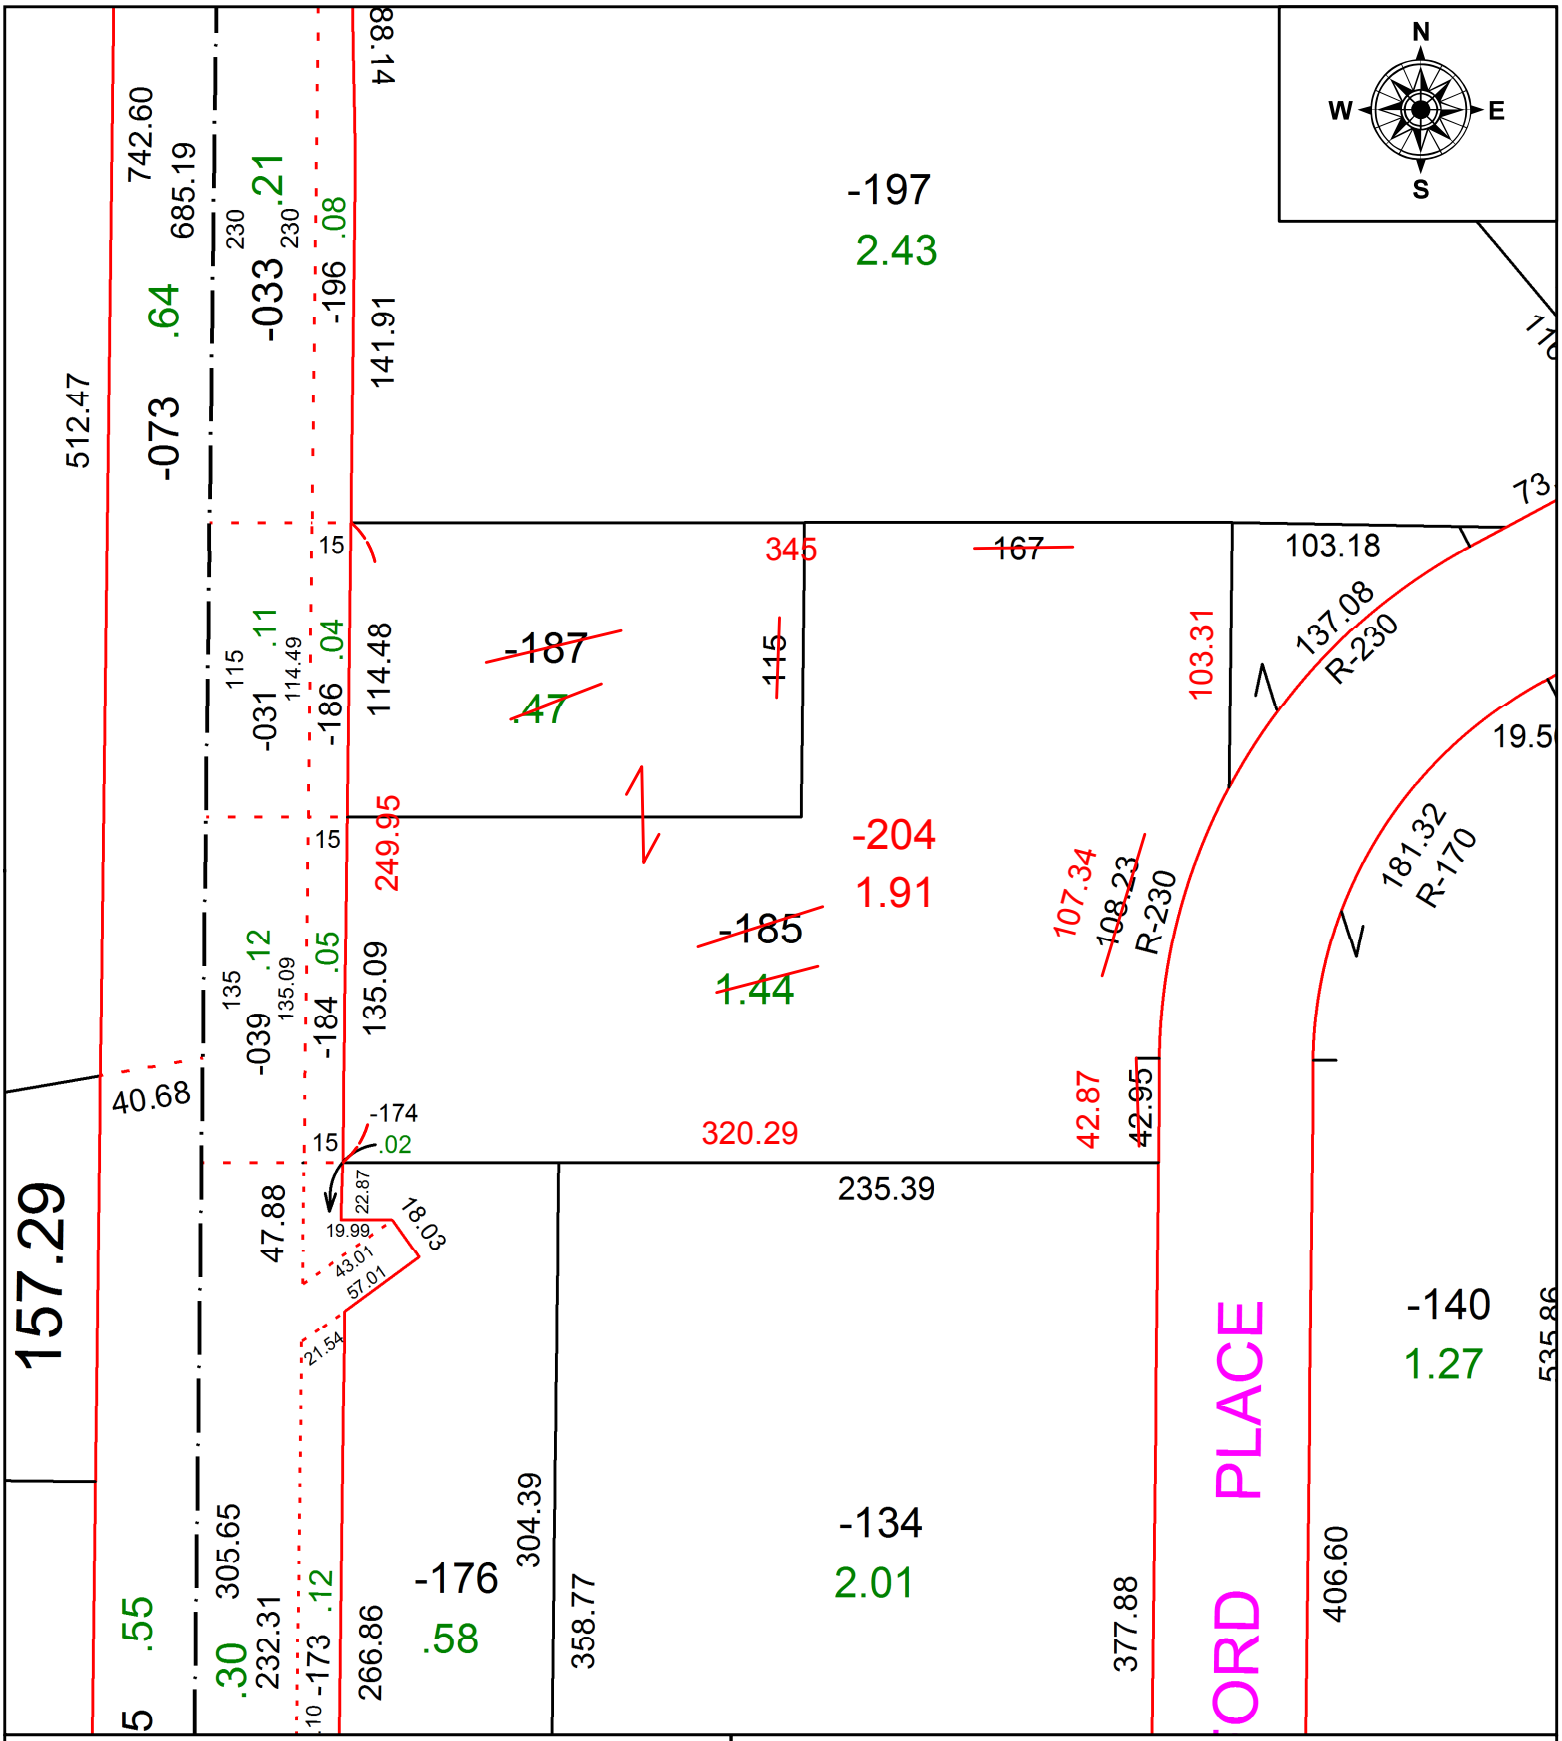

SPLITS/DEEDS PROCESSED

LORAIN COUNTY TAX MAP DEPARTMENT
226 MIDDLE AVE. ELYRIA, OH

SURVEYED BY: CHRISTOPHER DEMPSEY
CLOSURE: 1: 123,884
MAP PAGE(S): 03-00-001
APPOVED BY: DMA **DATE:** 8/19/2021
SCALE: 1" = 75' **PRIOR INSTRUMENT:** 20210833744