PARENT PARCEL: 09-00-064-000-001
CHILD PARCEL: 09-00-064-000-017, -018, -019
STARTING POINT: CL OF BUTTERNUT RIDGE RD. & PYLE SOUTH AMHERST RD.

21-04351

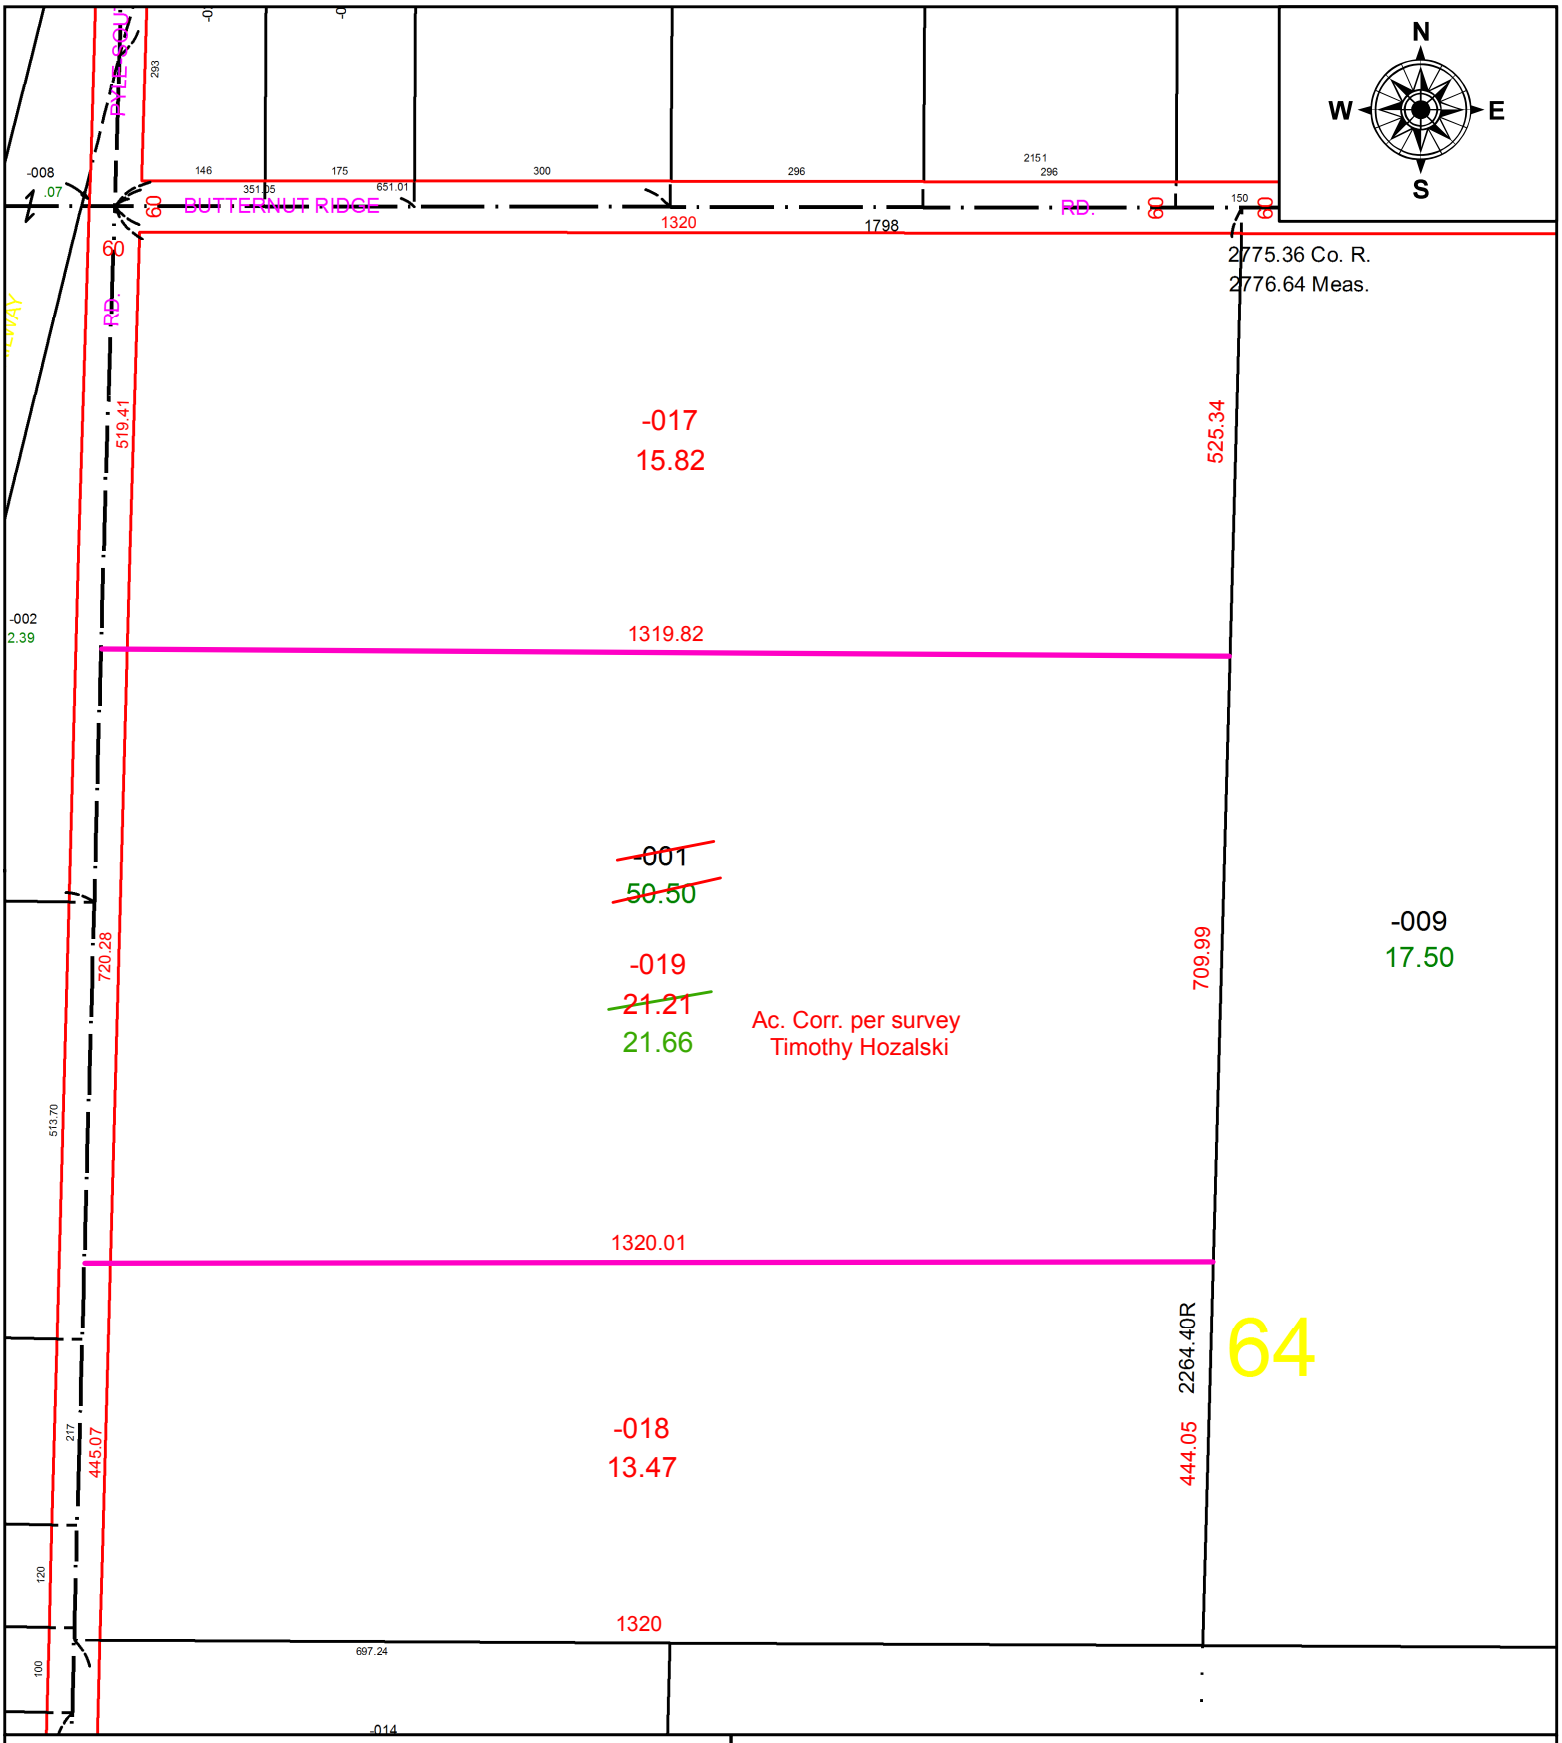

SPLITS/DEEDS PROCESSED
LORAIN COUNTY TAX MAP DEPARTMENT
226 MIDDLE AVE. ELYRIA, OH

SURVEYED BY: TIMOTHY HOZALSKI
CLOSURE: 1: 323,643
MAP PAGE(S): 09-00-064
APPOVED BY: DMA **DATE:** 8/19/2021
SCALE: 1" = 225' **PRIOR INSTRUMENT:** 20200760684