PARENT PARCEL: 06-24-005-000-005 & -056

CHILD PARCEL: 06-24-005-000-057 THRU -059

STARTING POINT: INTERSECTION OF C/L OF MURRAY RIDGE RD & NORTH LINE OF OL 5, WEST OF THE BLACK RIVER

21-04355

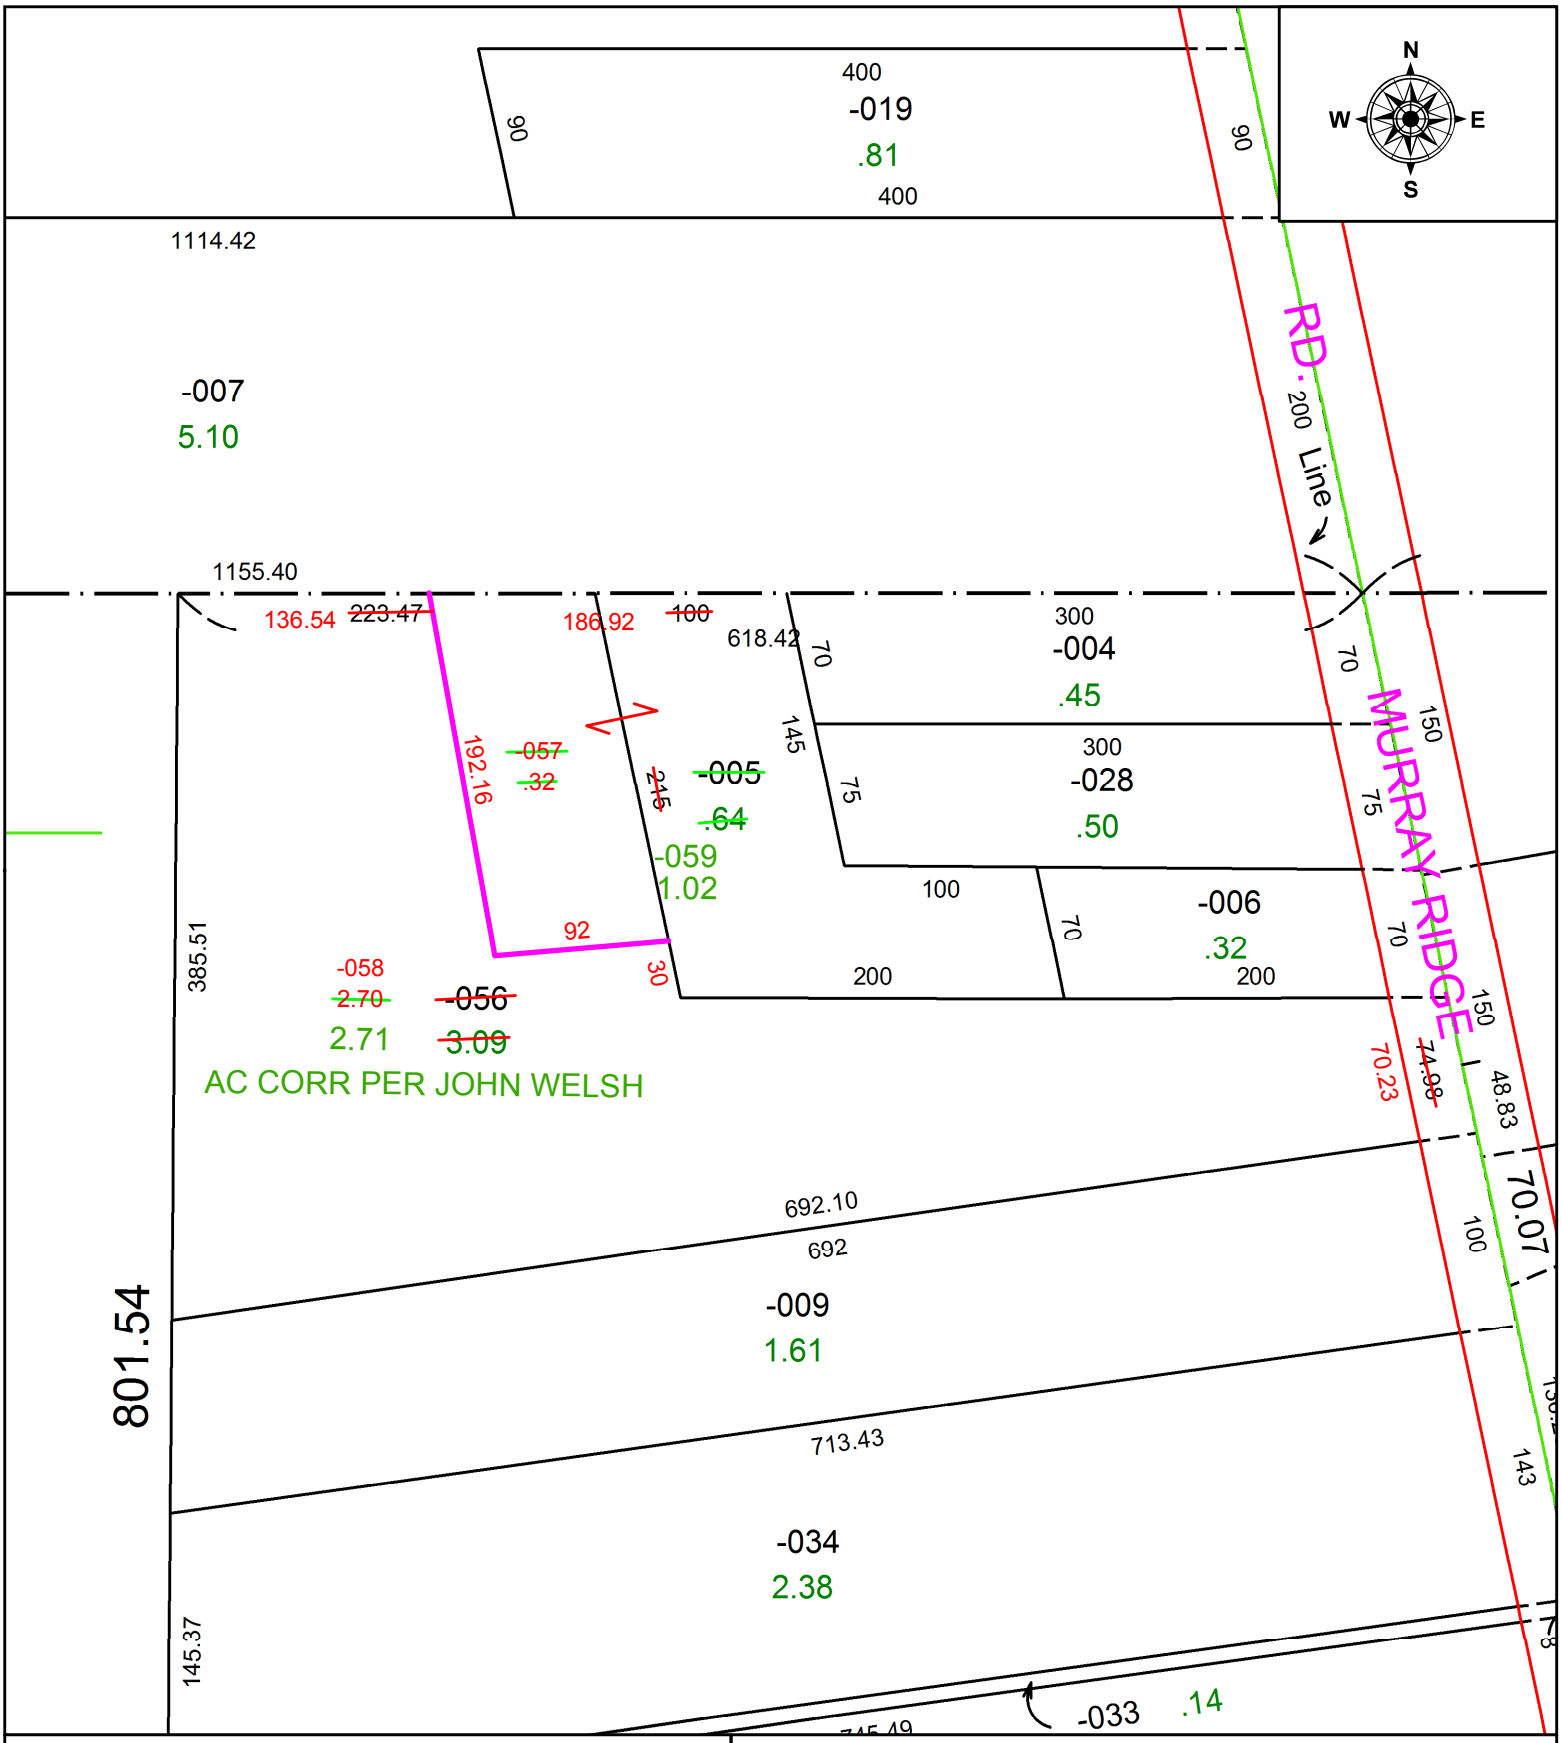

SPLITS/DEEDS PROCESSED

LORAIN COUNTY TAX MAP DEPARTMENT
226 MIDDLE AVE. ELYRIA, OH

SURVEYED BY: JOHN WELSH
CLOSURE: 1: 78,718
MAP PAGE(S): 06-24-005
APPOVED BY: WRZ **DATE:** 8/30/2021
SCALE: 1" = 100 **PRIOR INSTRUMENT:** 2017-0624817