PARENT PARCEL: 13-11-010-000-004

CHILD PARCEL:

STARTING POINT: SOUTHWEST CORNER OF O.L.20 TR. 12

20-04356-C

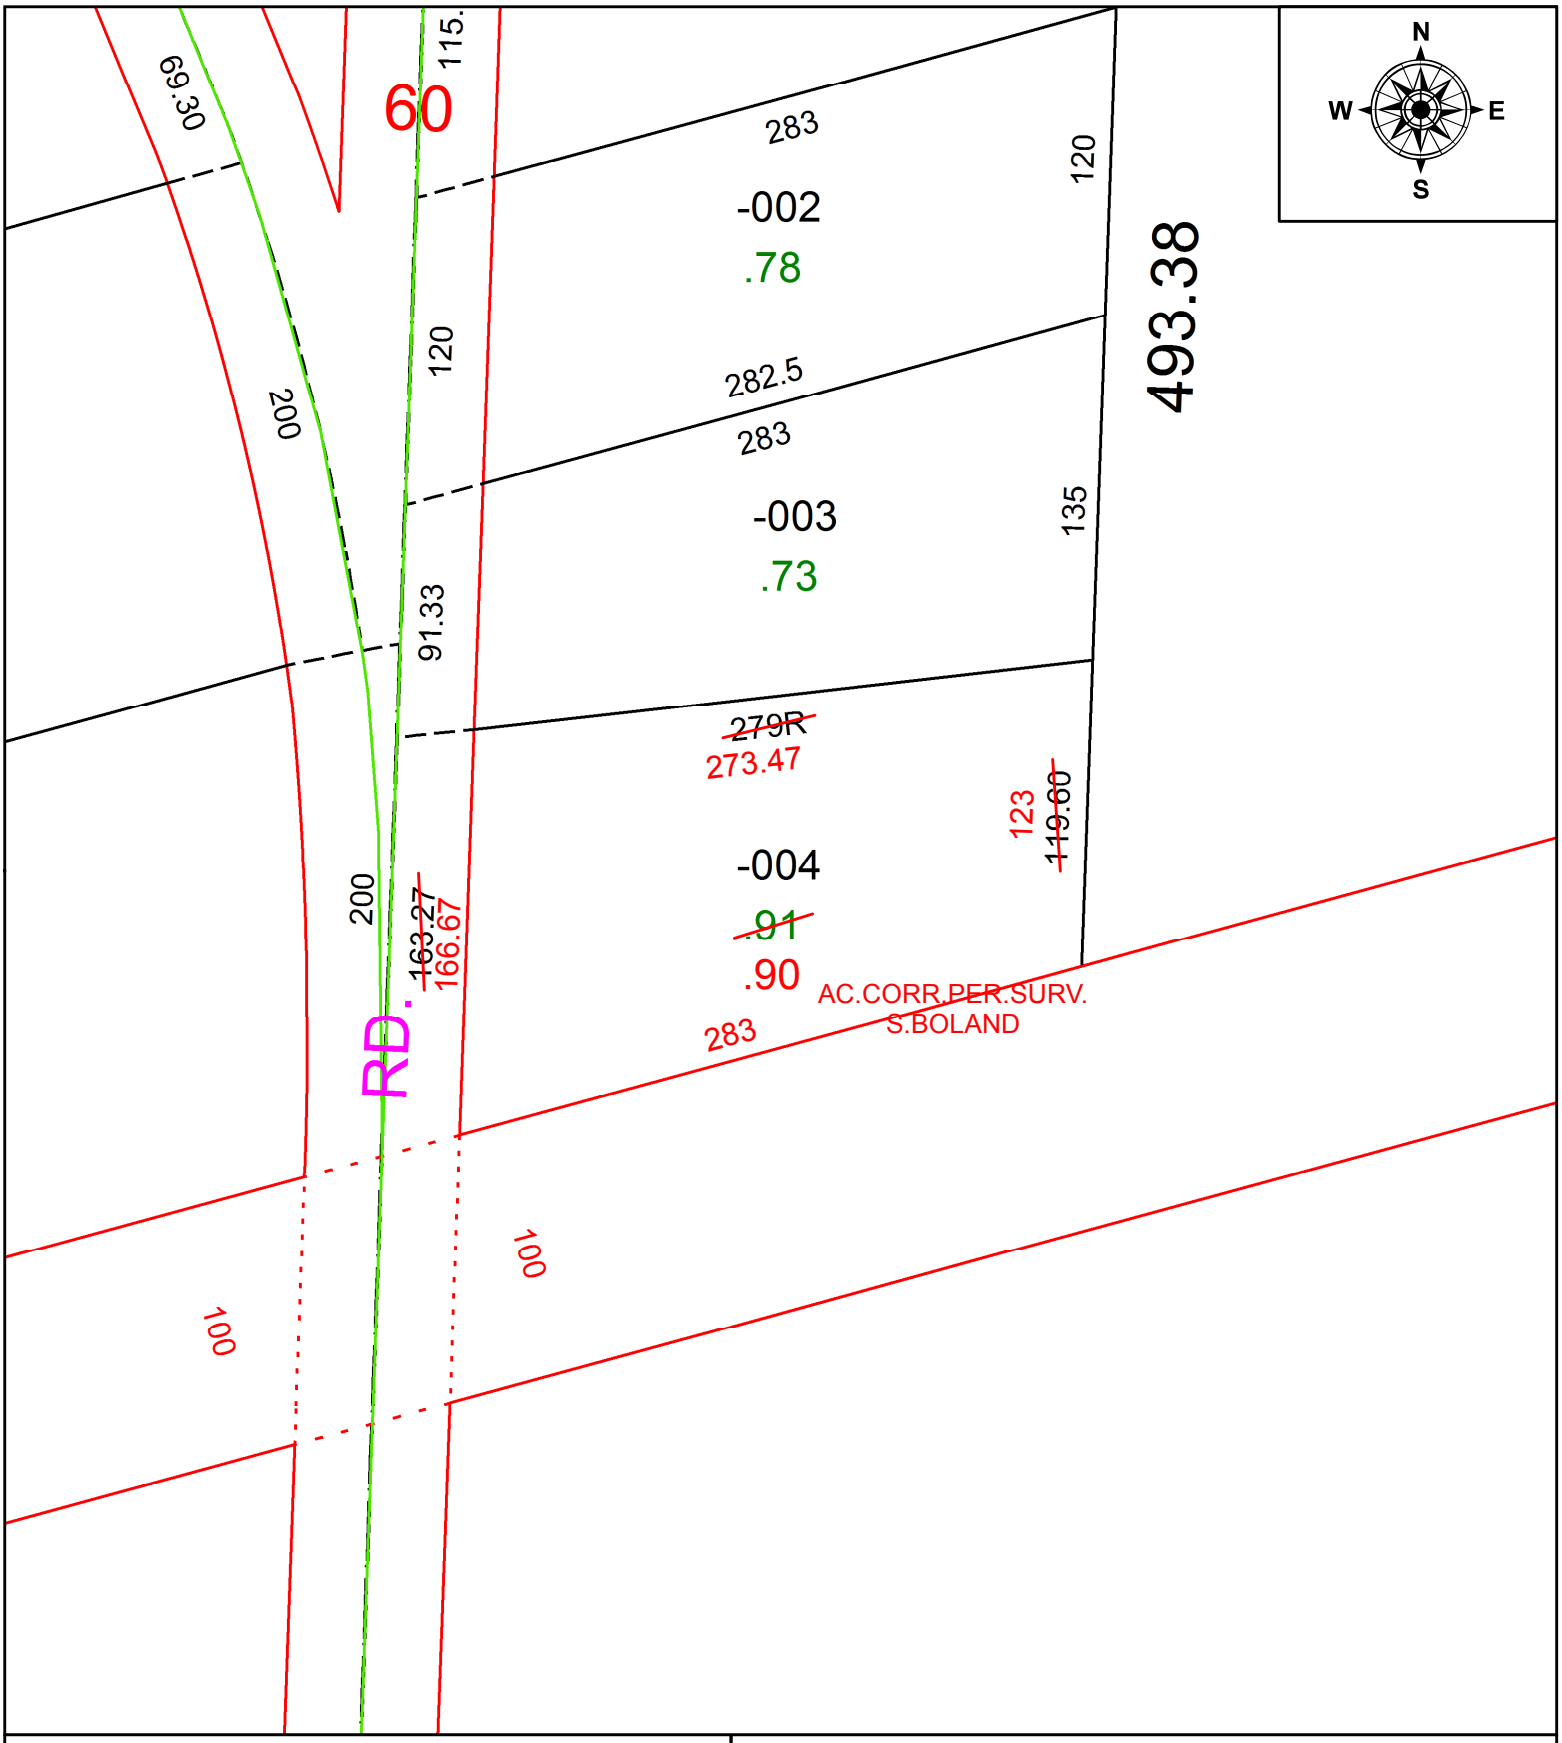

SPLITS/DEEDS PROCESSED

LORAIN COUNTY TAX MAP DEPARTMENT
226 MIDDLE AVE. ELYRIA, OH

SURVEYED BY: SEAN A. BOLAND
CLOSURE: 1:125,189
MAP PAGE(S): 13-11-010
APPOVED BY: RRM **DATE:** 6-25-20
SCALE: 1" = 75 **PRIOR INSTRUMENT:** 20200755905