PARENT PARCEL: 05-00-010-102-046

CHILD PARCEL:

STARTING POINT: INTERSECTION OF C/L OF S. LAKE ST. AND SOUTH LINE OF O.L.10

20-04357-D

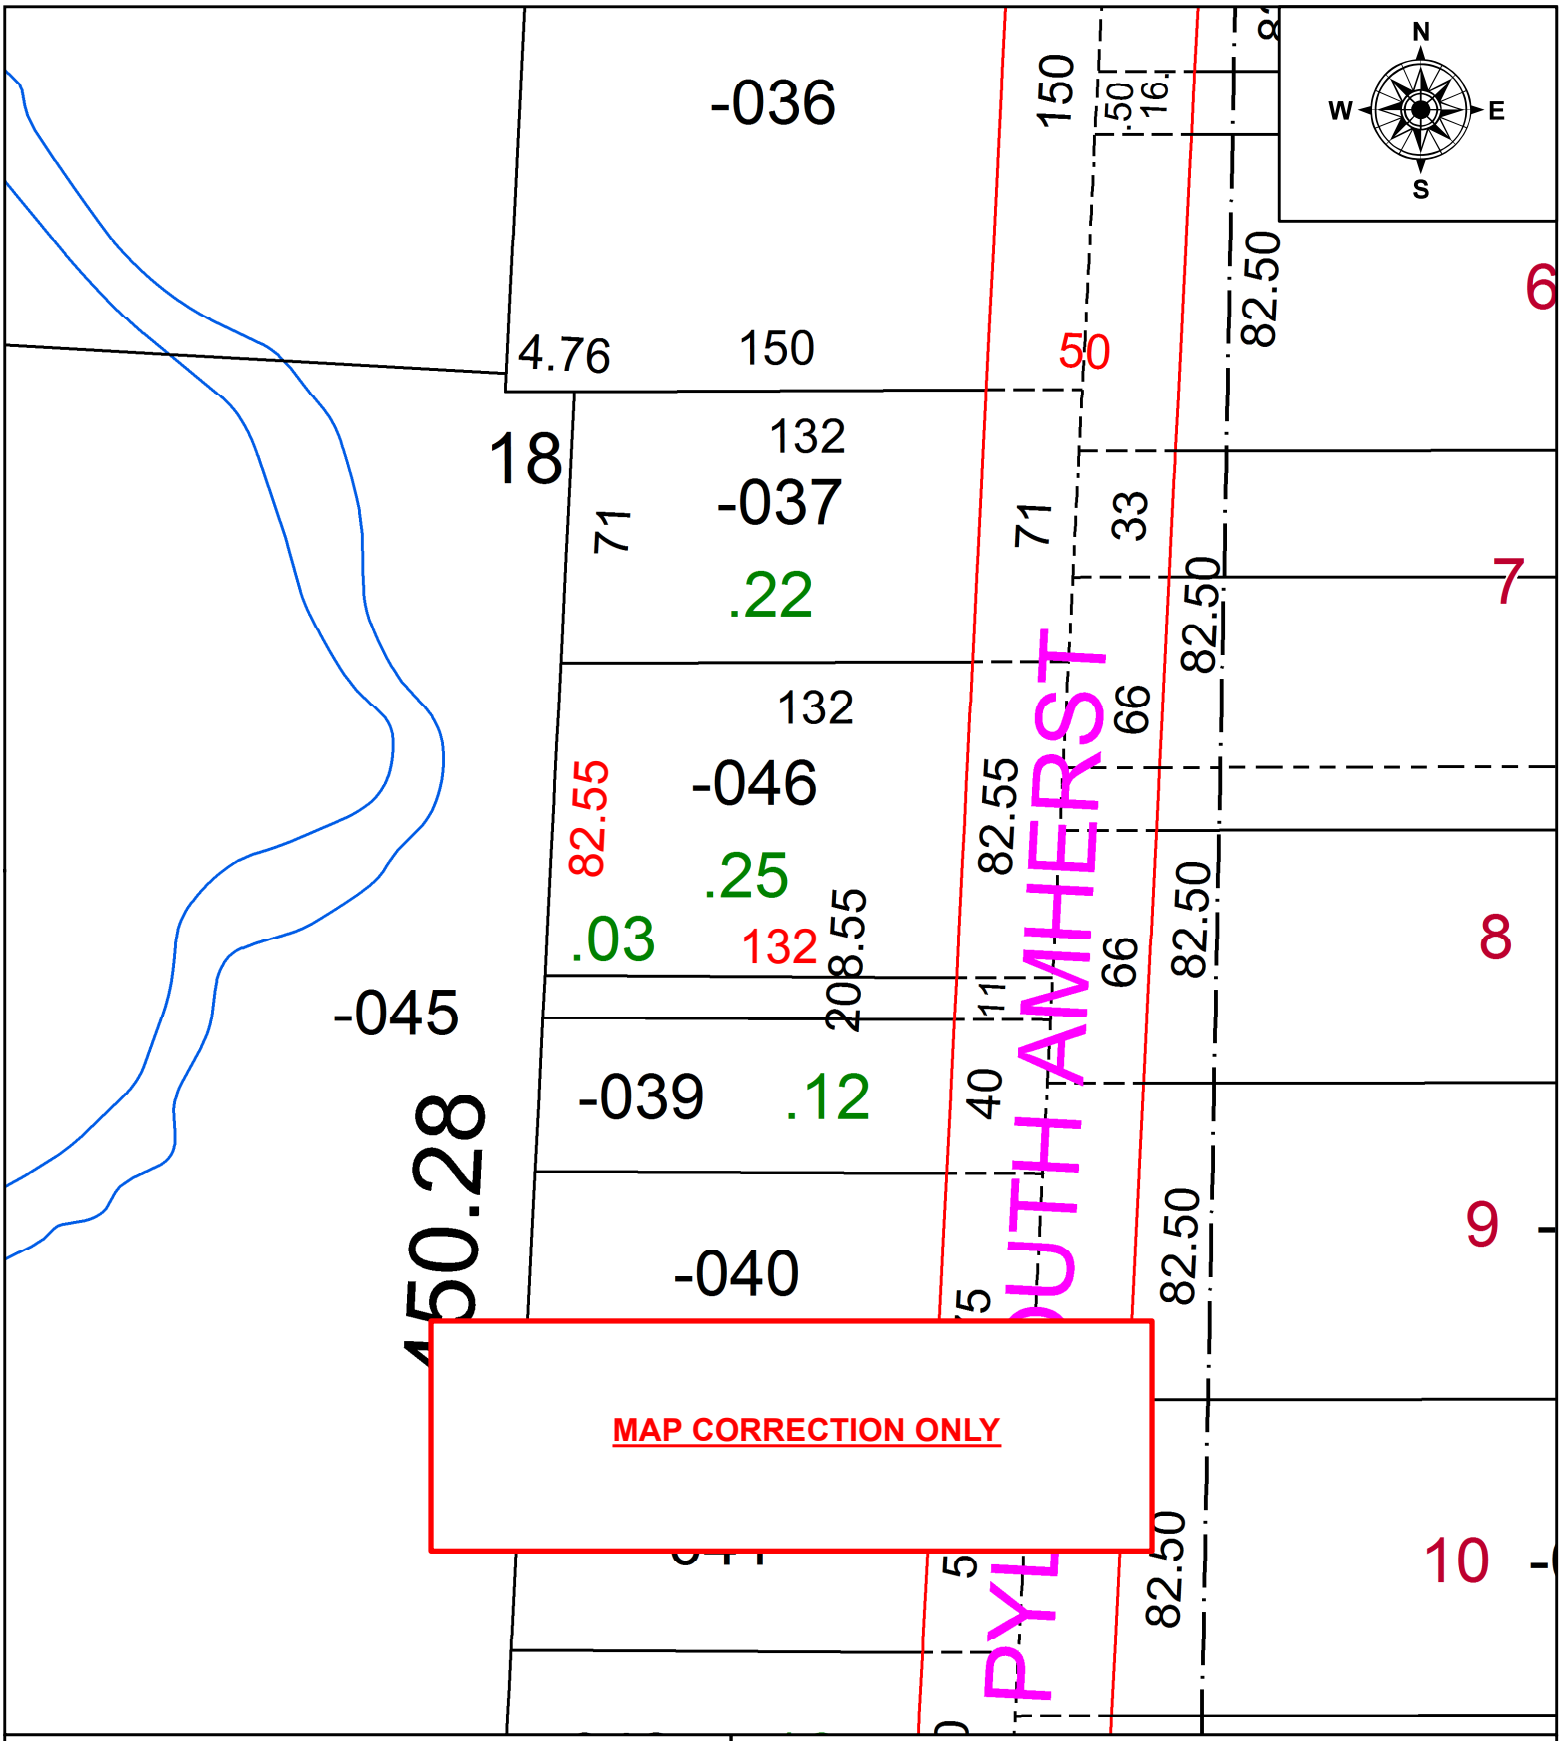

SPLITS/DEEDS PROCESSED

LORAIN COUNTY TAX MAP DEPARTMENT
226 MIDDLE AVE. ELYRIA, OH

SURVEYED BY: ROBERT M. RUFFING
CLOSURE: 1: 2147483648
MAP PAGE(S): 5-00-010
APPOVED BY: RRM **DATE:** 6-25-20
SCALE: 1" = 50 **PRIOR INSTRUMENT:** 20170633395