PARENT PARCEL: ADD TO DUPLICATE - PER OR 106/339 & PV. 15 PG. 8

CHILD PARCEL: 03-00-108-102-033 24.50 X 69.90

STARTING POINT: S/L 1 BROADWAY GARDENS ALLOT.

20-04358-C

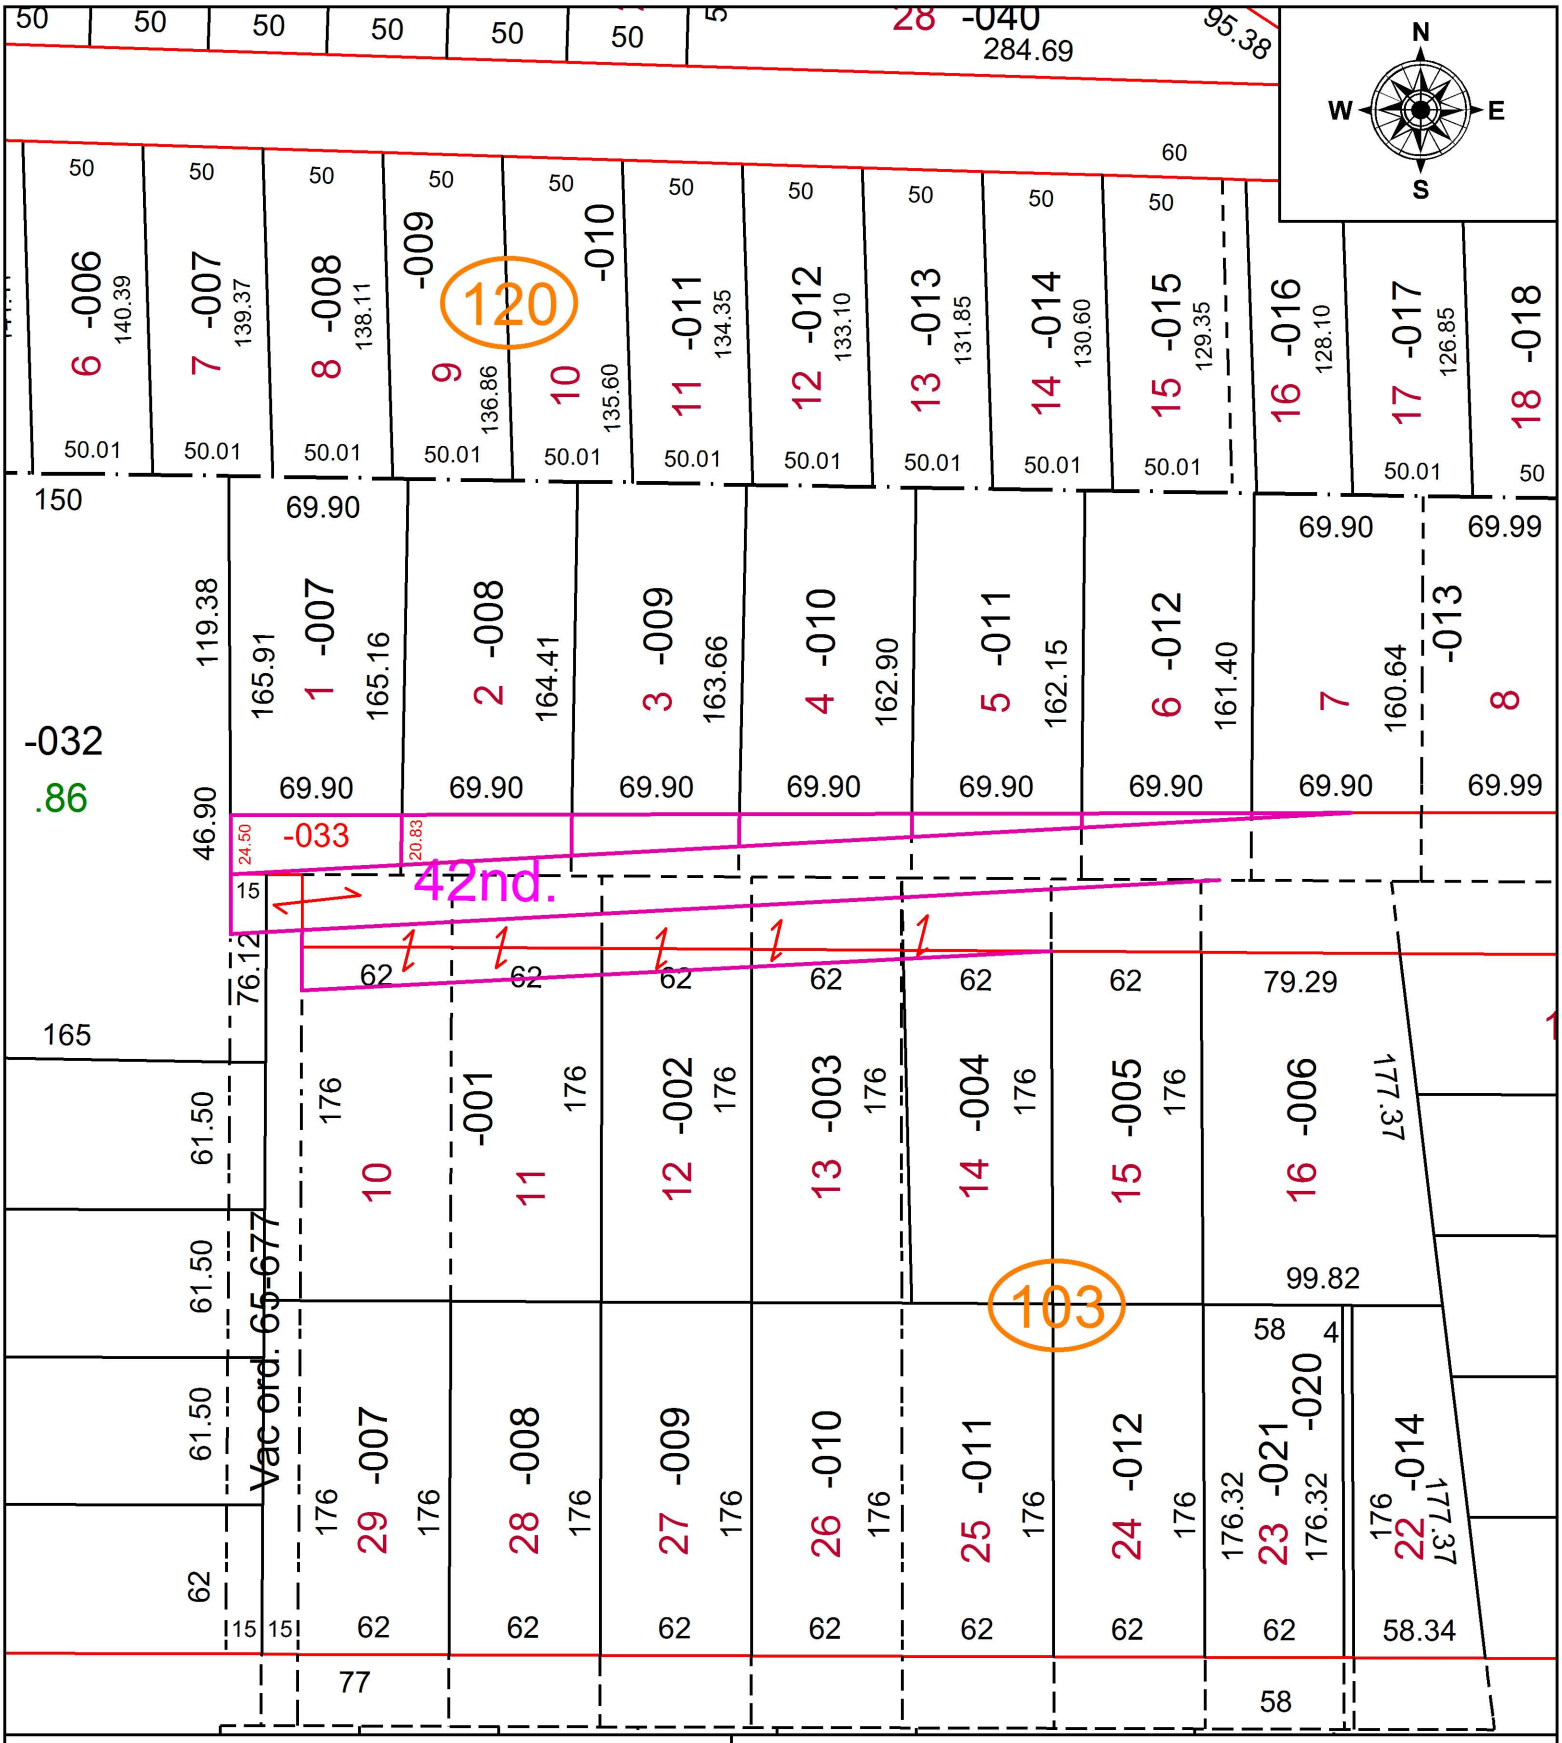

SPLITS/DEEDS PROCESSED

LORAIN COUNTY TAX MAP DEPARTMENT
226 MIDDLE AVE. ELYRIA, OH

SURVEYED BY: NA
CLOSURE: NA
MAP PAGE(S): 03-00-108
APPOVED BY: TJS **DATE:** 6/29/2020
SCALE: 1" = 80' **PRIOR INSTRUMENT:** OR 106/339