PARENT PARCEL: 02-02-027-105-009

CHILD PARCEL: 02-02-027-105-010, -011

STARTING POINT: S/L 23 IN BLK 3 OF HOGAN'S SECOND ADD.

20-04367-C

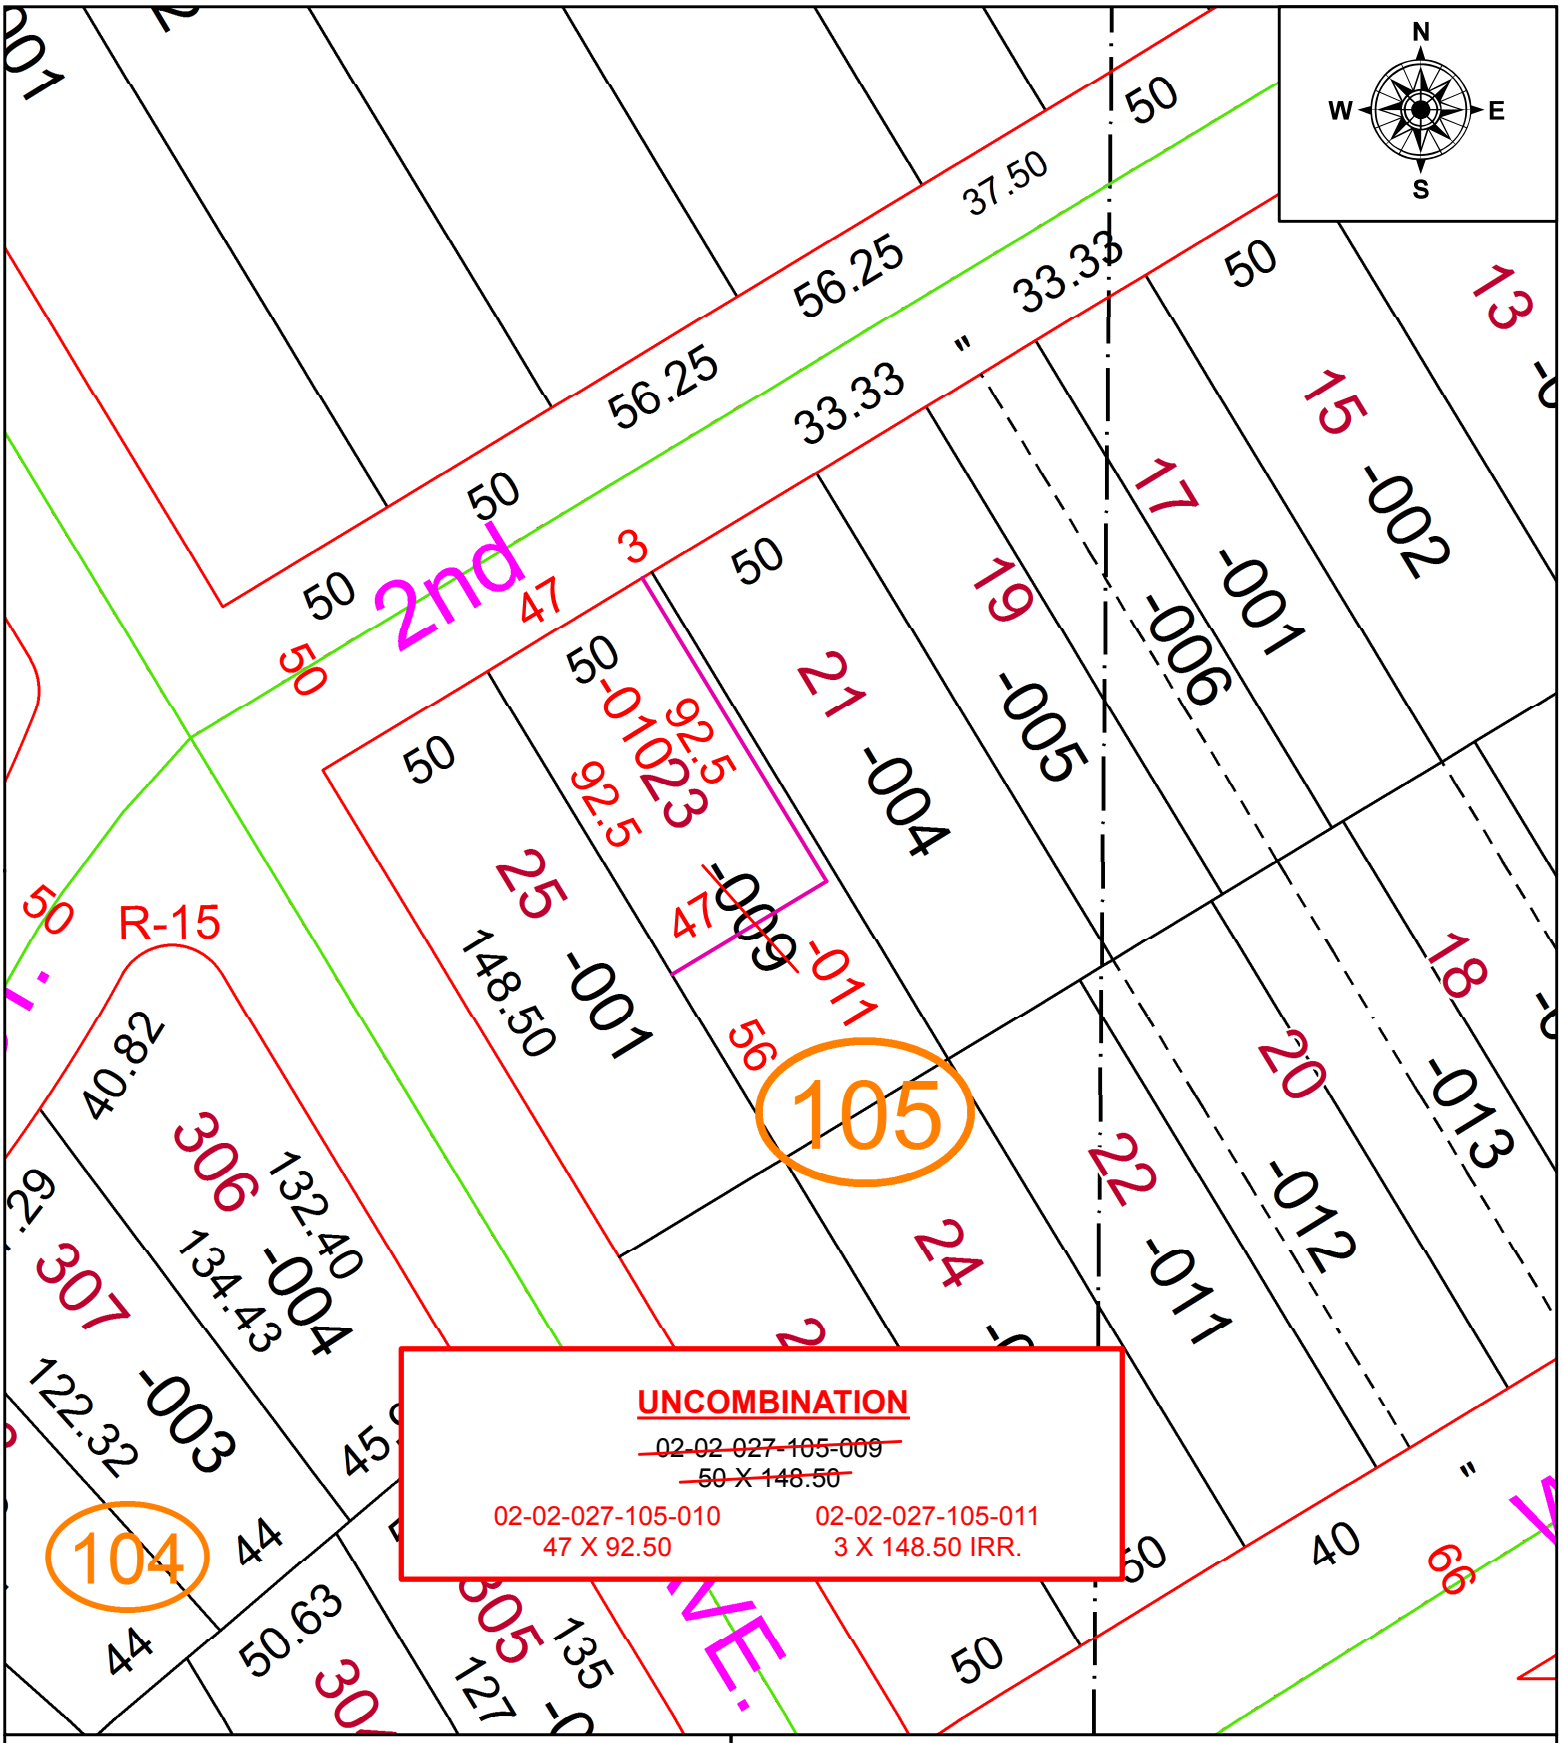

SPLITS/DEEDS PROCESSED

LORAIN COUNTY TAX MAP DEPARTMENT
226 MIDDLE AVE. ELYRIA, OH

SURVEYED BY: N/A
CLOSURE: N/A
MAP PAGE(S): 2-02-027
APPOVED BY: RRM **DATE:** 7-13-20
SCALE: 1" = 50 **PRIOR INSTRUMENT:** 20190741266