PARENT PARCEL: 03-00-012-000-192

CHILD PARCEL: 03-00-012-000-198 & -199

STARTING POINT: INTERSECTION OF C/L OF N. RIDGE RD & O.L. 11 & 73

21-04367

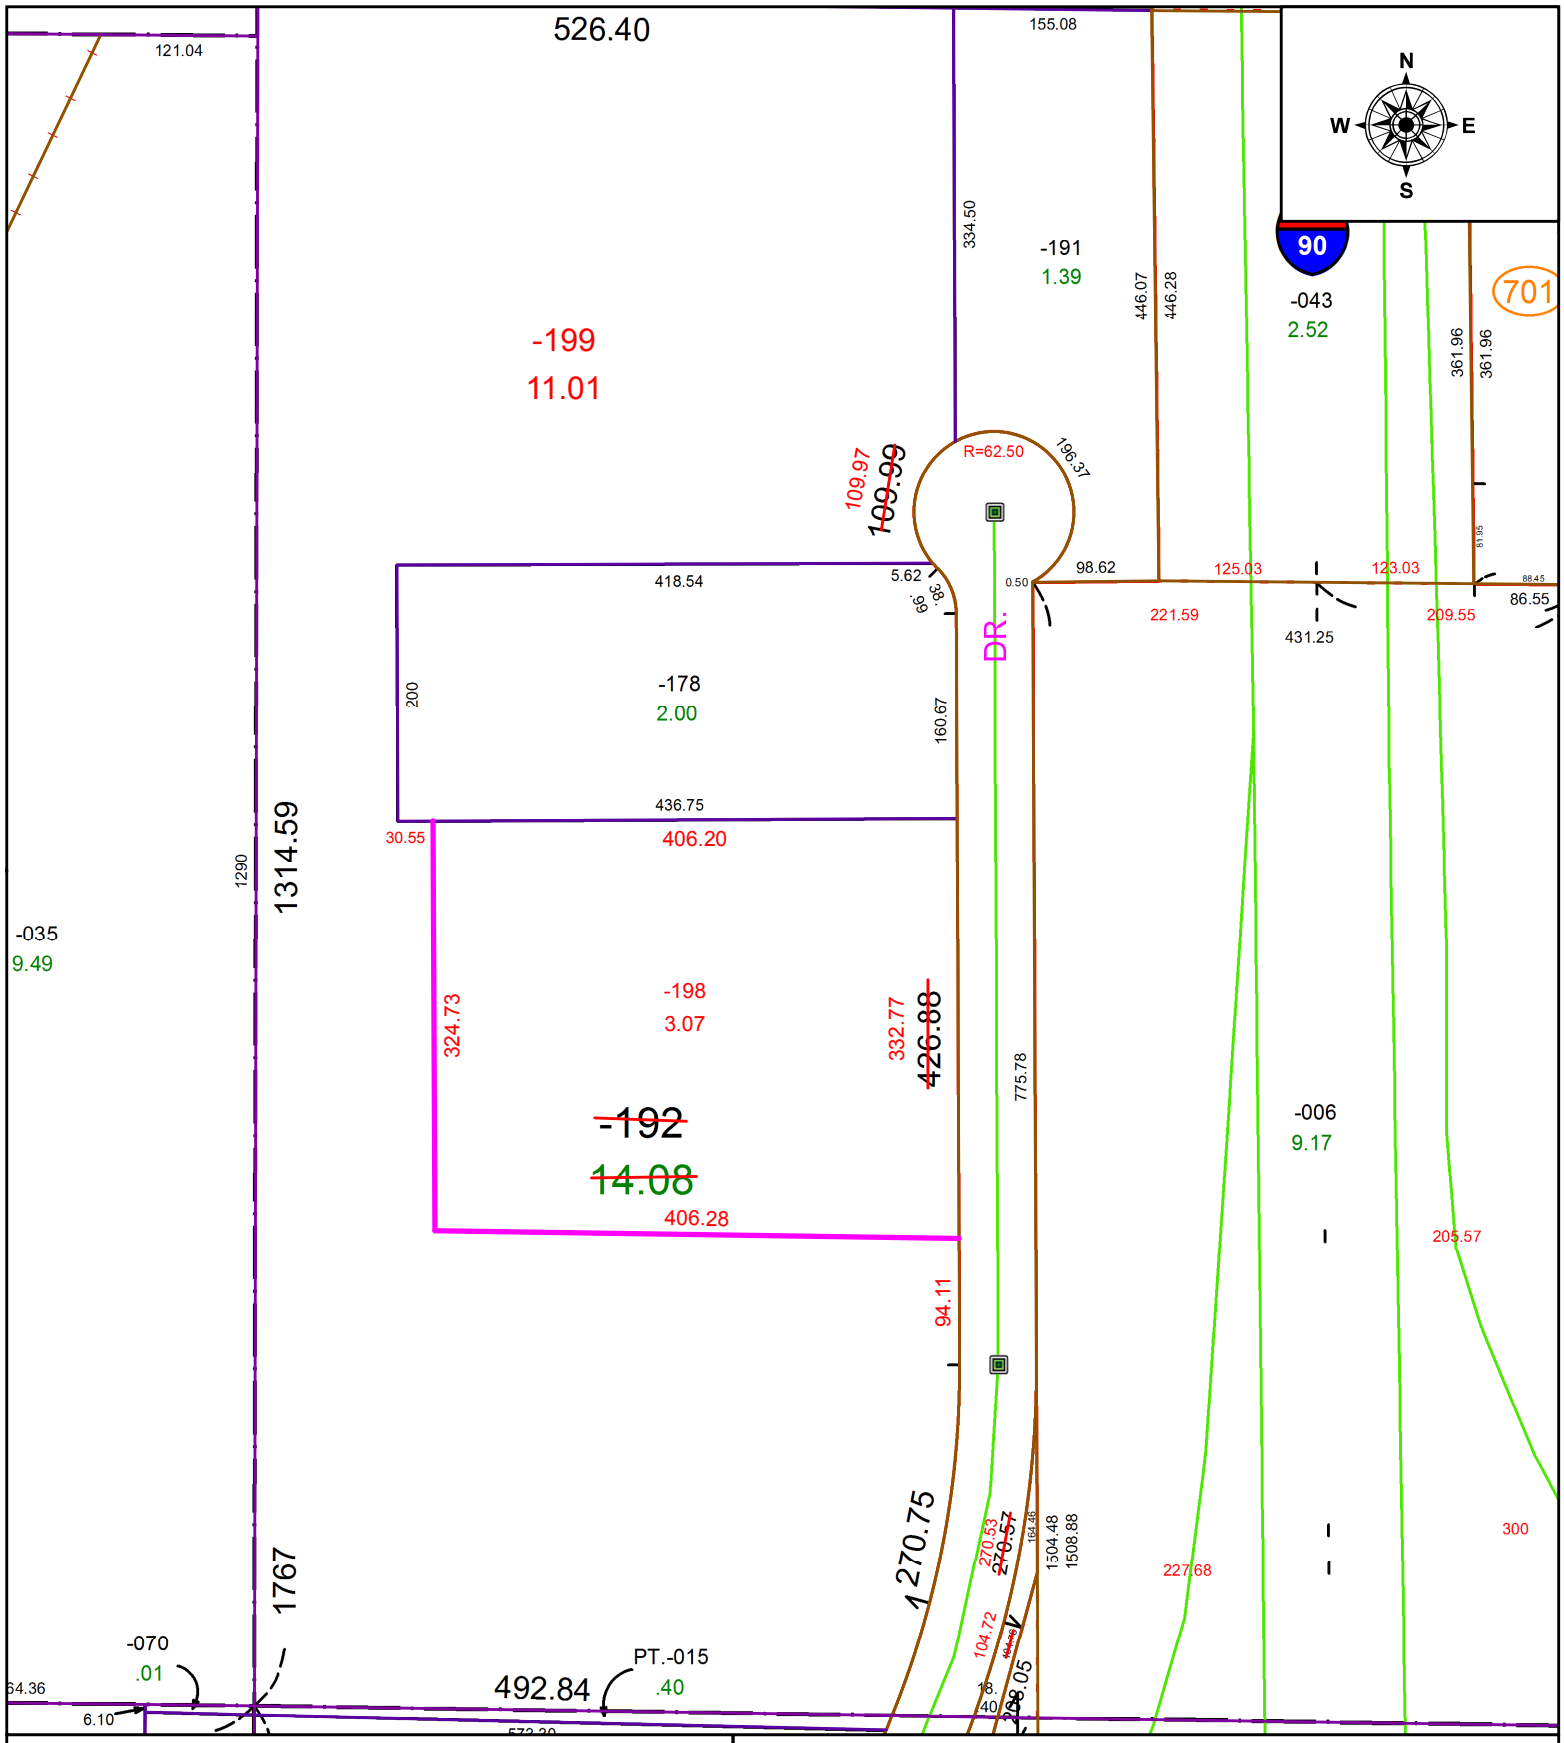

SPLITS/DEEDS PROCESSED

LORAIN COUNTY TAX MAP DEPARTMENT
226 MIDDLE AVE. ELYRIA, OH

SURVEYED BY: AMY KELLY
CLOSURE: 1: 812,230
MAP PAGE(S): 03-00-012
APPOVED BY: WRZ **DATE:** 9/9/2021
SCALE: 1" = 125 **PRIOR INSTRUMENT:** 1999-0593447