PARENT PARCEL: 03-00-046-104-010
CHILD PARCEL: 03-00-046-104-017, 03-00-047-110-021
STARTING POINT: S/L 63 IN COLLAR DAY ALLOT.

20-04368-U

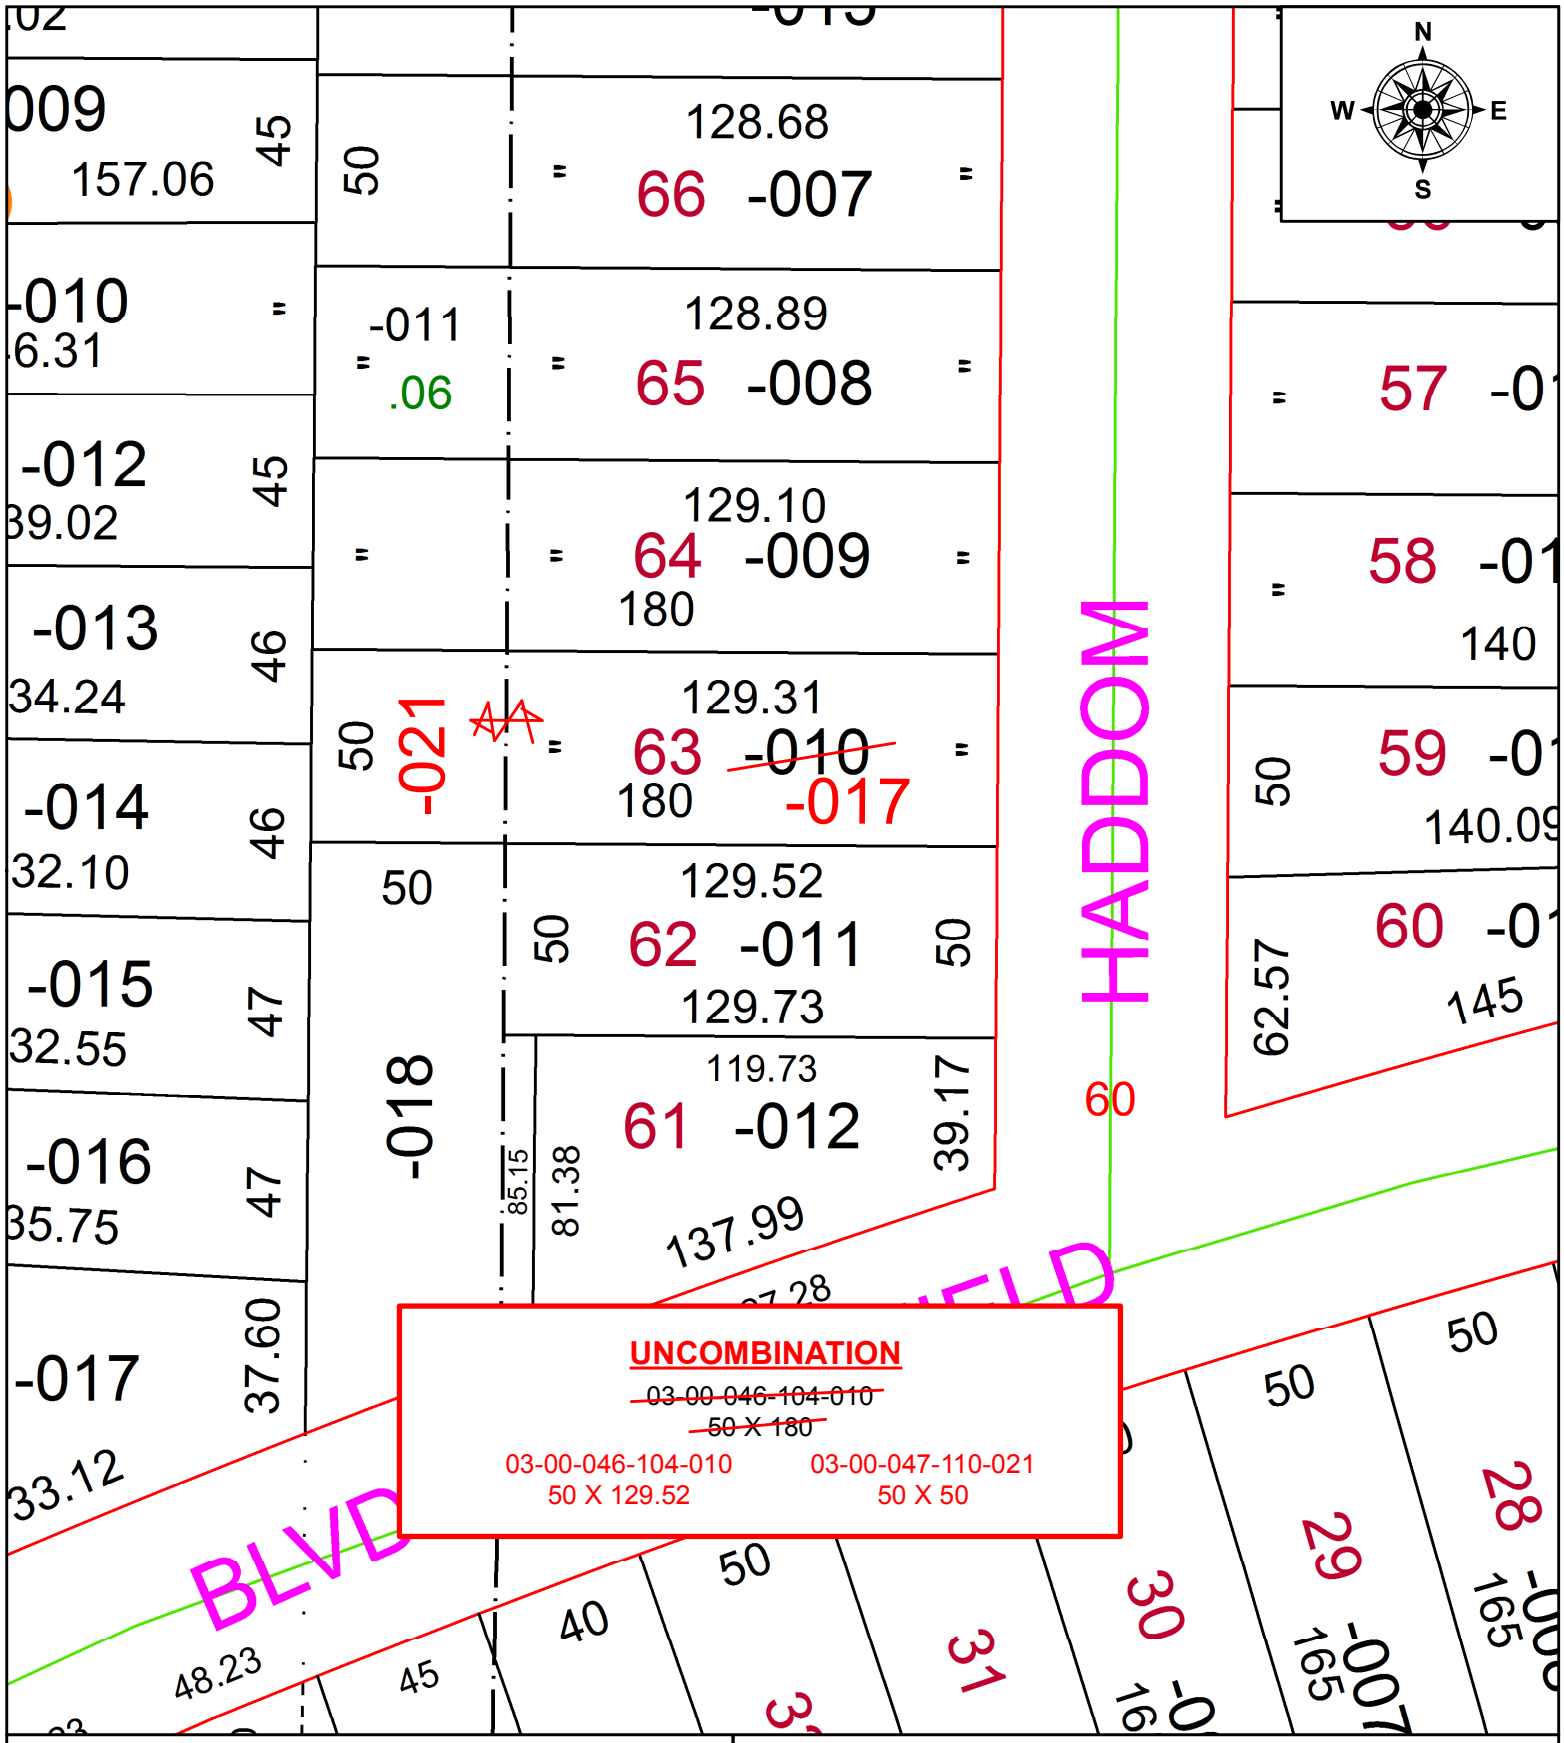

UNCOMBINATION

~~03-00-046-104-010~~
~~50 X 180~~

03-00-046-104-010
50 X 129.52

03-00-047-110-021
50 X 50

SPLITS/DEEDS PROCESSED
LORAIN COUNTY TAX MAP DEPARTMENT
226 MIDDLE AVE. ELYRIA, OH

SURVEYED BY: N/A
CLOSURE: N/A
MAP PAGE(S): 3-00-046
APPOVED BY: RRM **DATE:** 7-15-20
SCALE: 1" = 50 **PRIOR INSTRUMENT:** 20130478380