PARENT PARCEL: 04-00-030-113-033, -034, -035

CHILD PARCEL: 04-00-030-113-038

STARTING POINT: MONUMENT BOX AT THE INTERSECTION OF HIGHLAND AVE & ELECTRIC BLVD

21-04369

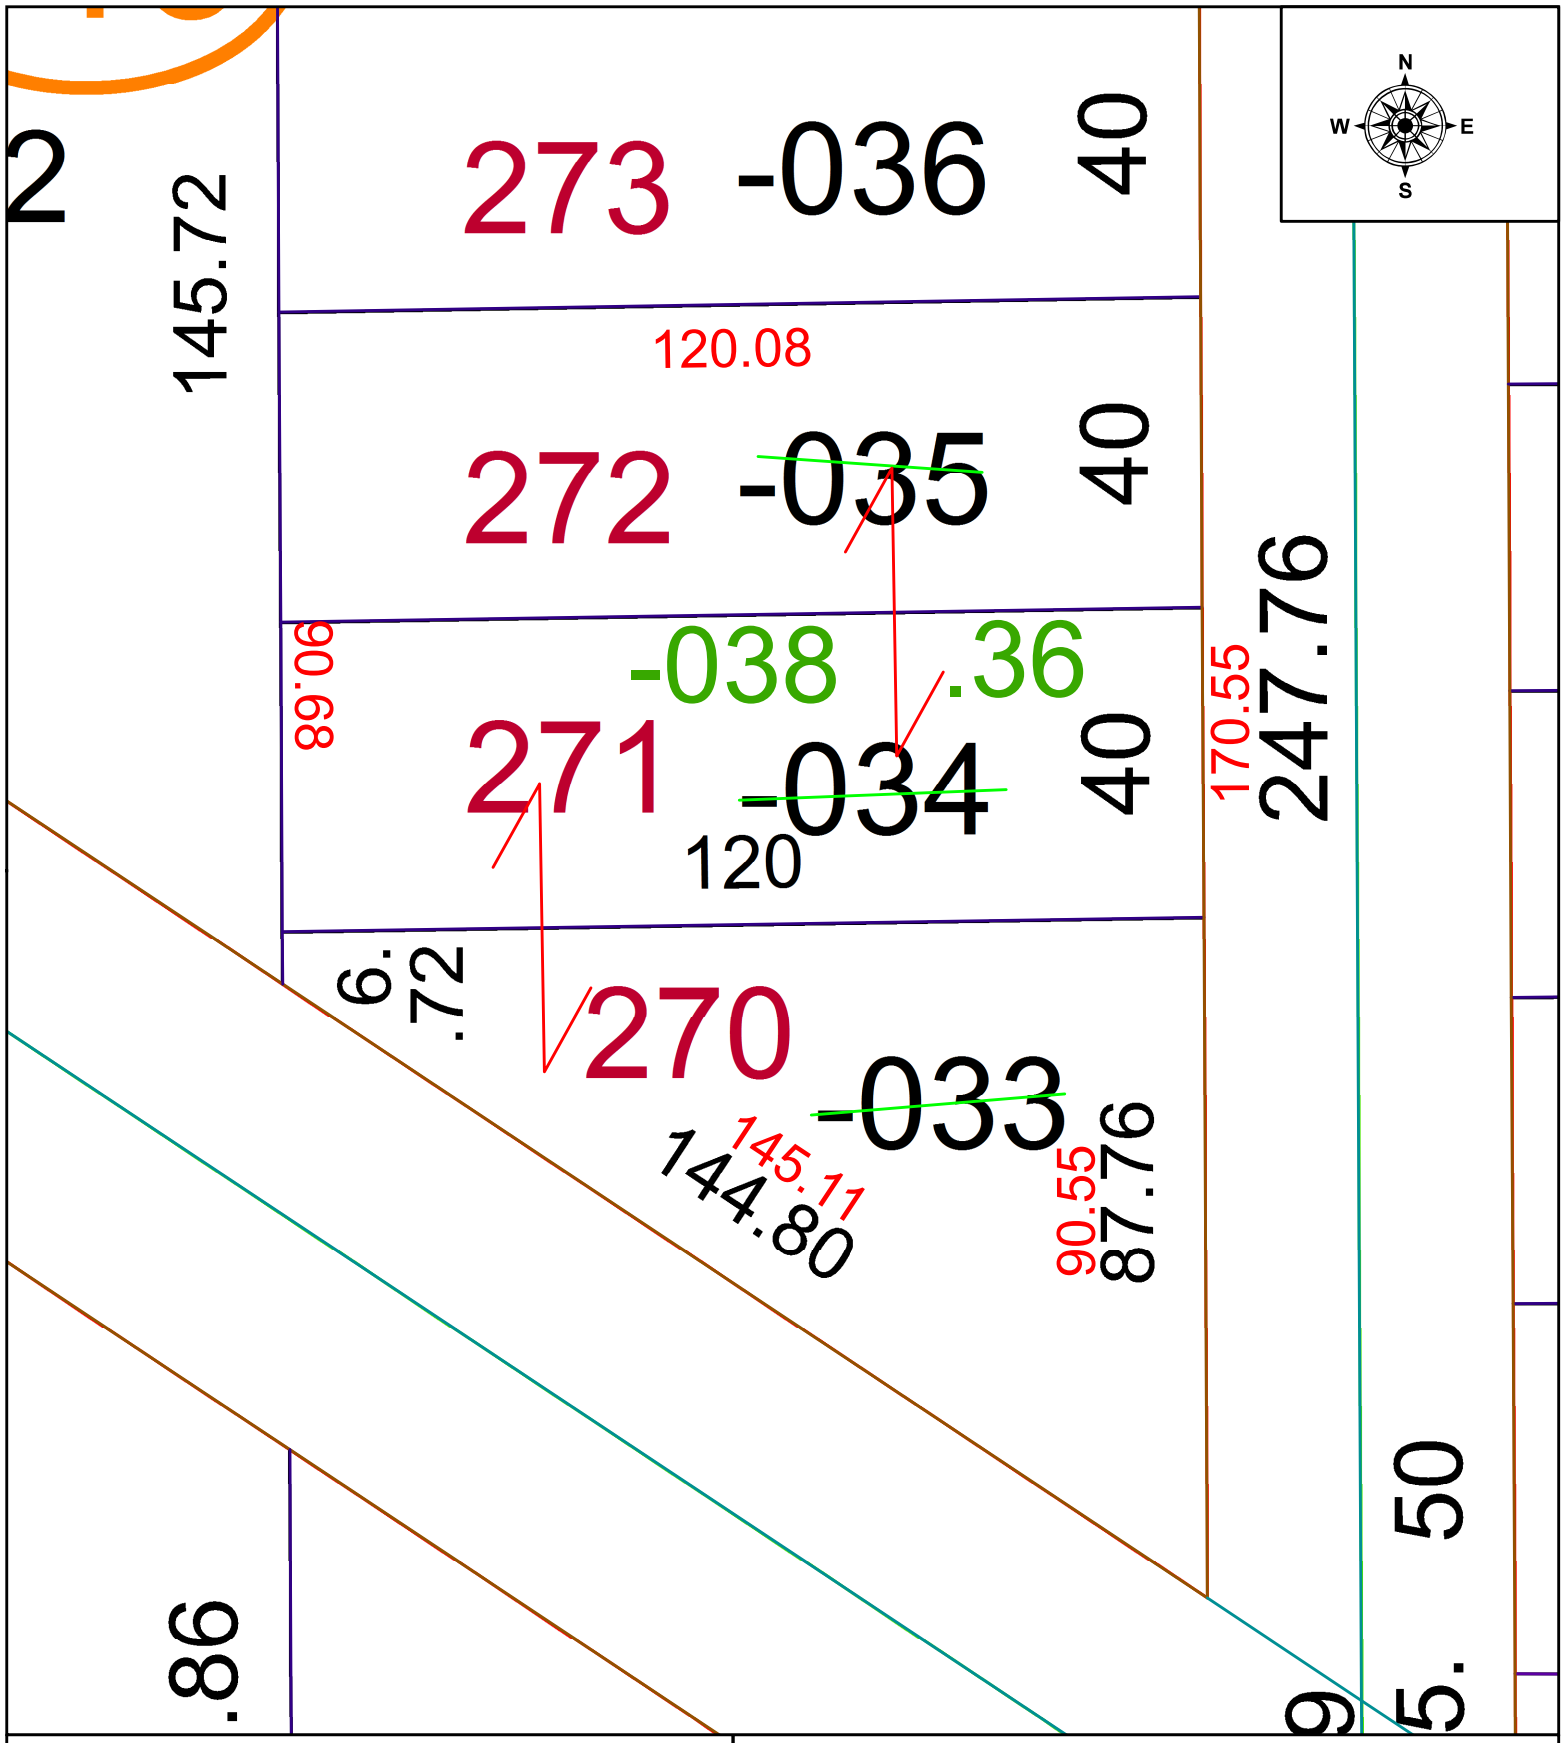

SPLITS/DEEDS PROCESSED

LORAIN COUNTY TAX MAP DEPARTMENT
226 MIDDLE AVE. ELYRIA, OH

SURVEYED BY: AMY KELLY
CLOSURE: 1: 52,046
MAP PAGE(S): 04-00-030
APPOVED BY: WRZ **DATE:** 9/10/2021
SCALE: 1" = 25 **PRIOR INSTRUMENT:** 2020-0773265