PARENT PARCEL: 07-00-012-101-044 & 045

CHILD PARCEL: 07-00-012-101-134 THRU -136

STARTING POINT: CL OF REED RD & ROOT RD.

21-04370

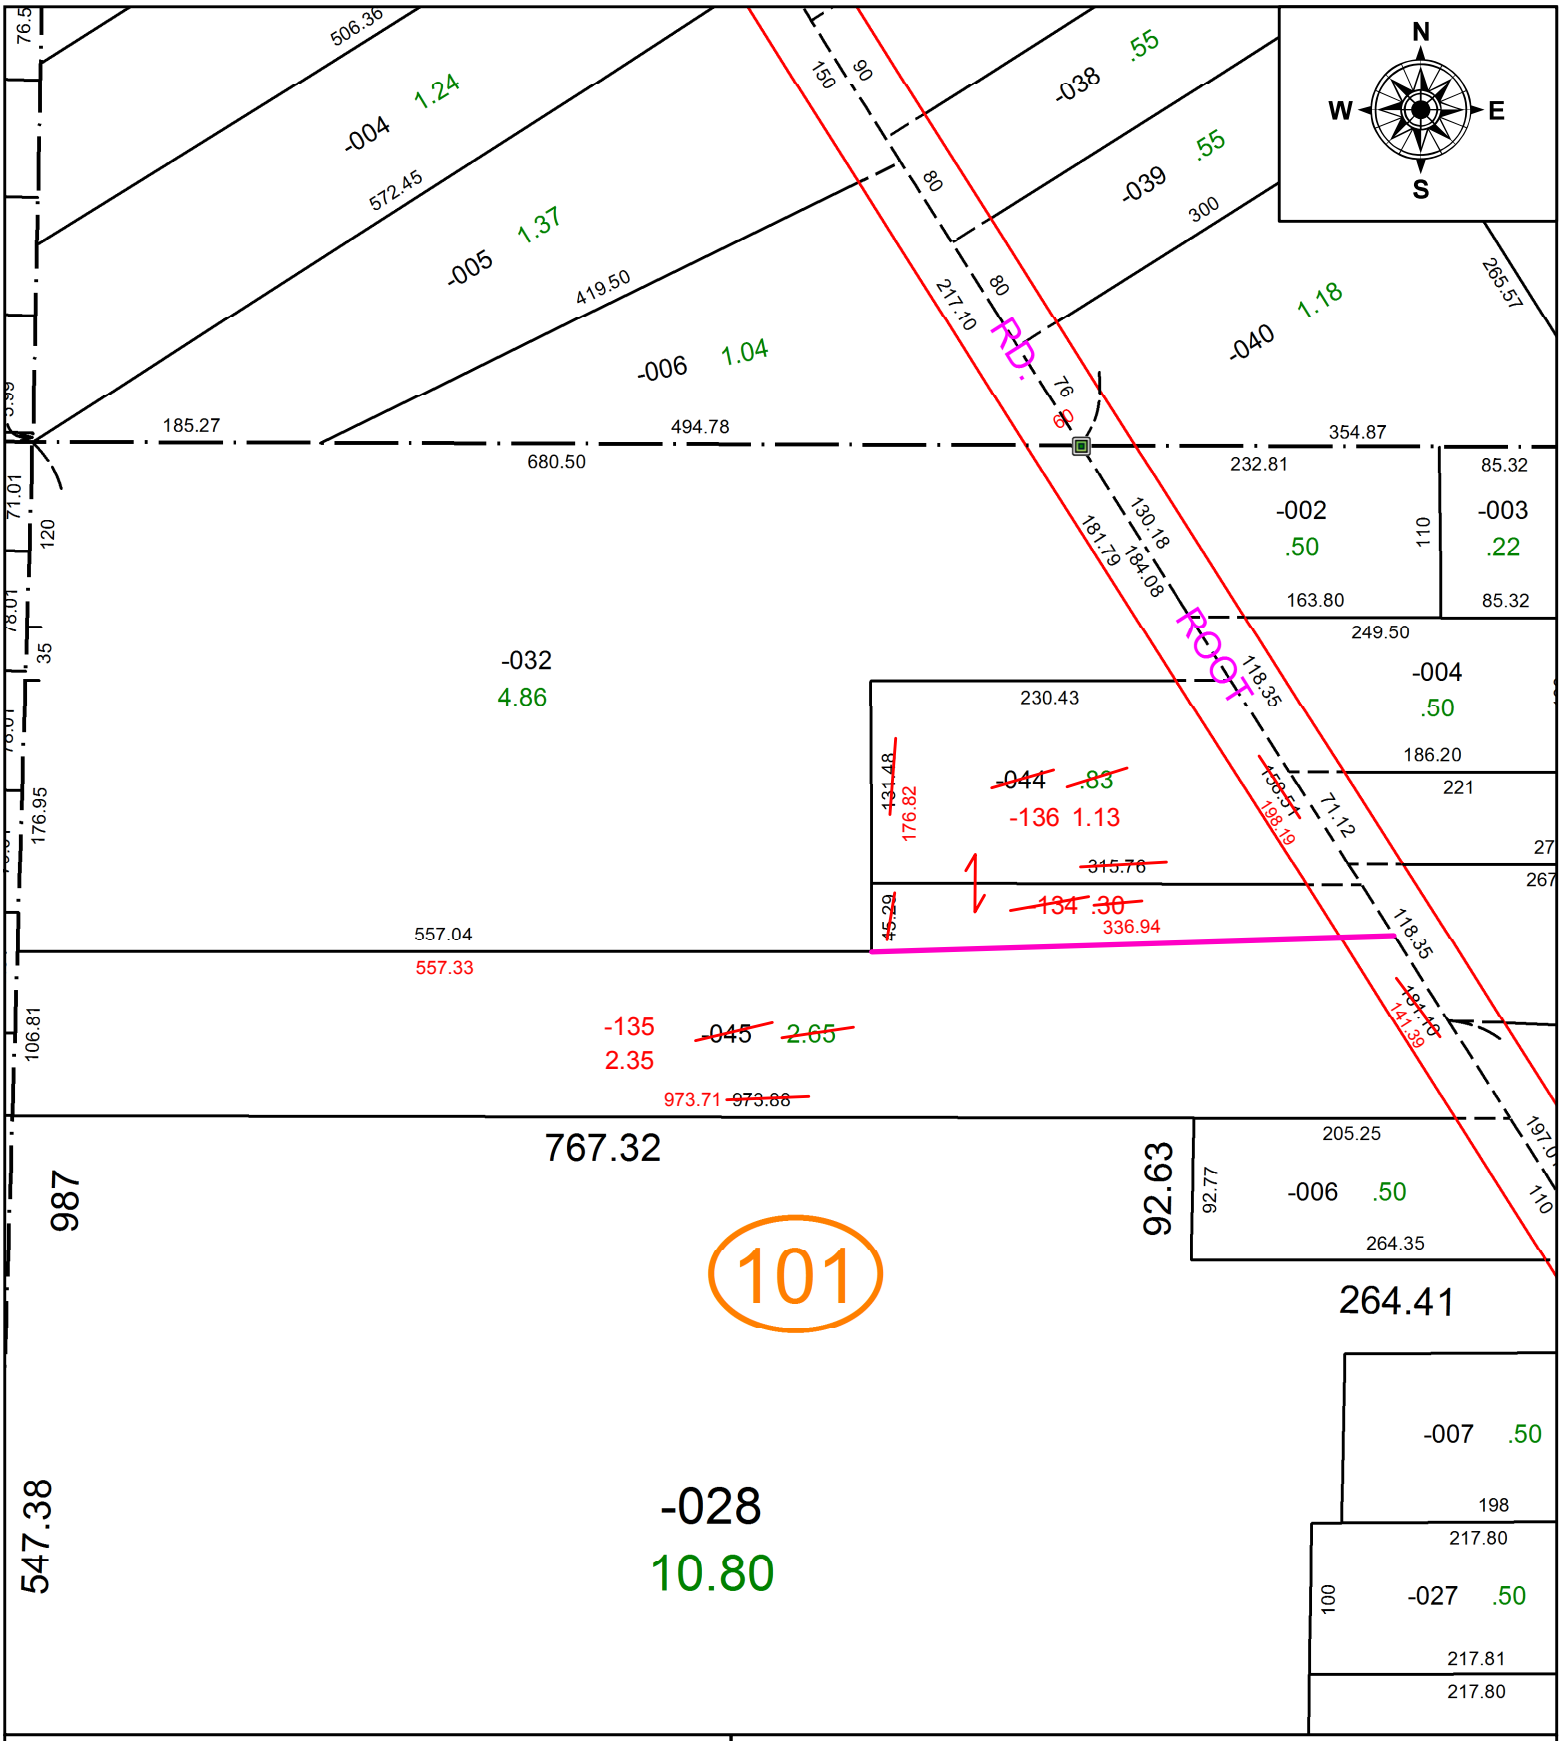

SPLITS/DEEDS PROCESSED

LORAIN COUNTY TAX MAP DEPARTMENT
226 MIDDLE AVE. ELYRIA, OH

SURVEYED BY: JAMES YURKSCHATT
CLOSURE: 1: 237,709
MAP PAGE(S): 07-00-012
APPOVED BY: DMA **DATE:** 9/10/2021
SCALE: 1" = 125' **PRIOR INSTRUMENT:** O.R. 837 PG. 663