PARENT PARCEL: 01-00-003-139-014 & -015

CHILD PARCEL: 01-00-003-139-070 thru -072

STARTING POINT: S.E. CORNER OF S/L 914 VERMILION ON THE LAKE # 2 P.V. 10 PG. 20

21-04371

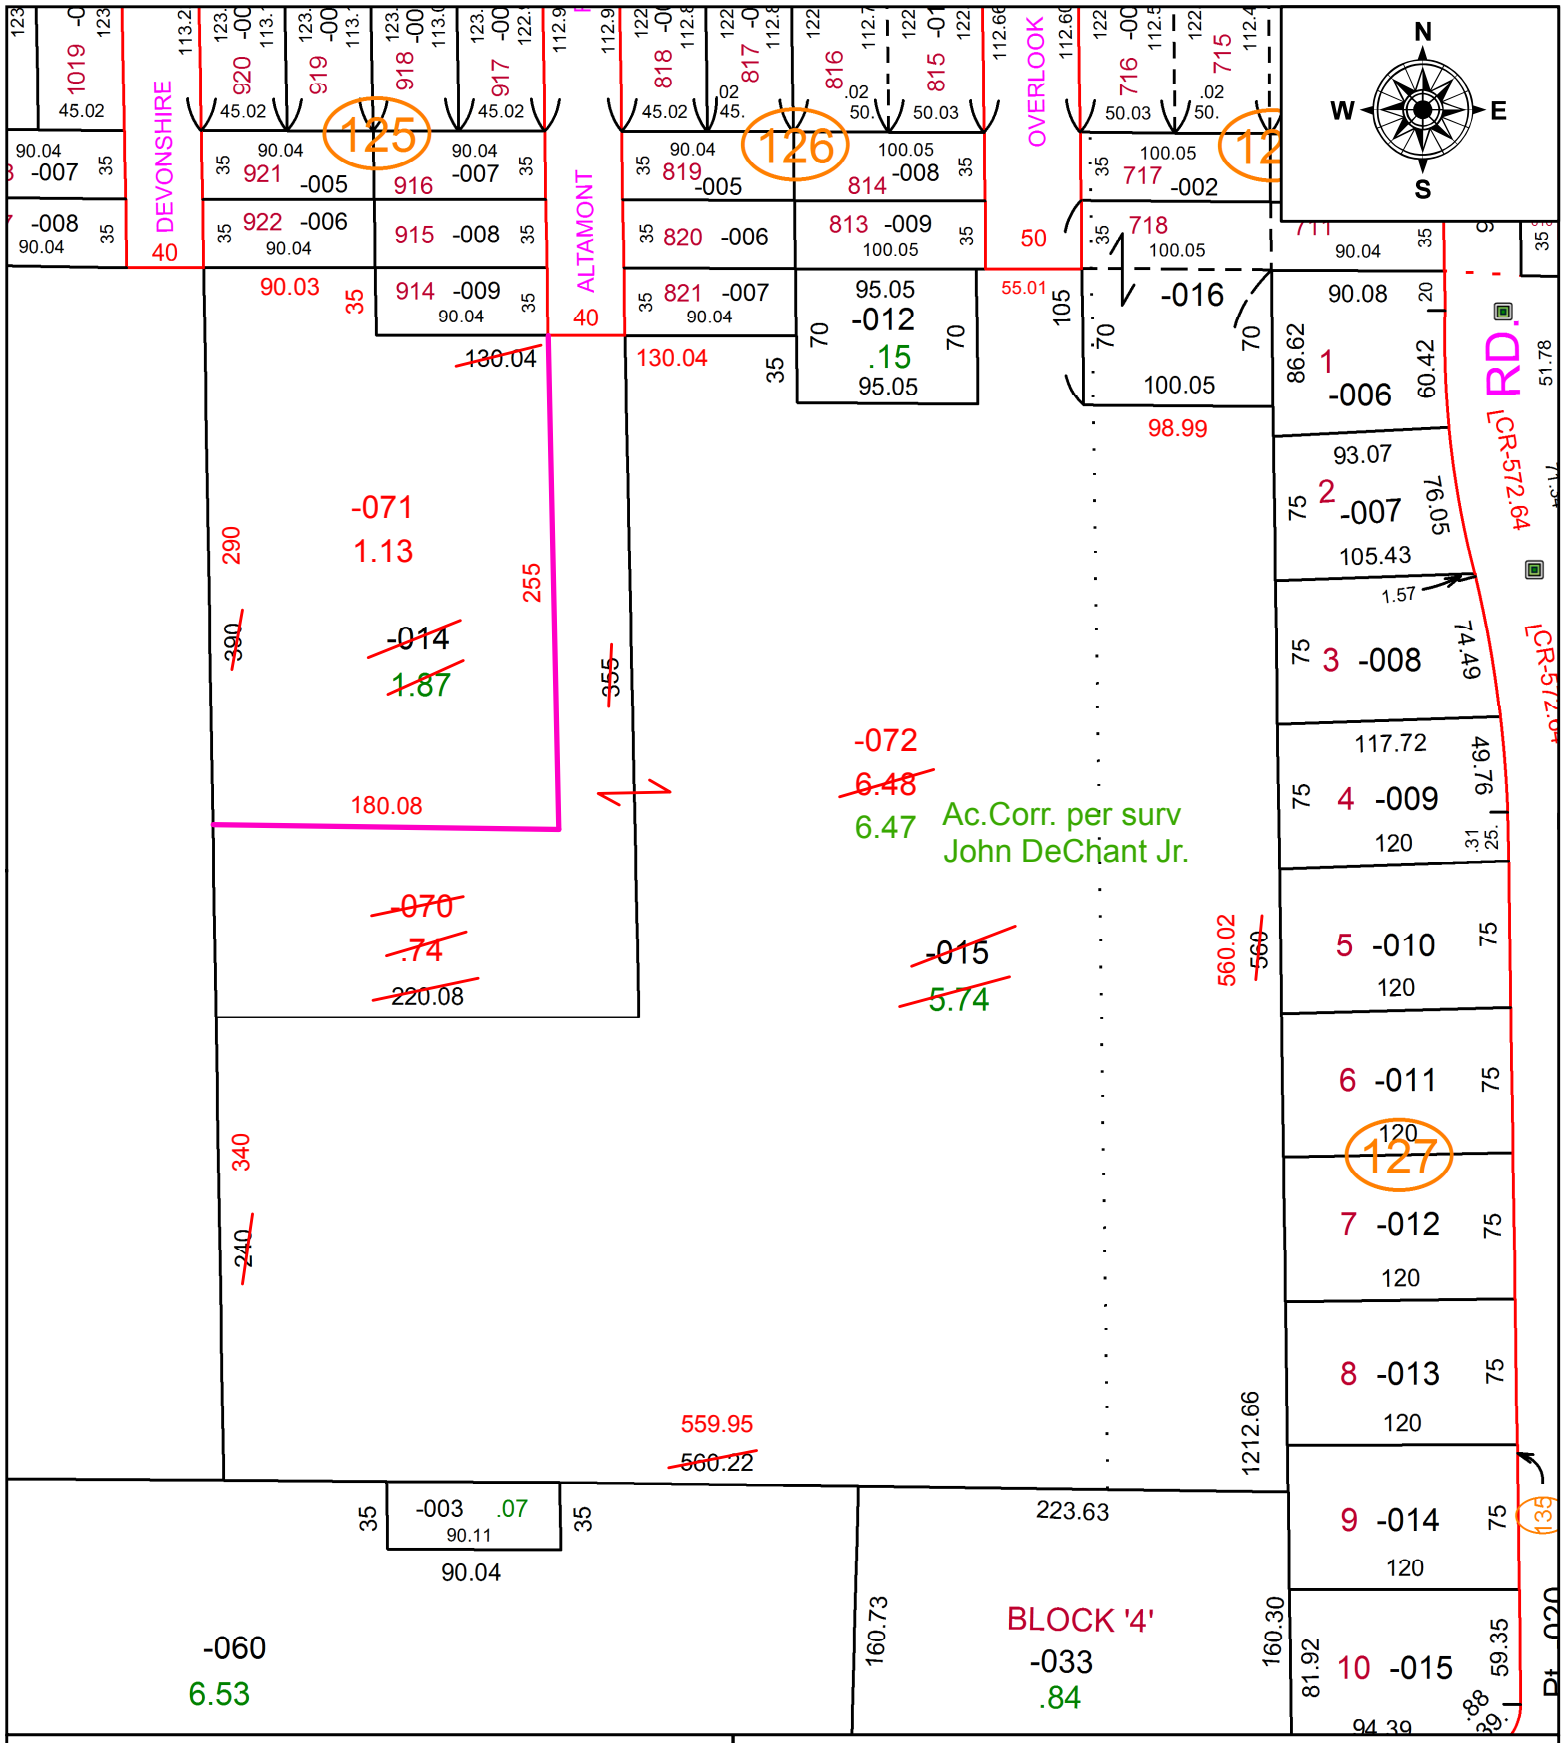

SPLITS/DEEDS PROCESSED

LORAIN COUNTY TAX MAP DEPARTMENT
226 MIDDLE AVE. ELYRIA, OH

SURVEYED BY: JOHN DECHANT JR.
CLOSURE: 1: 2147483648
MAP PAGE(S): 01-00-003
APPOVED BY: DMA **DATE:** 9/13/2021
SCALE: 1" = 100' **PRIOR INSTRUMENT:** 20180695663