PARENT PARCEL: 03-00-095-109-044, -045

CHILD PARCEL:

STARTING POINT: INTERSECTION OF EAST LINE OF SENCA AVE AND SOUTH LINE OF E. 29TH ST.

20-04374-C

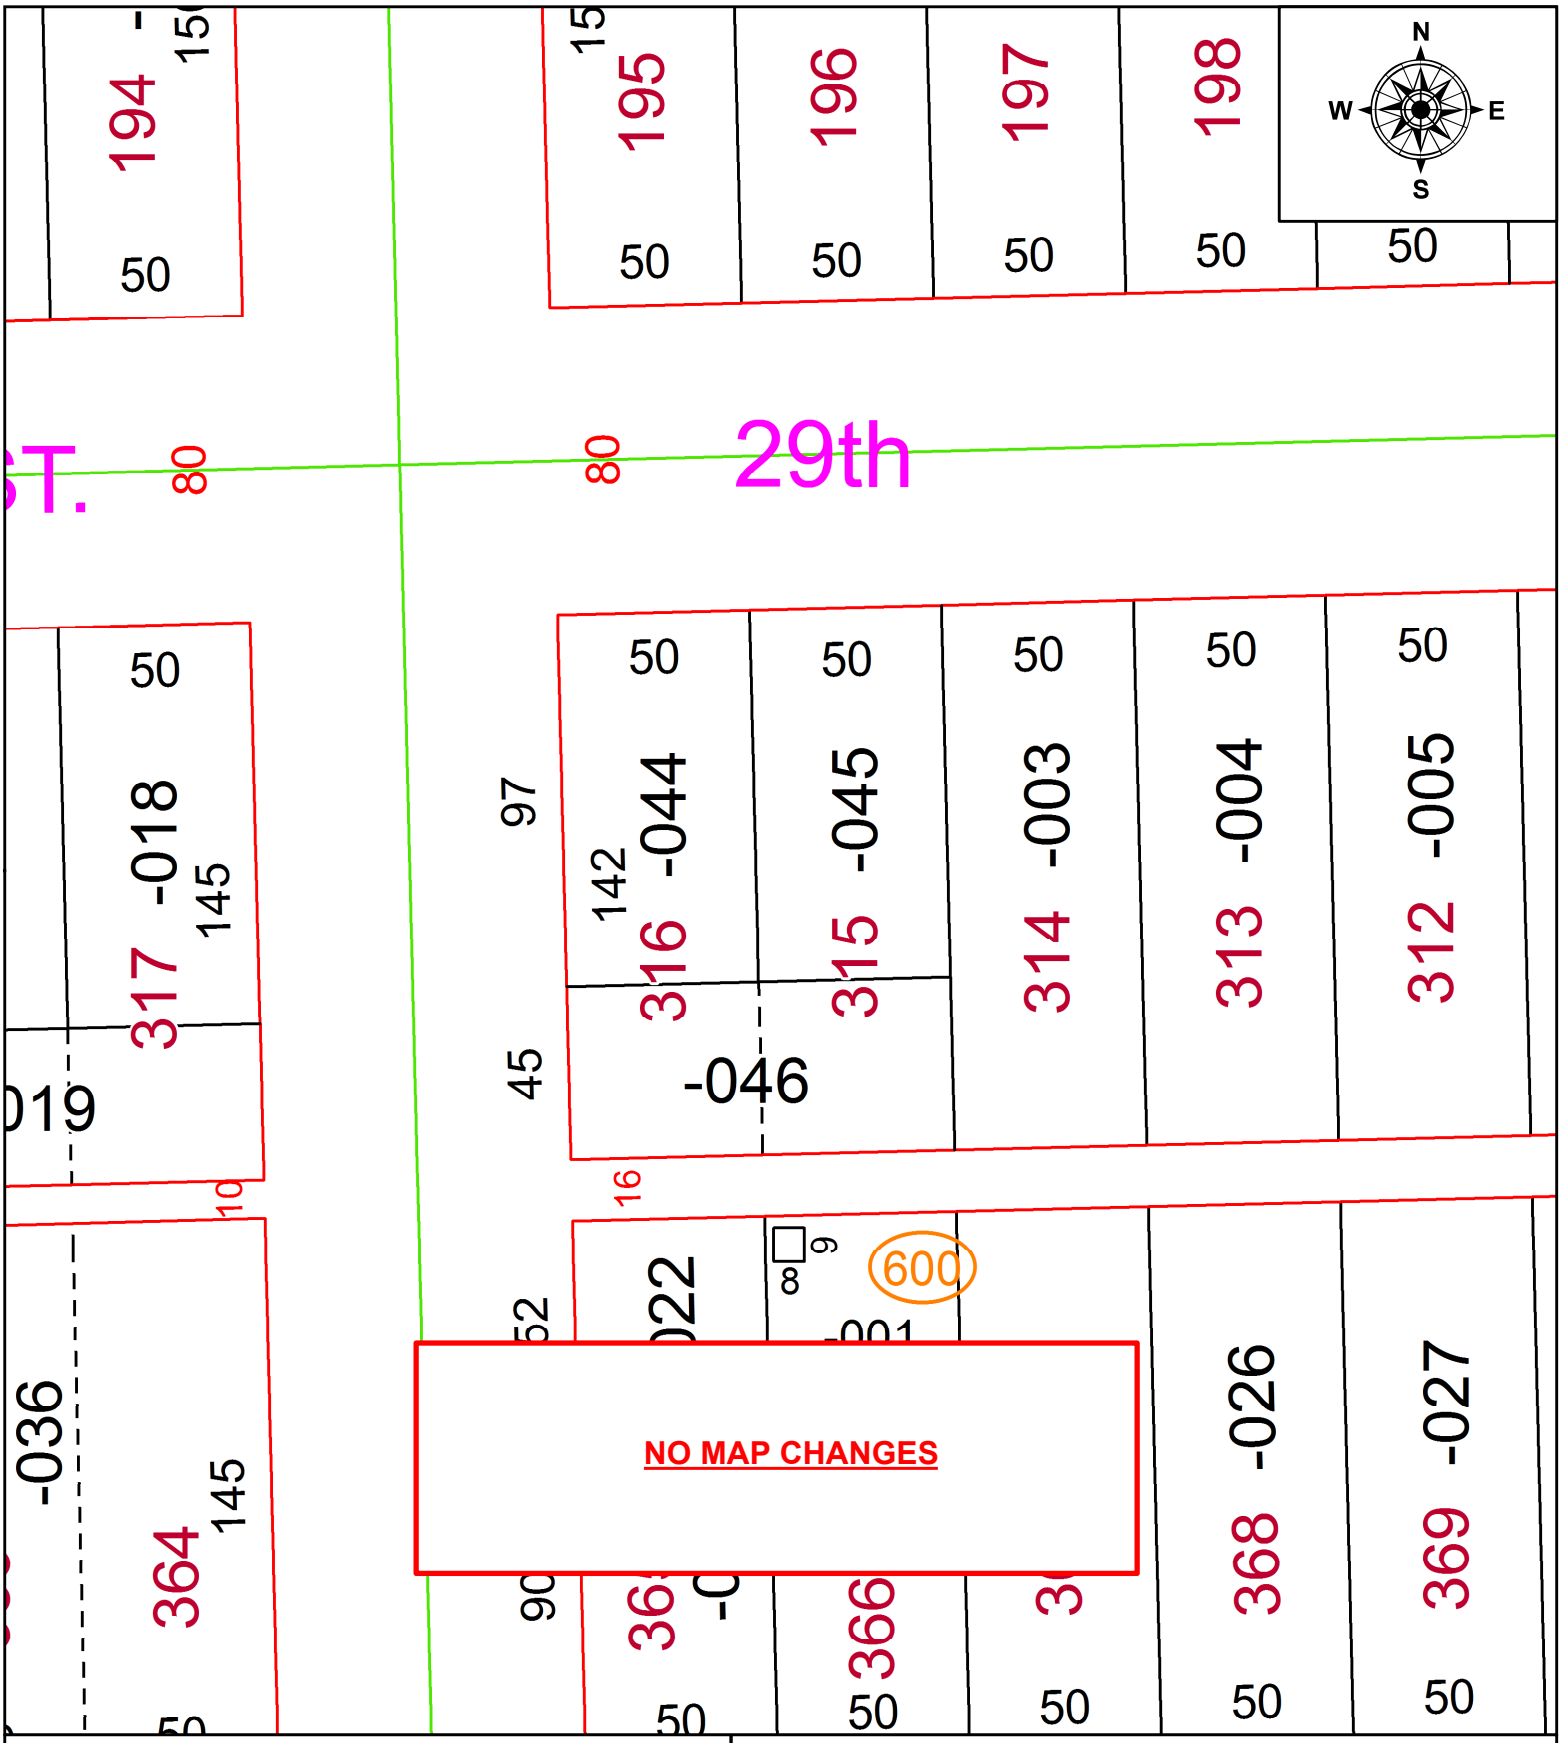

SPLITS/DEEDS PROCESSED

LORAIN COUNTY TAX MAP DEPARTMENT
226 MIDDLE AVE. ELYRIA, OH

SURVEYED BY: PATRICK A. MCGANNON
CLOSURE: 1: 2147483648
MAP PAGE(S): 3-00-095
APPOVED BY: RRM **DATE:** 7-29-20
SCALE: 1" = 50 **PRIOR INSTRUMENT:** 20190720981